


REGISTERED PROFESSIONAL LAND SURVEYOR
LAKE GENEVA, WISCONSIN

LOT 3 OF BLOCK 1 OF LAKE BEULAH, A
SUBDIVISION LOCATED IN SECTION 12,
T4N, R18E, WALWORTH COUNTY, WISCONSIN.

OWNERS: RAYMOND J. VANDECASTLE &
BERNICE R. VANDECASTLE

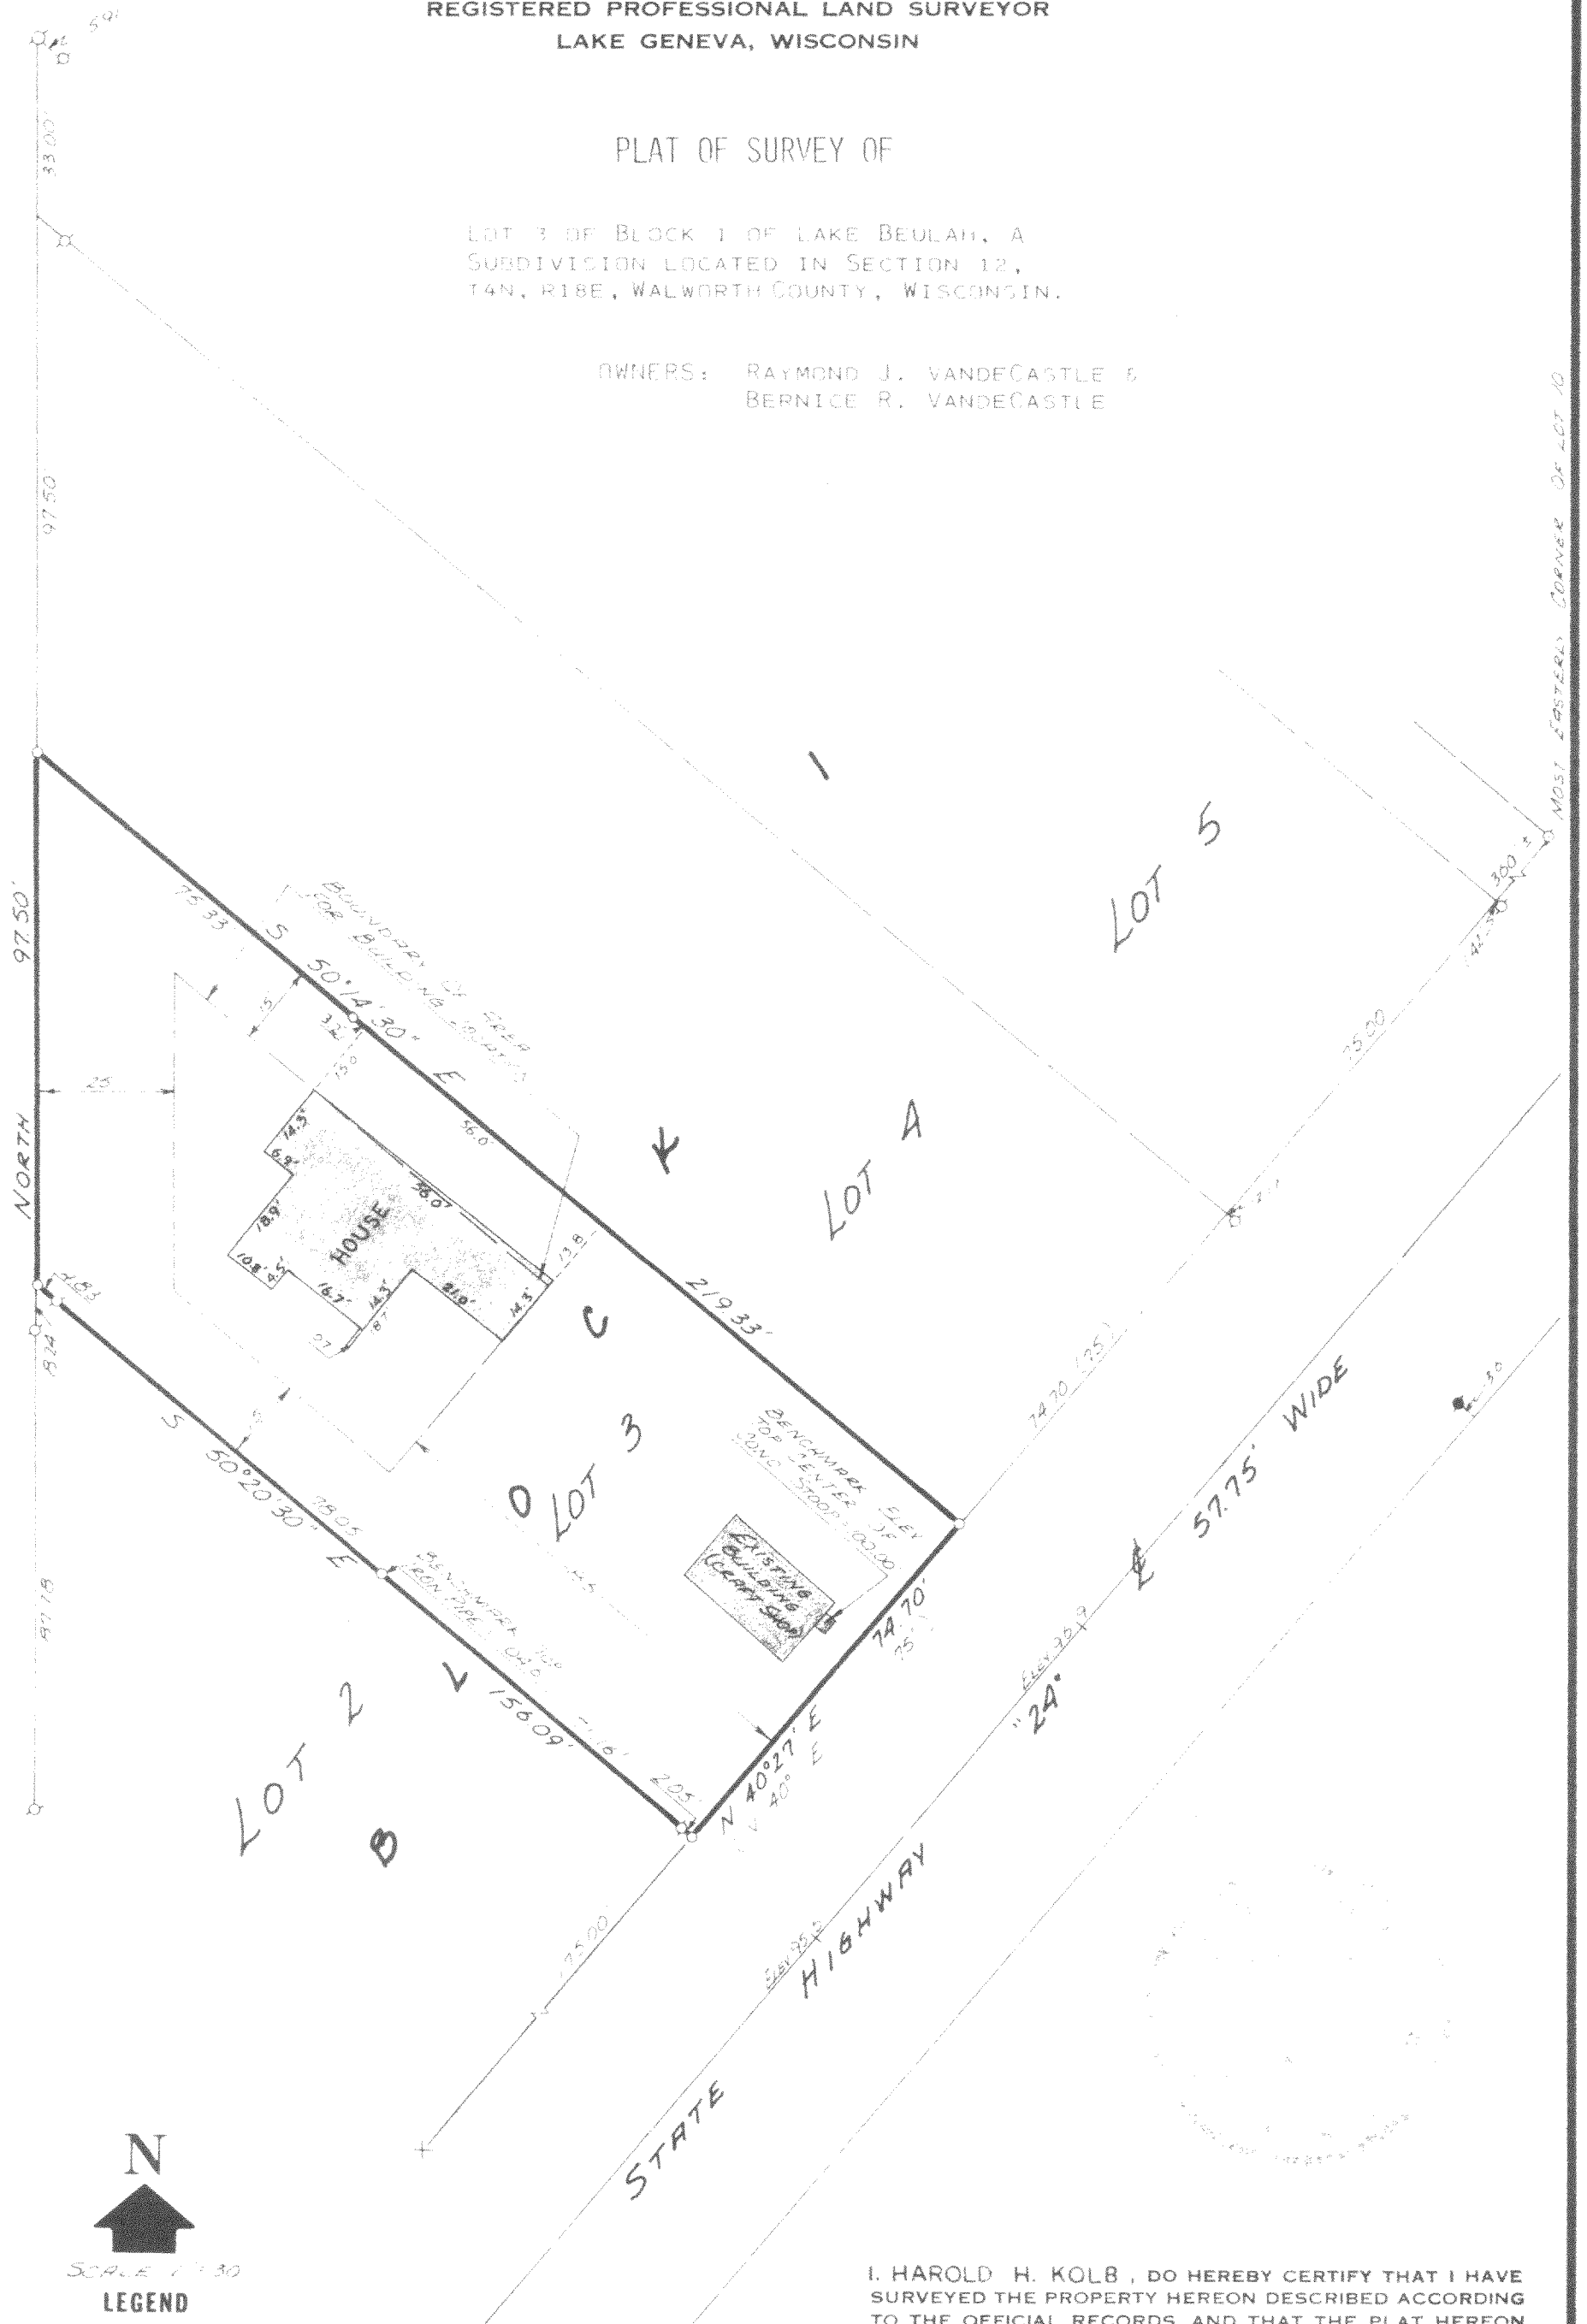

φ — IRON PIPE FOUND
 O — IRON PIPE PLACED
 ■ — IRON ROD FOUND
 X — CUT-CROSS FOUND

() - PLATTED AS

I, HAROLD H. KOLB, DO HEREBY CERTIFY THAT I HAVE SURVEYED THE PROPERTY HEREON DESCRIBED ACCORDING TO THE OFFICIAL RECORDS, AND THAT THE PLAT HEREON IS A CORRECT REPRESENTATION OF THE LOT LINES.

Harold H. Kolb
HAROLD H. KOLB
WISCONSIN REGISTERED LAND SURVEYOR, S-187
DATE July 12, 1977

Revised: 9 Aug. 1977
Revised: 14 March 1978

418-372