

FARRIS, HANSEN & COOPER, INC.

ENGINEERING, SURVEYING AND LAND PLANNING

715 W. WALWORTH ST. - P.O. Box 487 - ELKHORN, WI 53121

OFFICE: 414/723-2098

WARREN E. HANSEN
PROFESSIONAL ENGINEER


ENGINEERING
MUNICIPAL - STRUCTURAL
HIGHWAYS - PUBLIC WORKS

DANIEL D. COOPER
ROBERT A. FARRIS
LAND SURVEYOR

SURVEYING & PLANNING
SUBDIVISIONS - LOT SURVEYS
CONSTRUCTION STAKING - MAPPING

MORTGAGE INSPECTION SURVEY

POTTERS
LAKE

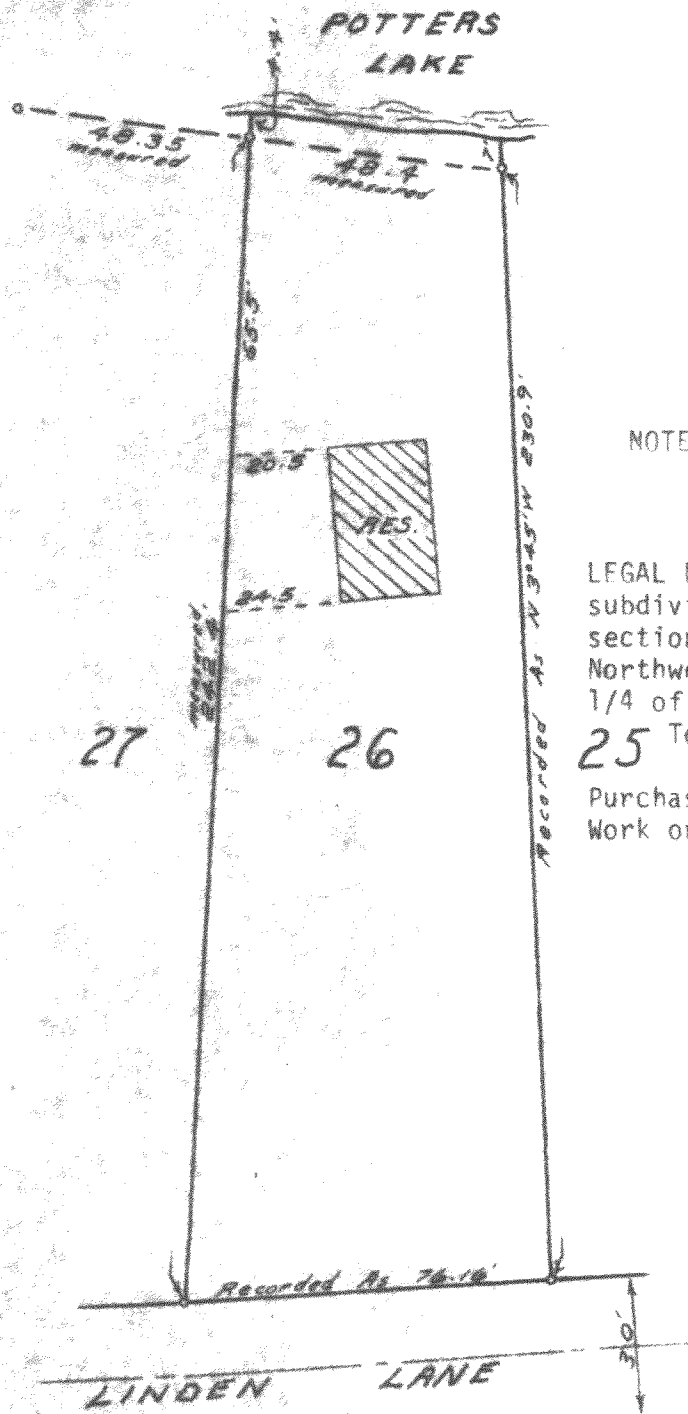


LOT 26 OF SHOREWOOD SUBDIVISION 4N, 18E

SCALE 1" = 40'

NOTE: THIS IS NOT A PROPERTY SURVEY AS
DEFINED IN SEC. AE-5.01 OF THE WIS-
CONSIN ADMINISTRATIVE CODE

LEGAL DESCRIPTION: Lot 26 in Shorewood, being a
subdivision of part of the Southeast 1/4 of
section 10, the Southwest 1/4 of section 11, the
Northwest 1/4 of section 14, and the Northeast
1/4 of section 15, Town 4 North, Range 18 East,
25 Town of East Troy, Walworth County, Wis.

Purchaser: Gary A. Jeske
Work ordered by: Gail L. Albrecht for
Waukesha Savings & Loan

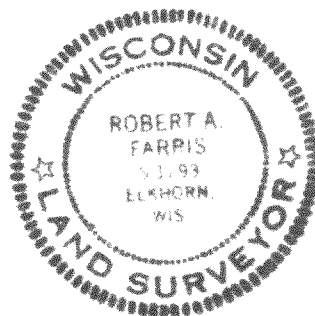

I HEREBY CERTIFY THAT THIS MAP IS A TRUE AND ACCURATE REPRESENTATION OF THE LOT LINES AND
THE BUILDING LOCATED THEREON TO THE BEST OF MY KNOWLEDGE AND BELIEF.

DATED THIS 1st DAY OF August, 1978

Robert A. Farris
Robert A. Farris RLS

Ps-26

DRAWING NO. 1370

418-373

418-373