


PLAT OF SURVEY

OF LOT 15, BLOCK 1 OF MAPAMAR SUBDIVISION, LOCATED IN THE EAST 1/2
OF SECTION 11, T4N, R15E, WALWORTH COUNTY, WIS.

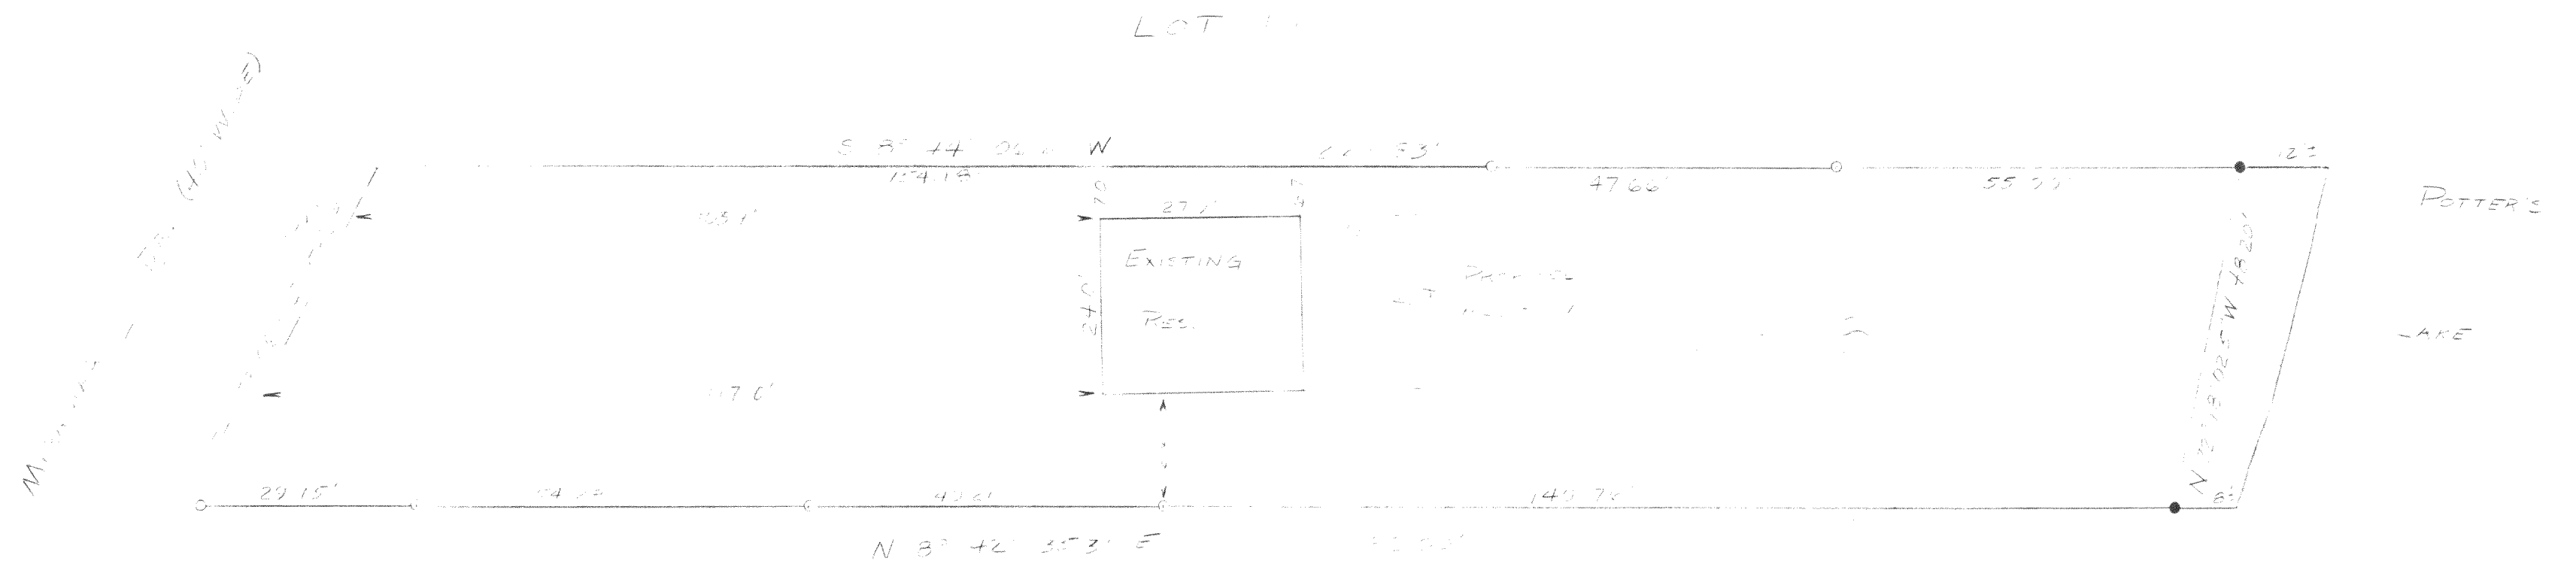

BEARINGS REFERENCED TO THE EAST LINE OF LOT 15
AS SHOWN S 89° 44' 06" W

LEGEND

- - IRON PIN
- - IRON ROD

Surveyors Certificate

I, WILLIAM A. SHEARMAN, a duly licensed Professional Engineer and Surveyor in the State of Wisconsin, do hereby certify that the foregoing is a true and correct copy of the original survey as shown to me and a true representation thereof, and that the same is in accordance with the laws of the State of Wisconsin.

All divisions of said property have been surveyed and shown to the satisfaction of the Surveyor and the same are in accordance with the laws of the State of Wisconsin.

DATED THIS 1ST DAY OF JULY, 1979.

WILLIAM A. SHEARMAN, S.E.
Professional Engineer and Surveyor
PME-ISA

William A. Shearmen


JENSEN & JOHNSON

ENGINEERS AND SURVEYORS

PO BOX 290, ELKHORN, WISCONSIN

414-723-3204

A Division of
Donohue & Associates, Inc.

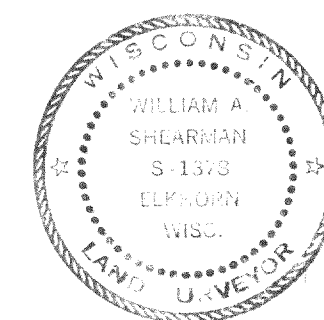

Date	7-31-79	Scale	1" = 20'
Drawn By	WJ	Surveyed For	THOMAS KUNDMANN
Checked By		Project No.	1658.326