



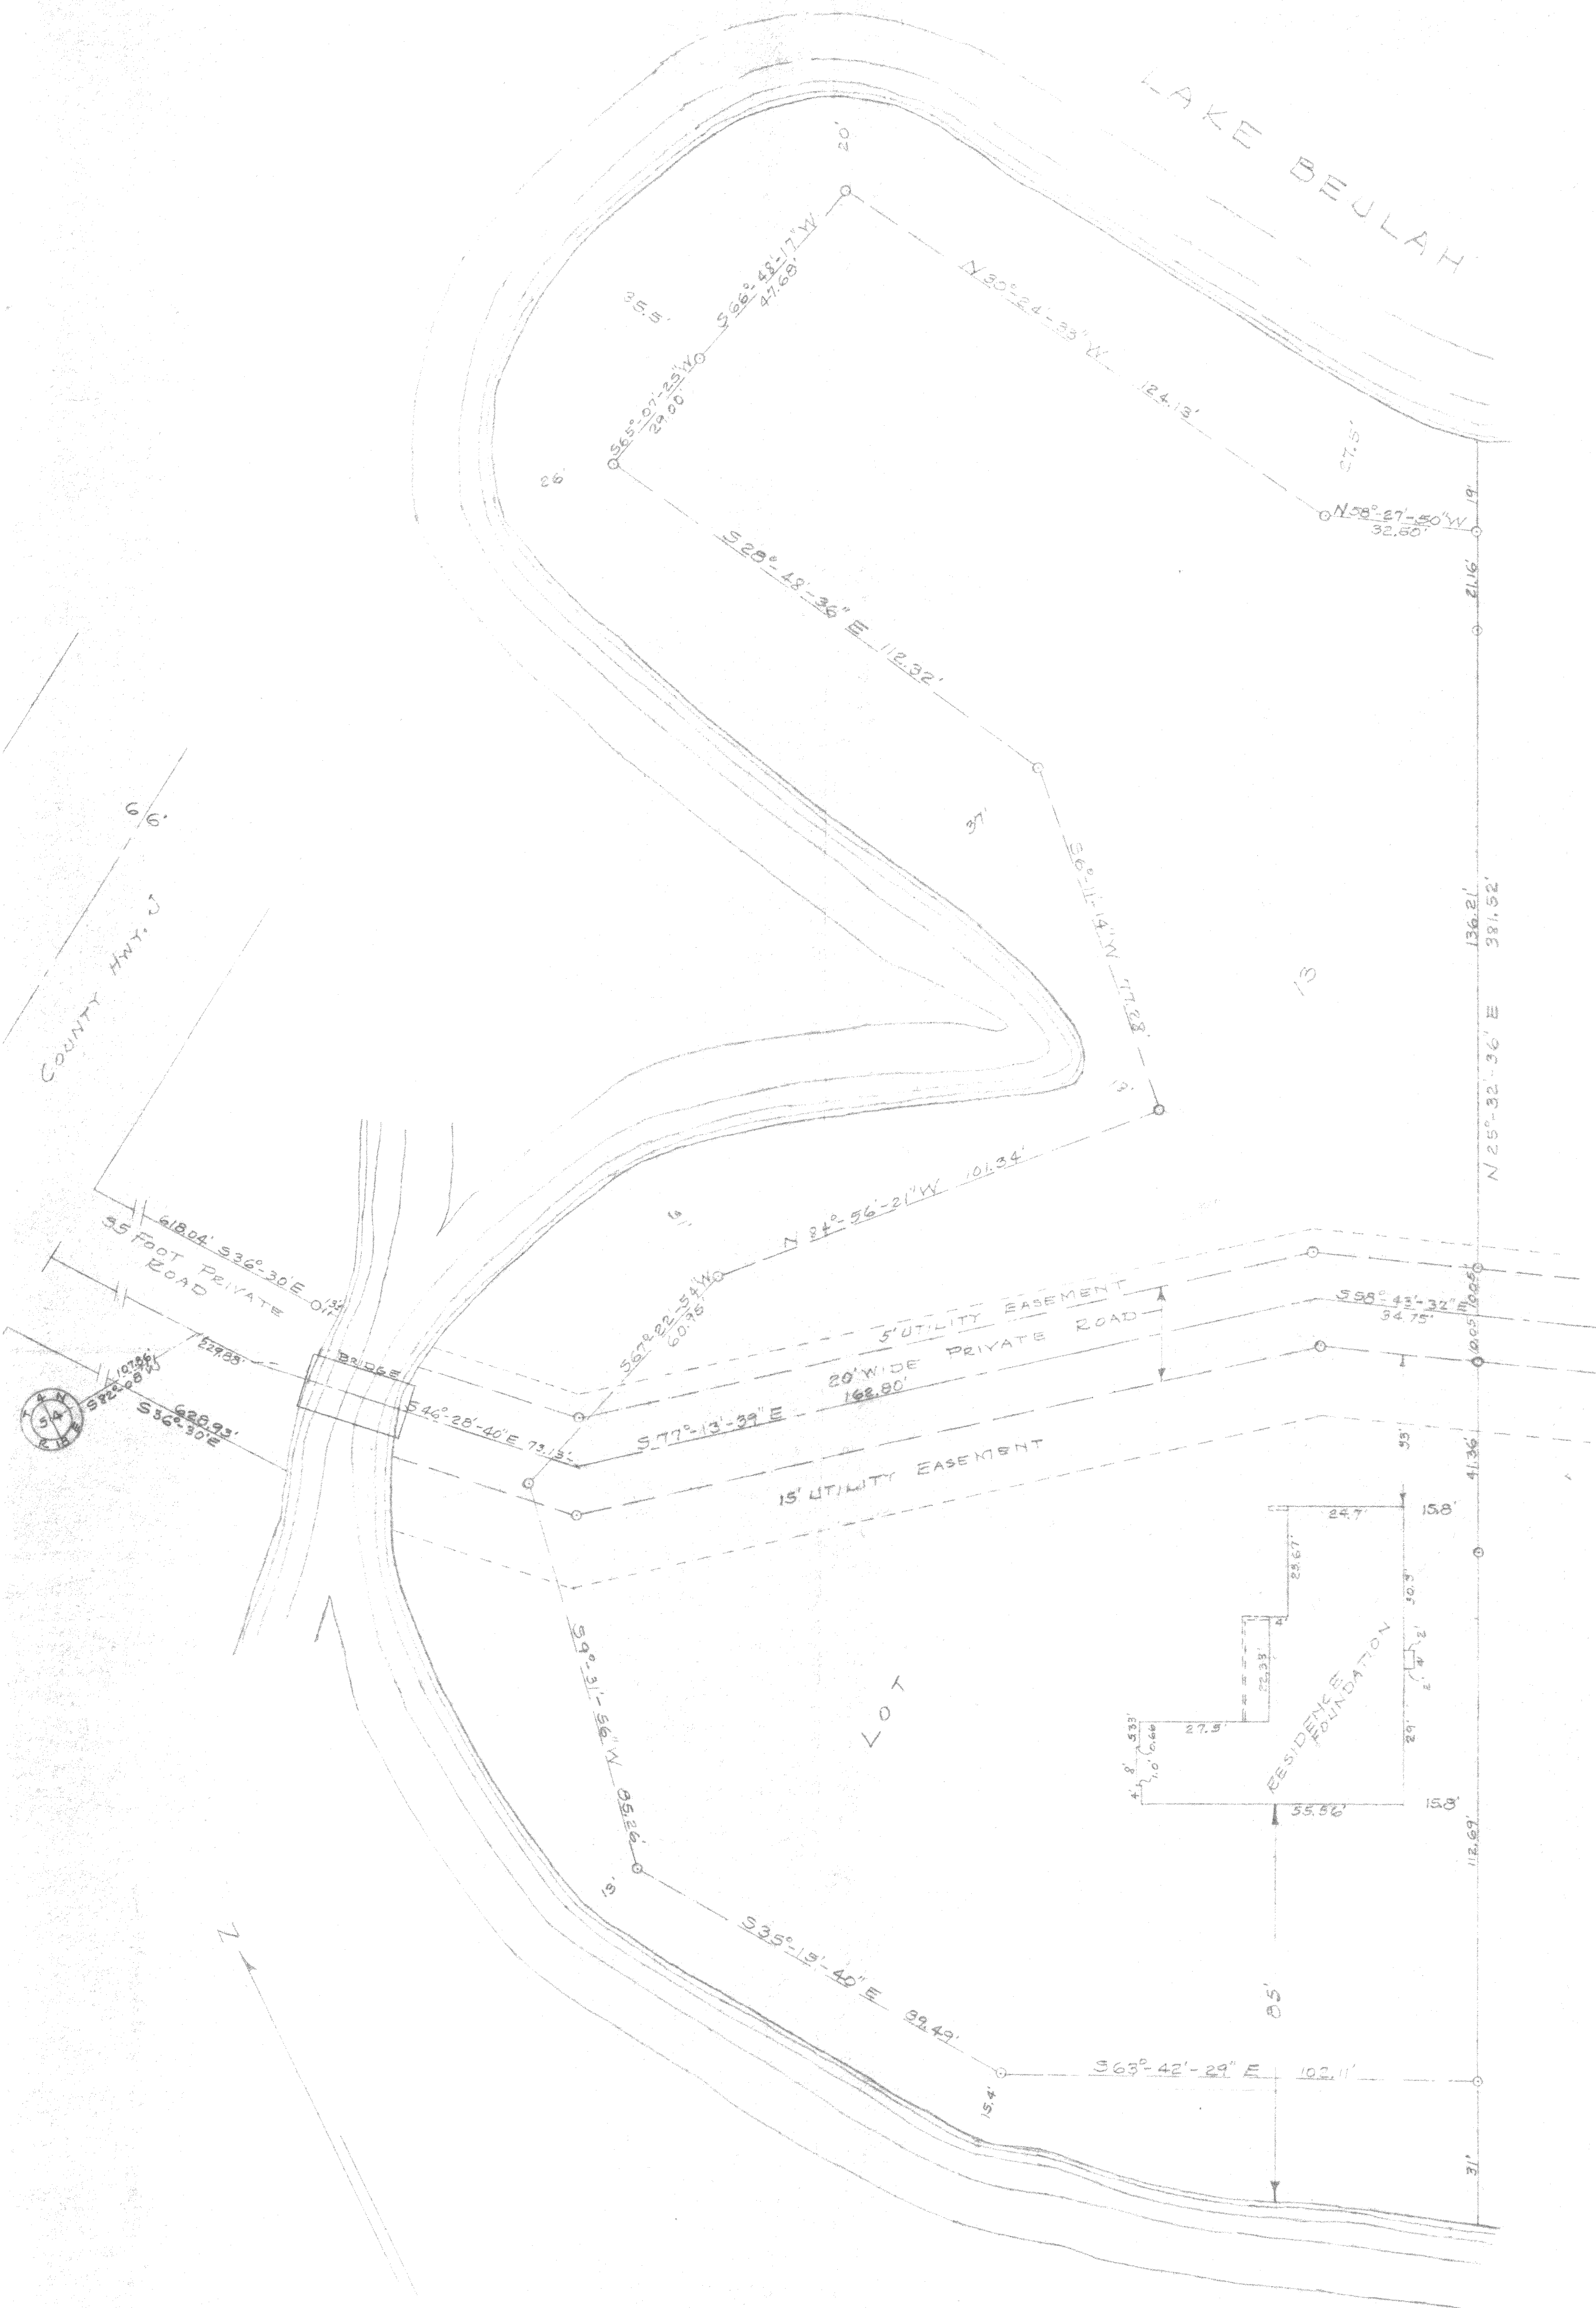

I, LLOYD L. JENSEN, SURVEYOR, HEREBY CERTIFY THAT THE SURVEYED LOT 13 OF THE "ISLAND CLUB" AND THAT THE PLAT SHOWN HEREON IS A CORRECT REPRESENTATION OF SAID SURVEY AND THAT ALL BUILDINGS UNDER CONSTRUCTION ARE SHOWN IN THEIR CORRECT LOCATION.

JULY 22, 1977

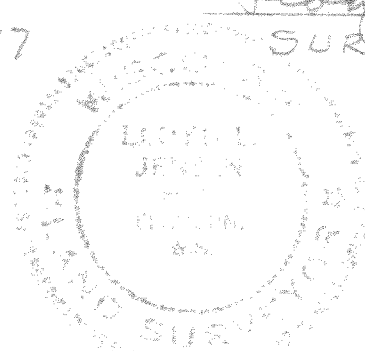


Lloyd L. Jensen
SURVEYOR

PLAT OF SURVEY OF LOT 13 OF THE "ISLAND CLUB" A SUBDIVISION LOCATED IN SECTION 4 OF EAST TROY TOWN, WALWORTH COUNTY, WISCONSIN.

JUNE 1977
REVISED AUGUST 1, 1977

Lloyd L. Jensen
SURVEYOR

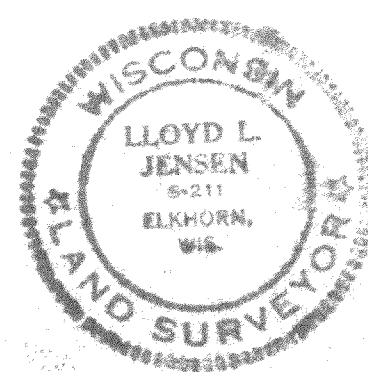

418-378J