
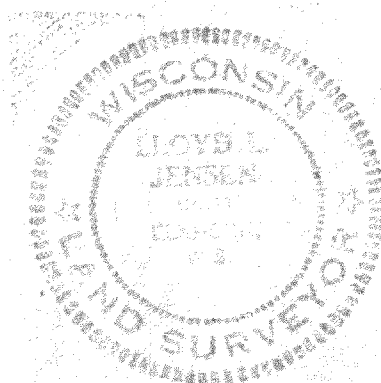


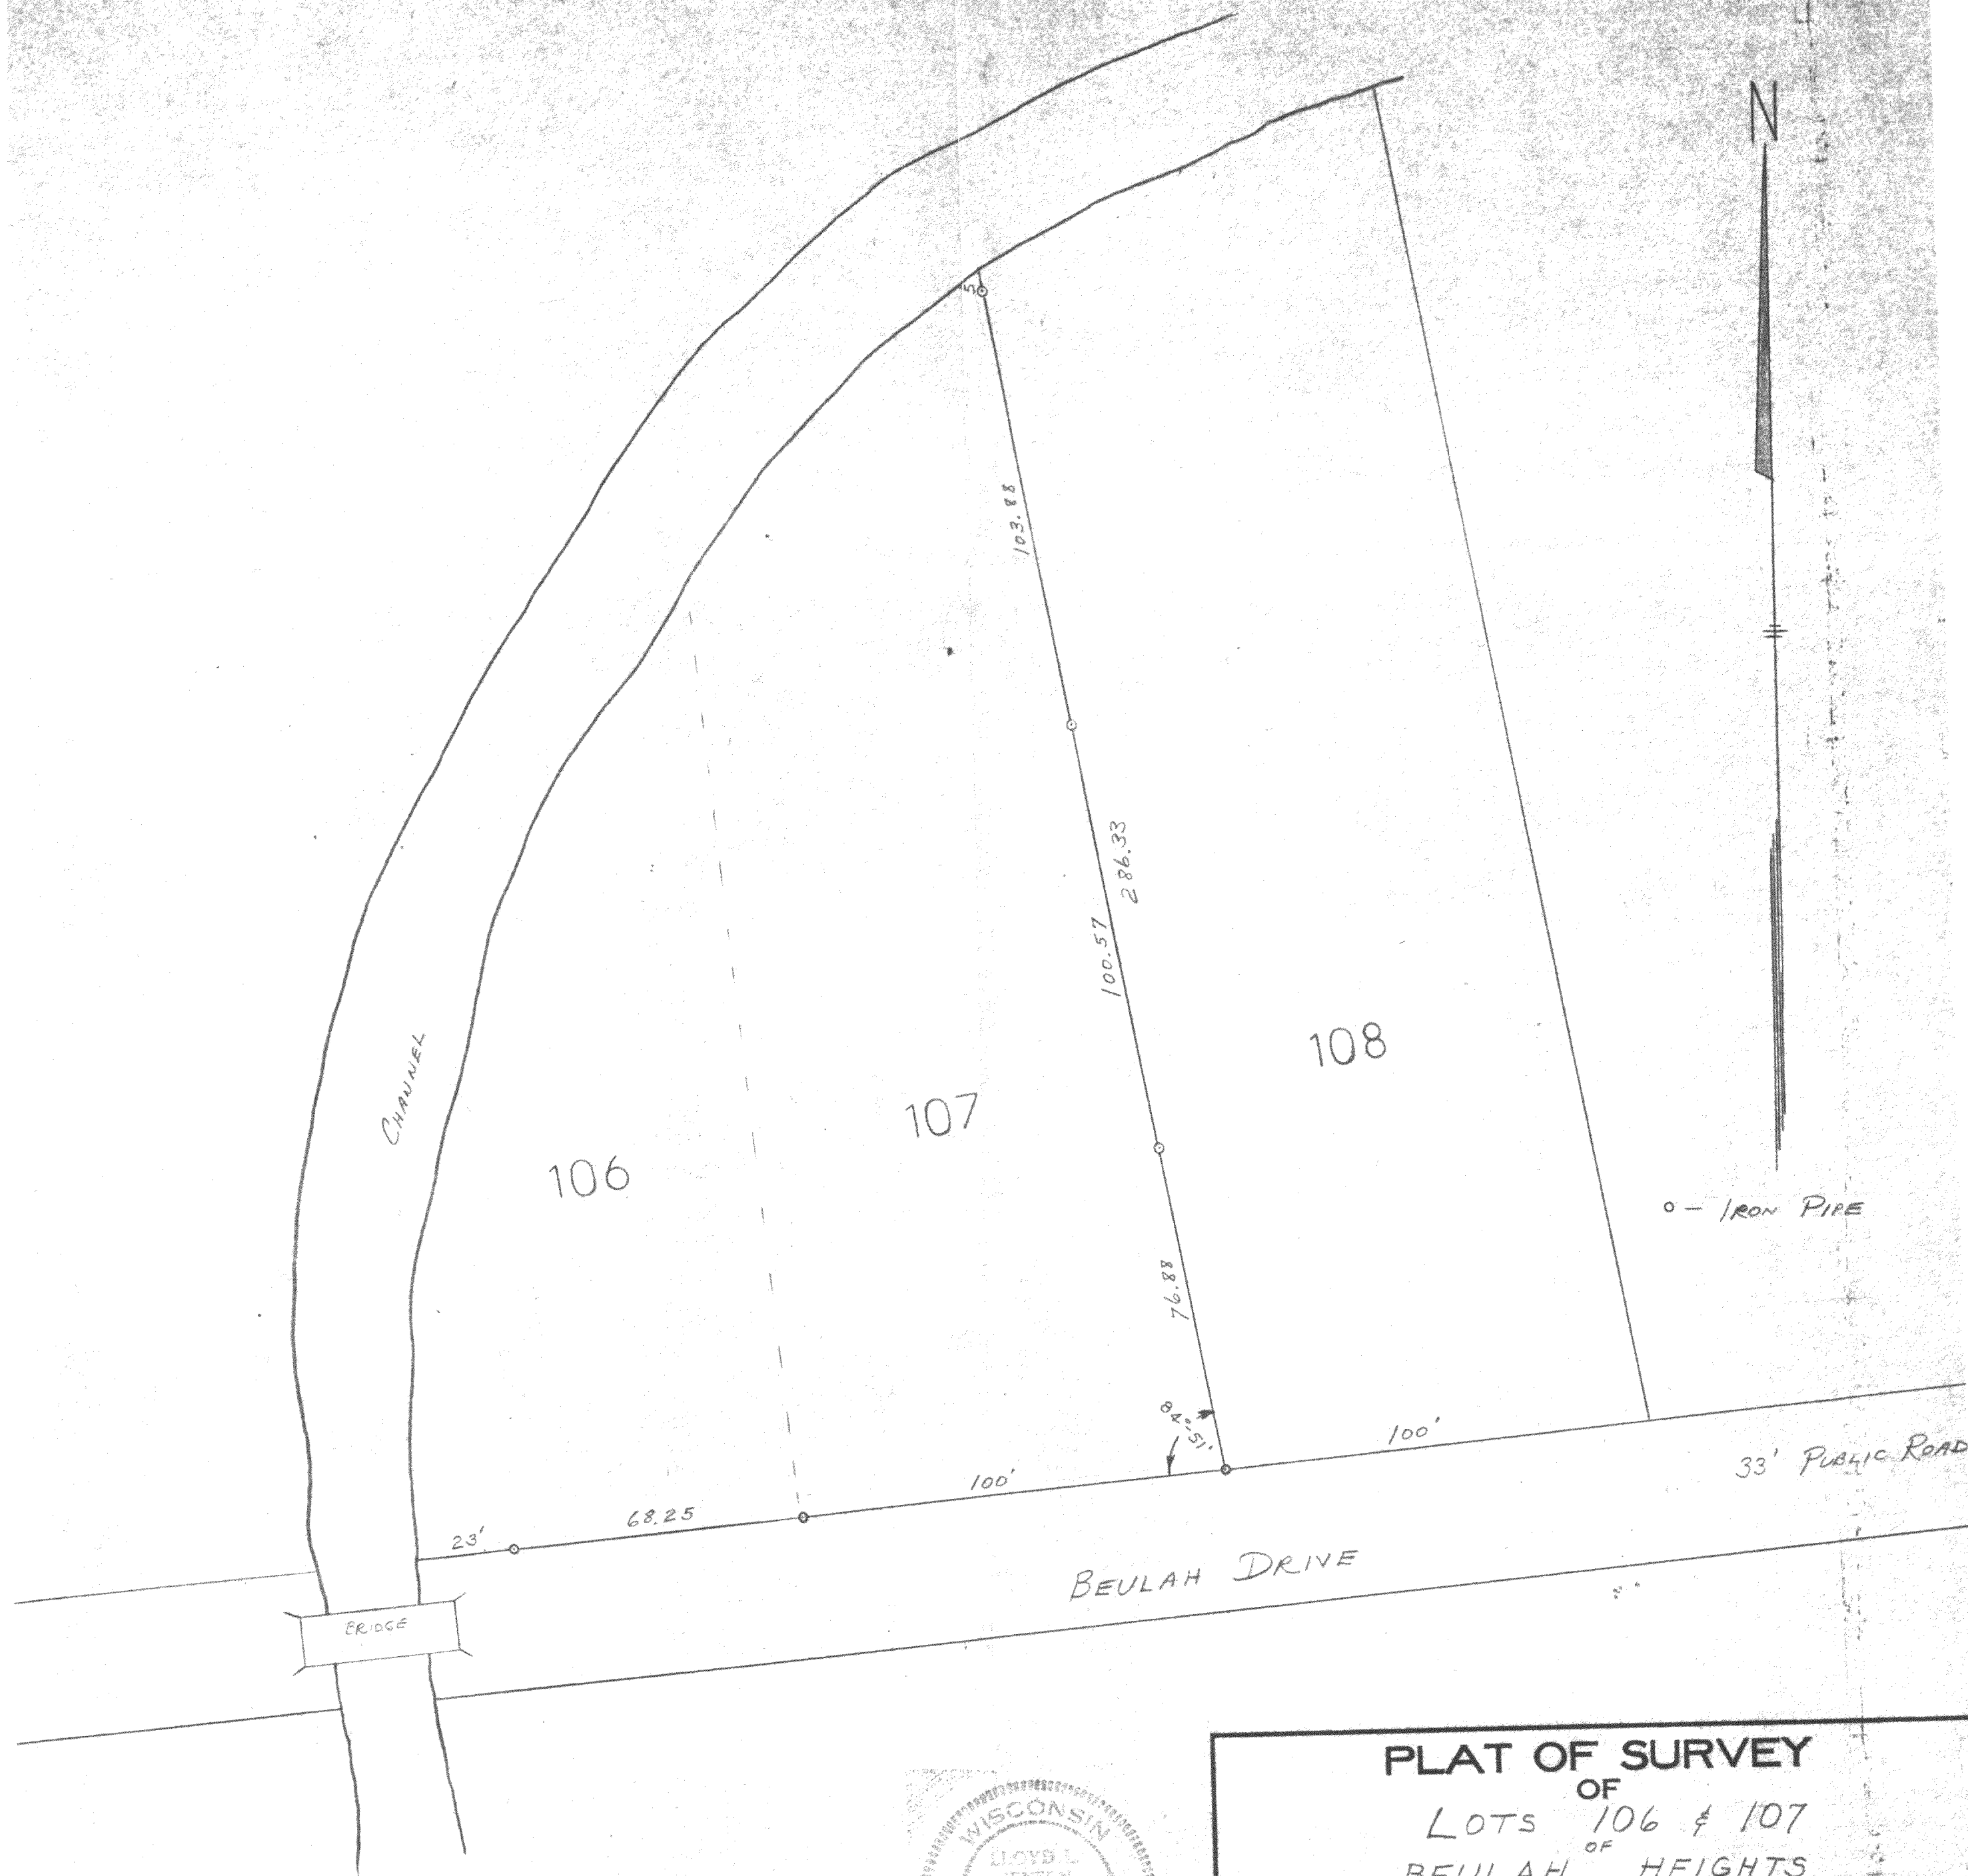

PLAT OF SURVEY

OF
LOTS 106 & 107
OF
BEULAH HEIGHTS
LOCATED IN T4N R18E
WALWORTH COUNTY, WISCONSIN

Lloyd L. Jensen
SURVEYOR

SCALE 1" = 30'

DATE JULY 1956