

HOME OFFICE
109 SOUTH SPRING STREET
BURLINGTON, WISCONSIN 53105
PHONE: 414-763-2652
414-763-7834

ROBERS & BOYD, INC.
CONSULTING ENGINEERS
LAND SURVEYORS


BRANCH OFFICE
809 - 43RD STREET
KENOSHA, WISCONSIN 53140
PHONE: 414-658-4488

MORTGAGE INSPECTION
FOR
UNIVERSAL MORTGAGE CORPORATION
OF

Lot 11, Block 6, Miramar Subdivision on Potter Lake, located in Section 10 and 11, Town 4 North, Range 18 East, Town of East Troy, Walworth County, Wisconsin.

Address: 1114 Miramar Drive

It is understood that Universal Mortgage Corporation has waived the placement of survey monuments for this survey under Chapter A-E 5.01 (b) of the Wisconsin Administrative Code.

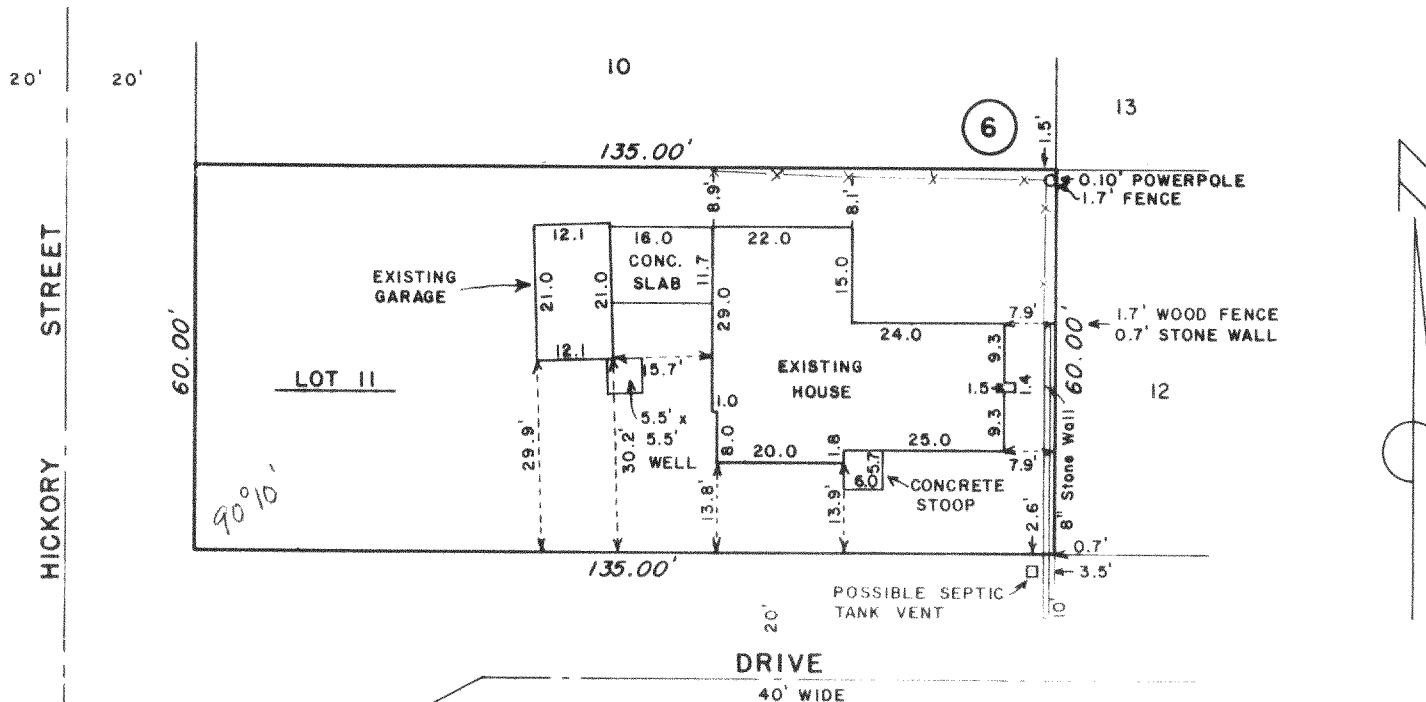

"I have surveyed the above-described property, and the above map is a true representation thereof and shows the size and location of the property, its exterior boundaries, the location and dimensions of all visible structures thereon, fences, apparent easements and rights-of-way and visible encroachments, if any.

This survey is made for the exclusive use of the present owner, who is hereby advised that the purchase, mortgage, or other use of the land is subject to the provisions of the Wisconsin Administrative Code.

Dated at Burlington this 27th day of January, 1989.

Kenneth R. Reesman
Surveyor



PMR-78

1-29-80

80011

K & E 10-7155

418-3986JA