


112-1

DESCRIPTION: Commencing at a point in the East line of the west one half of the northwest one quarter of Section 4, Town 4 north, Range 18 east of the 4th Principal Meridian, 814 feet South of the northeast corner of the N.W. $\frac{1}{4}$ of the N.W. $\frac{1}{4}$ of said section 4, thence West 100 feet to an iron stake, thence S. 6° 41' W., 413.5 feet to an iron stake, thence S. 42° 21' W., 81.1 feet to an iron stake, thence S. 46° 24' E., 39.89 feet to an iron stake, thence S. 38° 29' E., 78.5 feet to an iron stake, thence S. 22° 59' E., 147.75 feet to a point in the shore of Mill Lake, thence southeasterly along the shore of said Mill Lake 100 feet to an iron stake in the aforesaid East line of the west one half of the northwest one quarter of said Section 4; thence North in the last mentioned one eighth section line 737 feet to the place of beginning. Containing 2.25 acres more or less.

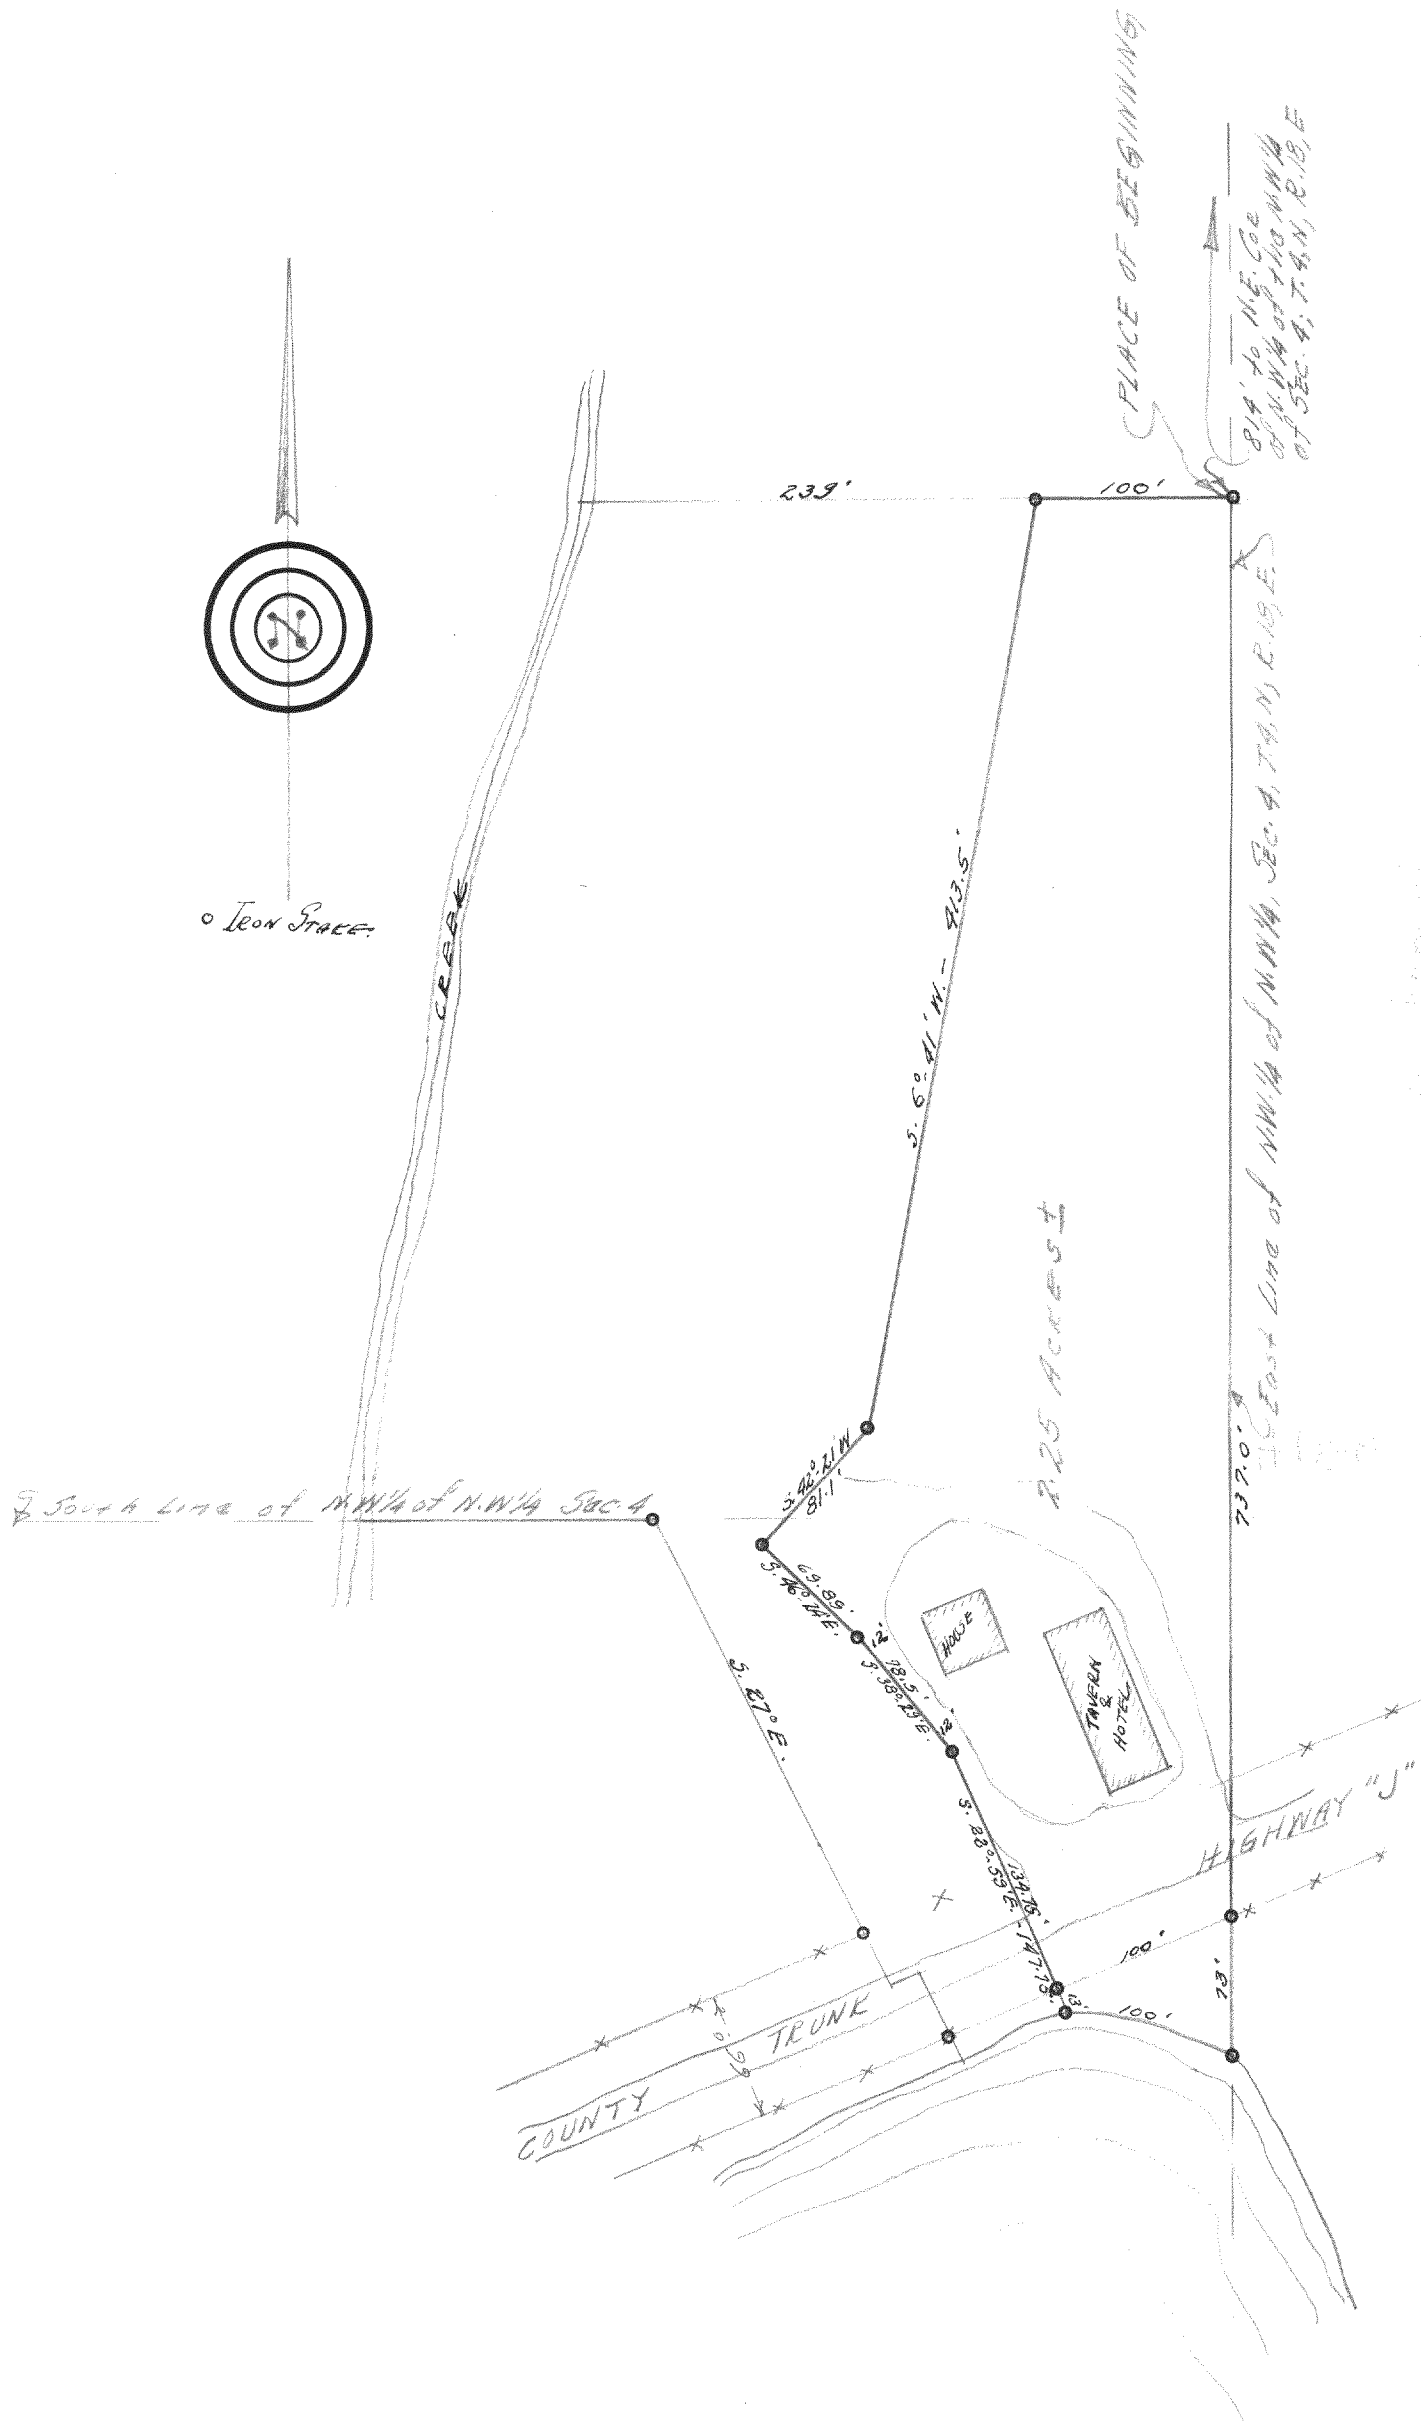

CERTIFICATE: I, hereby certify that I have on this the 8th day of October, 1949 surveyed the above described property and find that no encroachments exist.

Joseph M. Biagi, Professional Engineer.
Elkhorn Wisconsin.