



PLAT OF SURVEY OF LOT 17 OF ISLAND CLUB
 LOCATED IN THE SW 1/4 OF SECTION 4 T4N, R18E, WALWORTH
 COUNTY, WISCONSIN

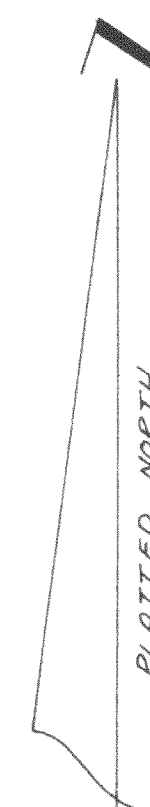

LEGEND
 ● ~ 1 3/16" DIA. ROUND IRON BAR FOUND
 ○ ~ 3/4" DIA. ROUND IRON BAR FOUND
 ○ ~ 1" DIA. ROUND IRON PIPE FOUND
 NOTE: PLATTED BEARING & DISTANCES


SCALE 1" = 20'

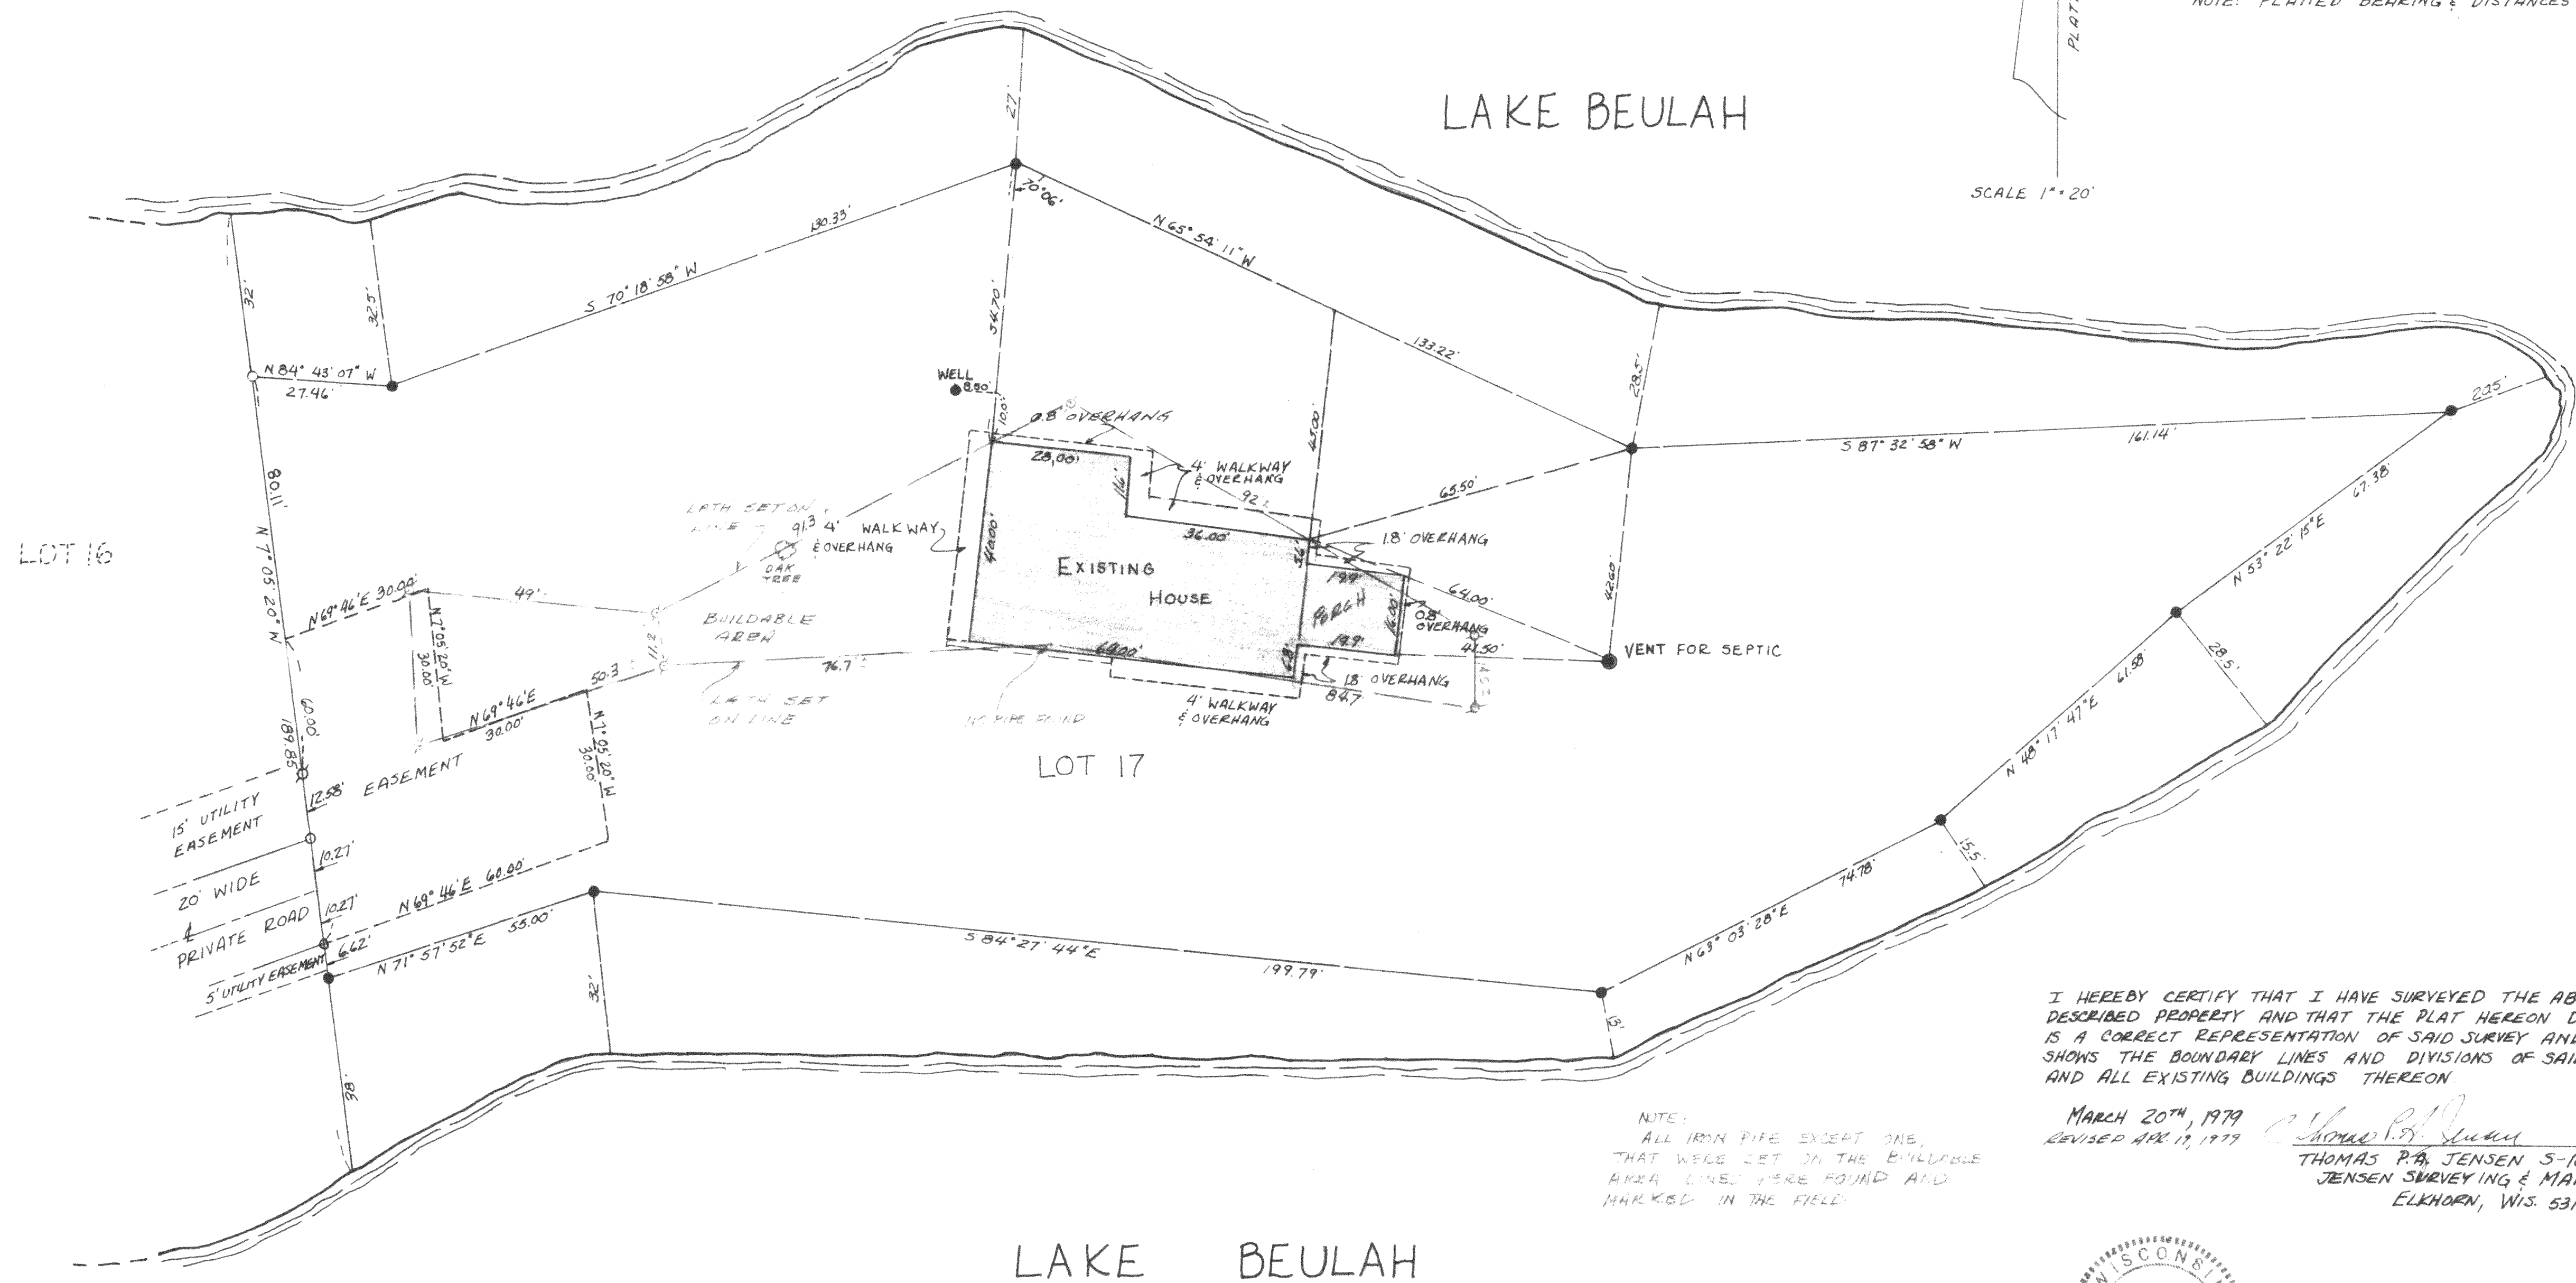

I HEREBY CERTIFY THAT I HAVE SURVEYED THE ABOVE
 DESCRIBED PROPERTY AND THAT THE PLAT HEREON DRAWN
 IS A CORRECT REPRESENTATION OF SAID SURVEY AND CORRECTLY
 SHOWS THE BOUNDARY LINES AND DIVISIONS OF SAID PROPERTY
 AND ALL EXISTING BUILDINGS THEREON

MARCH 20TH, 1979
 REVISED APR 17, 1979

THOMAS P. A. JENSEN S-1084
 JENSEN SURVEYING & MAPPING
 ELKHORN, WIS. 53121

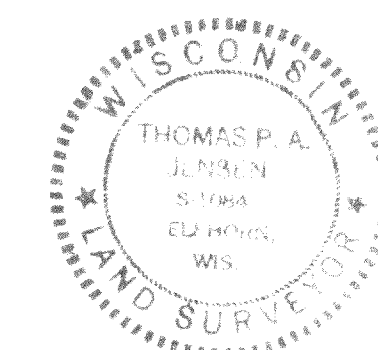

1919.015

418-400