
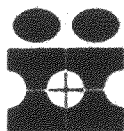


RECERTIFICATION
Plat of Survey

Survey For: TRUSTWAY HOMES, INC.
Location: 901 Hickory Road

James Haasch

Description: Lot 23 & 24, Block 12, MIRAMAR SUBDIVISION, being a part of the North East 1/4 and the South East 1/4 of Section 10, and the North West 1/4 and the South West 1/4 of Section 11, all in Town 4 North, Range 18 East, in the Town of East Troy, Walworth County, Wisconsin.

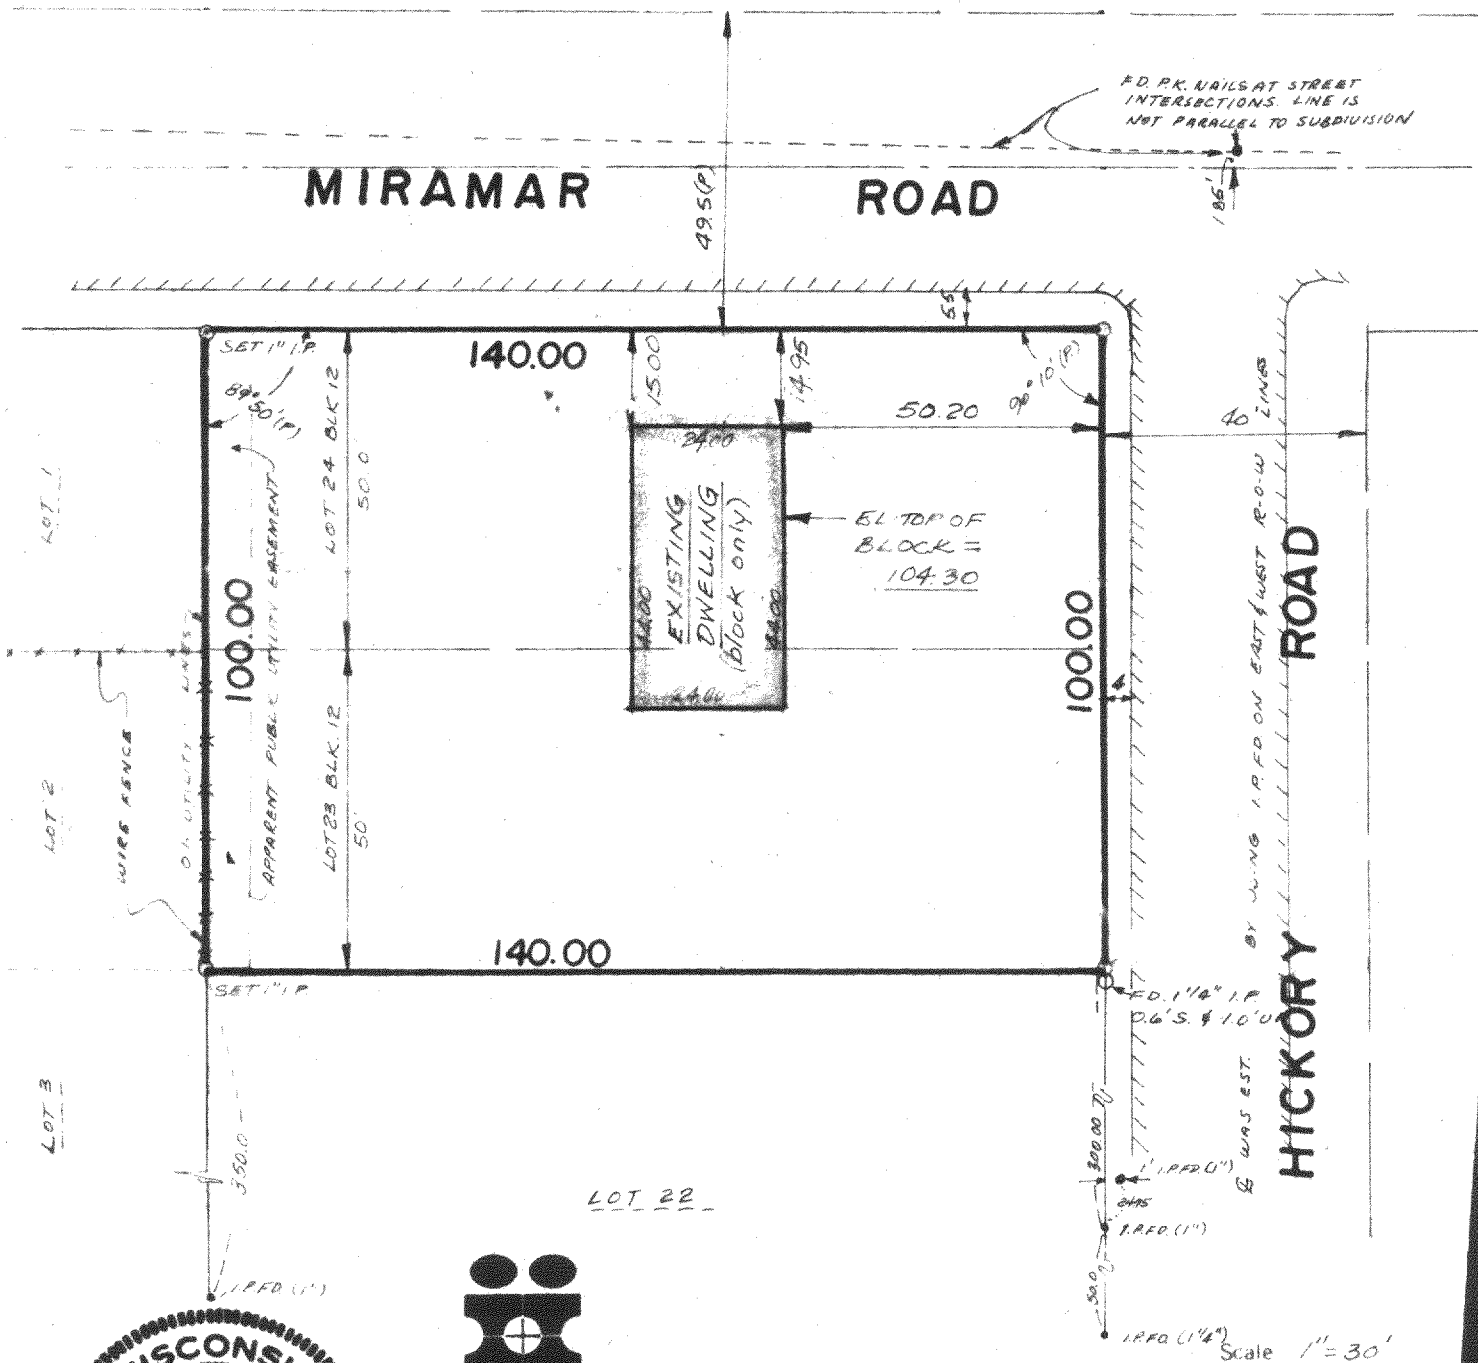

INMAN SURVEY

WEST OFFICE:
P.O. BOX 286
EAST TROY, WI 53120
(414) 642-3113

EAST OFFICE:
11221 W. FOREST HOME AVE.
MILWAUKEE, WI 53130
(414) 425-2060

SURVEY CERTIFICATE

State of Wisconsin) ss I certify that I have surveyed the above described (property) and the above map is a true
Milwaukee County representation thereof and shows the size and location of the Property, its exterior boundaries, the location and
dimensions of all visible structures thereon, fences, apparent easements and roadways and visible encroach-
ments, if any.

This survey is made for the exclusive use of the present owners of the Property, and also those who purchase, mortgage, or guarantee the title thereto within one (1) year from date hereof:

Thomas Inman
THOMAS INMAN, Registered Land Surveyor

DATE: 3/4/80
JOB NO.: 8214

PMR-141

418-409