

PLAT OF SURVEY

DESCRIPTION: LOT 1 OF CERT SURVEY MAP NO 58
PART OF N.W. 1/4 SEC. 9 T.4 N. R.18 E.
TOWN OF EAST TROY WALWORTH CO
WISCONSIN


CLIENT: WOLLENHAUP

LAKE BEULAH


N

SCALE: 1" = 30'
JOB: 8375

S. SHORE DRIVE

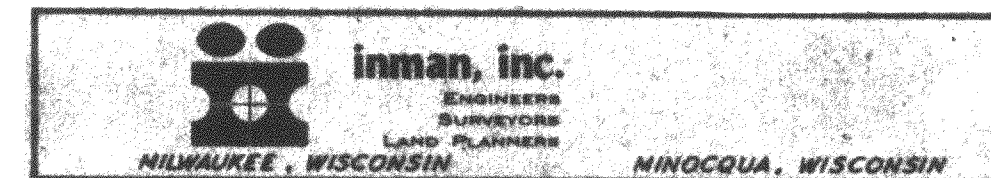

THOMAS INMAN, Registered Land Surveyor

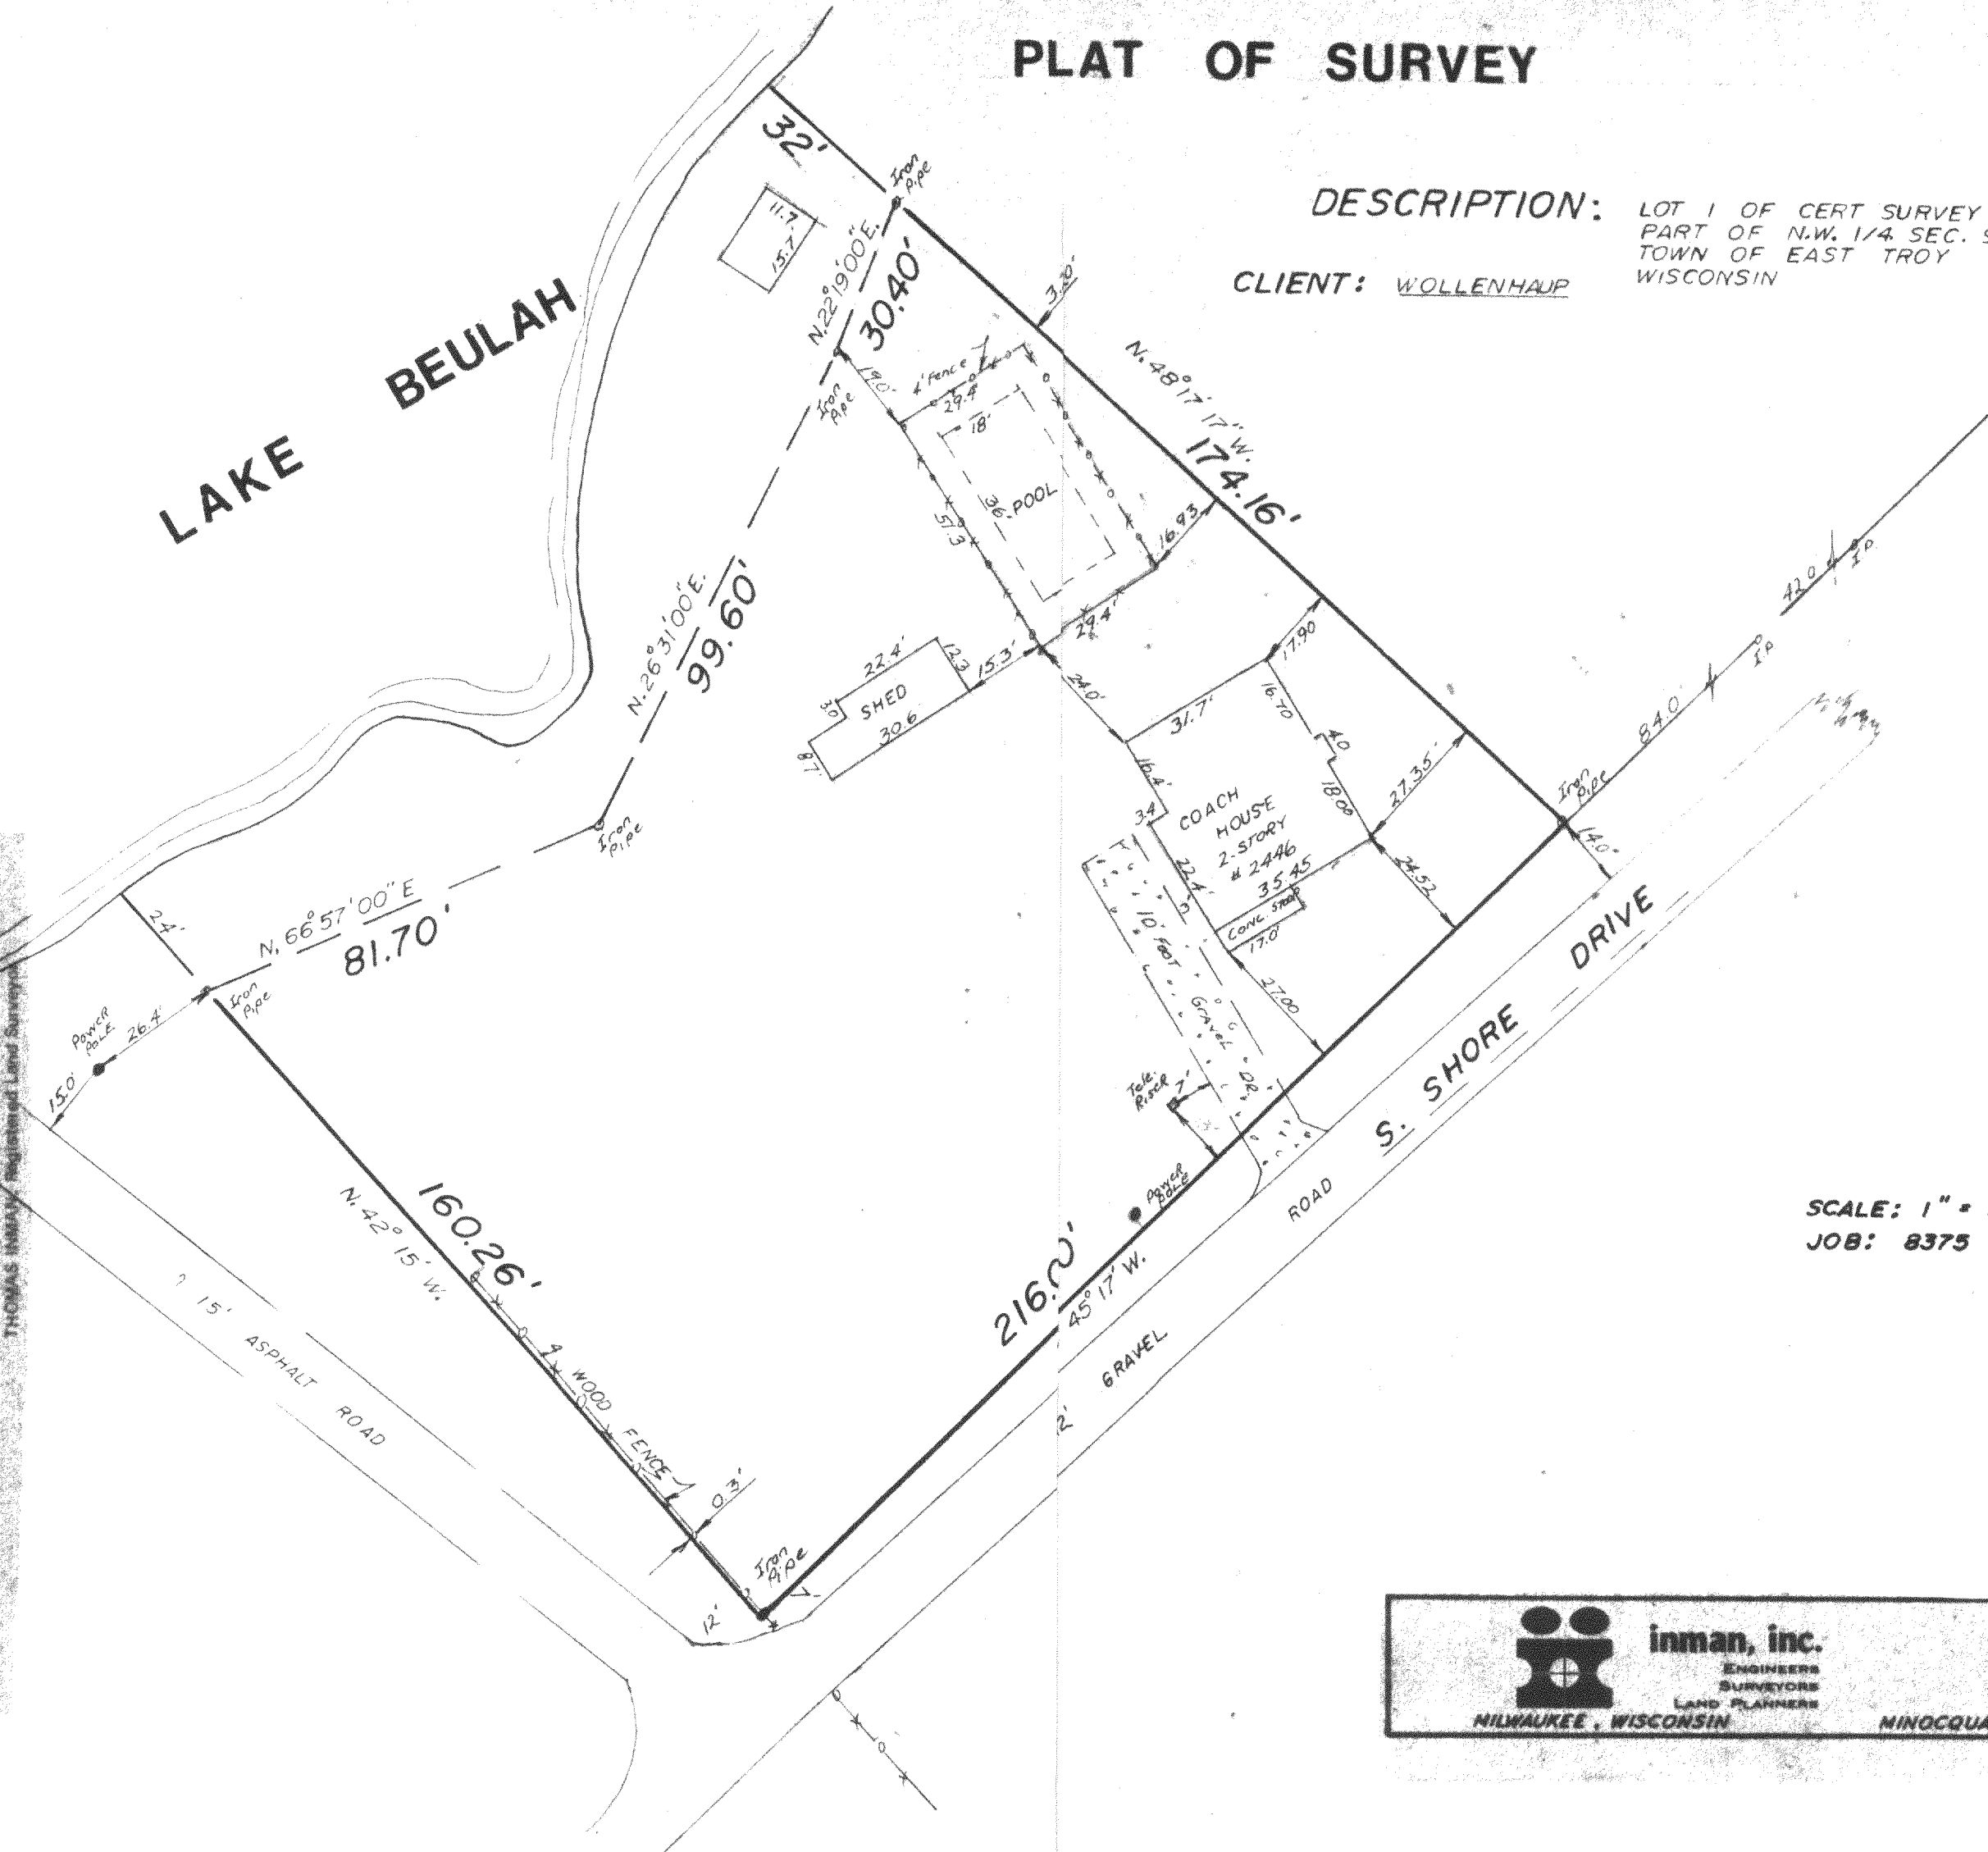

SURVEY CERTIFICATE

I certify that I have surveyed the above described property and the above map is a true representation thereof and shows the size and location of the property, its exterior boundaries, the location and dimensions of all buildings, structures, fences, apparent easements and roadways and visible encroachments, if any.

This survey is made for the exclusive use of the present owners of the property, and also those who purchase, mortgage, or guarantee the title thereto within one (1) year from date hereof.