

Date May 11, 1983


PLAT OF SURVEY

Job No. Z-4-28866

LOT 13 - FAIRWAY SUBDIVISION
being a resubdivision of part of Williams Park Subdivision located in the
Southwest 1/4, Northeast 1/4 and the Southeast 1/4 of the Northwest 1/4
of Section 4, Town 4 North, Range 18 East, Walworth County, Wisconsin.

Located at 2113 County Trunk 'J'

COUNTY TRUNK HIGHWAY "J" (66)
22' ± MACADAM ADW'Y.

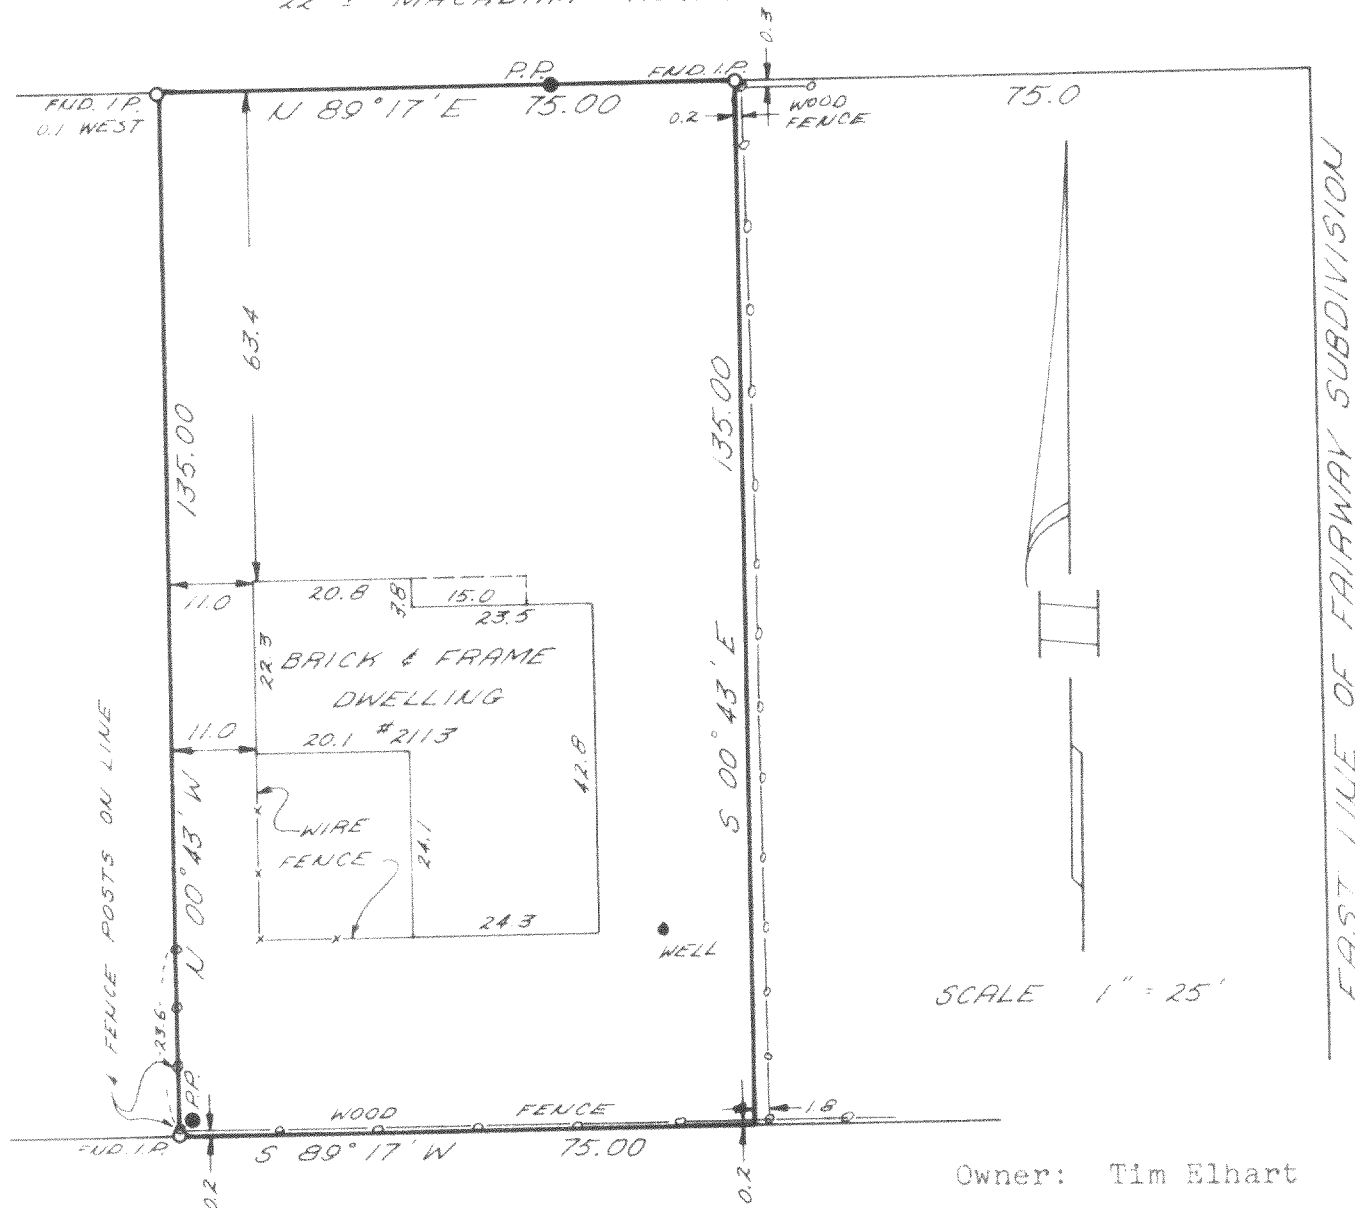

In accordance with Chapter A-E 5.01b, a signed agreement is on file waiving the setting of monuments on the property.

8522 West Lisbon Avenue
Milwaukee, Wisconsin 53222

SURVEYED FOR

Fleet Mortgages, Inc.
Suite 105
2433 North Mayfair Rd.
Wauwatosa, WI 53226

Surveyed by
RICHARD J. LAMMI

PHONE
461-3730

I have surveyed the above described property, and the above map is a true representation thereof and shows the size and location of the property, its exterior boundaries, the location and dimensions of all visible structures thereon, fences, apparent easements, roadways and visible encroachments.

This survey is made for the exclusive use of the present owners of the property; also those who purchase, mortgage or guarantee the title thereto, within one year from date hereof.

Richard J. Lammi
REGISTERED LAND SURVEYOR NO. 5-777 - STATE OF WISCONSIN

