

Date FEBRUARY 19, 1981

PLAT OF SURVEY

Job No. Z-4-25762

LOTS 42 & 43
FAIRWAY SUBDIVISION


BEING A PART OF THE SOUTHWEST 1/4 OF THE NORTHEAST 1/4 AND THE SOUTHEAST 1/4 OF THE NORTHEAST 1/4 OF SECTION 4,
TOWN 4 NORTH, RANGE 18 EAST, IN THE TOWN OF EAST TROY, WALWORTH COUNTY, WISCONSIN.

LOCATED AT 2159 FAIRWAY DRIVE



SCALE 1" = 30'

FAIRWAY DRIVE (66)
15' MAGADAM BONY

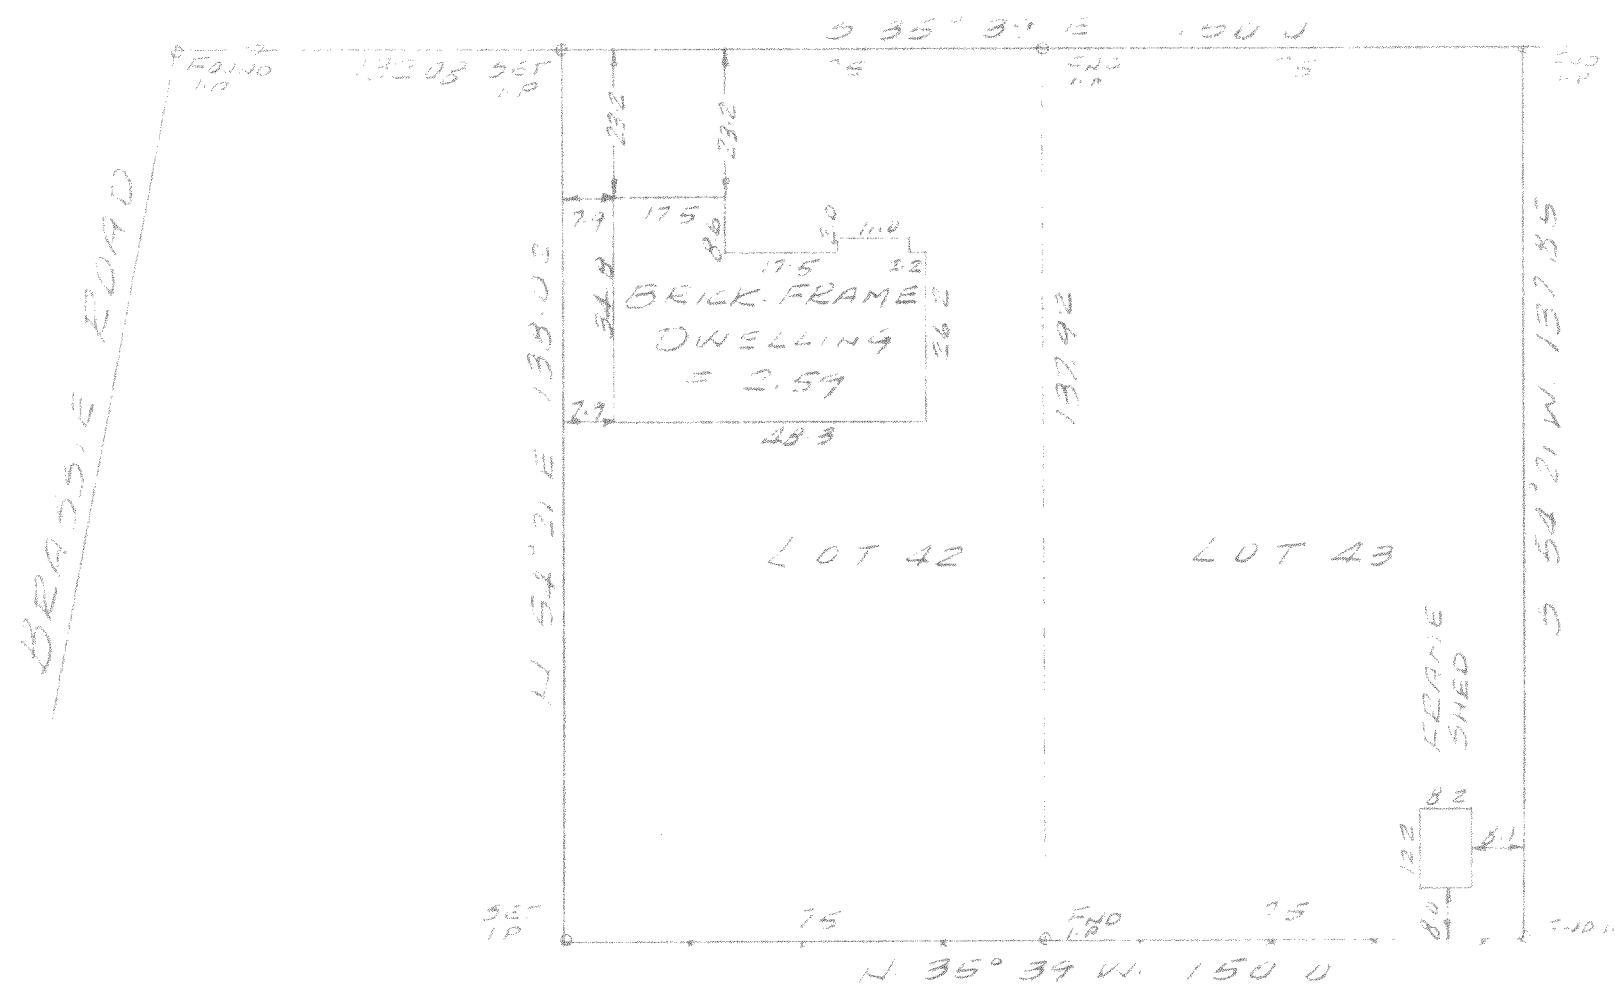

OWNER: Richard Rachul

8522 West Lisbon Avenue
Milwaukee, Wisconsin 53222

SURVEYED FOR

REPUBLIC SAVINGS AND LOAN ASSOCIATION
4375 South 76th Street
Greenfield, Wisconsin 53220


Surveyed by
RICHARD J. LAMMI

I have surveyed the above described property, and the above map is a true representation thereof and shows the size and location of the property, its exterior boundaries, the location and dimensions of all visible structures thereon, fences, apparent easements, roadways and visible encroachments.

This survey is made for the exclusive use of the present owners of the property, also those who purchase, mortgage or guarantee the title thereto, within one year from date hereof.

REGISTERED LAND SURVEYOR NO. 5-777 - STATE OF WISCONSIN

PHONE
461-3730

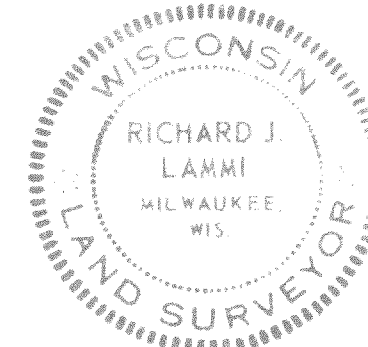

2, 42 & 43
Fairway Subd

418-432-L