




Plat of Survey

Survey For: TOM SAWYER
Location: ST. PETERS ROAD

Description: ALL THAT PART OF SECTION 17, TOWNSHIP 4 NORTH, RANGE 18 EAST, in the TOWN OF EAST TROY, WOLWORTH COUNTY, WISCONSIN, BOUNDED AND DESCRIBED AS FOLLOWS: COMMENCING AT THE SOUTHEAST CORNER OF SAID 1/4 SECTION: THENCE S. 88°39'16" W., ALONG THE SOUTH LINE OF SAID 1/4 SECTION 622.50 FEET TO THE POINT OF BEGINNING OF THE LANDS TO BE DESCRIBED: THENCE CONTINUING S. 88°39'16" W., 538.72 FEET TO A POINT: THENCE N. 01°14'00" E. 476.00 FEET TO A POINT: THENCE N. 83°01'27" E., 533.23 FEET TO A POINT IN THE WEST LINE OF THE CEMETERY PROPERTY: THENCE S. 00°06'12" W. 528.00 FEET TO THE POINT OF BEGINNING. CONTAINING 5.739 ACRES WITHOUT ROADWAY...

NO MONUMENT FOUND
POINT RELOCATED BY
TIES.

NOTE: ABUTTING PARCEL TO THE WEST HAS AN INCORRECT LEAD IN LINE. DEED AT 1,321.76, MEASURED 1,482.46 PLAT BOOK SHOULD BE REVISED.

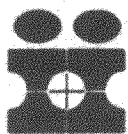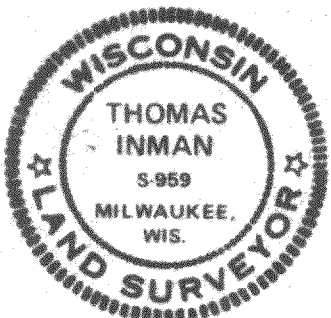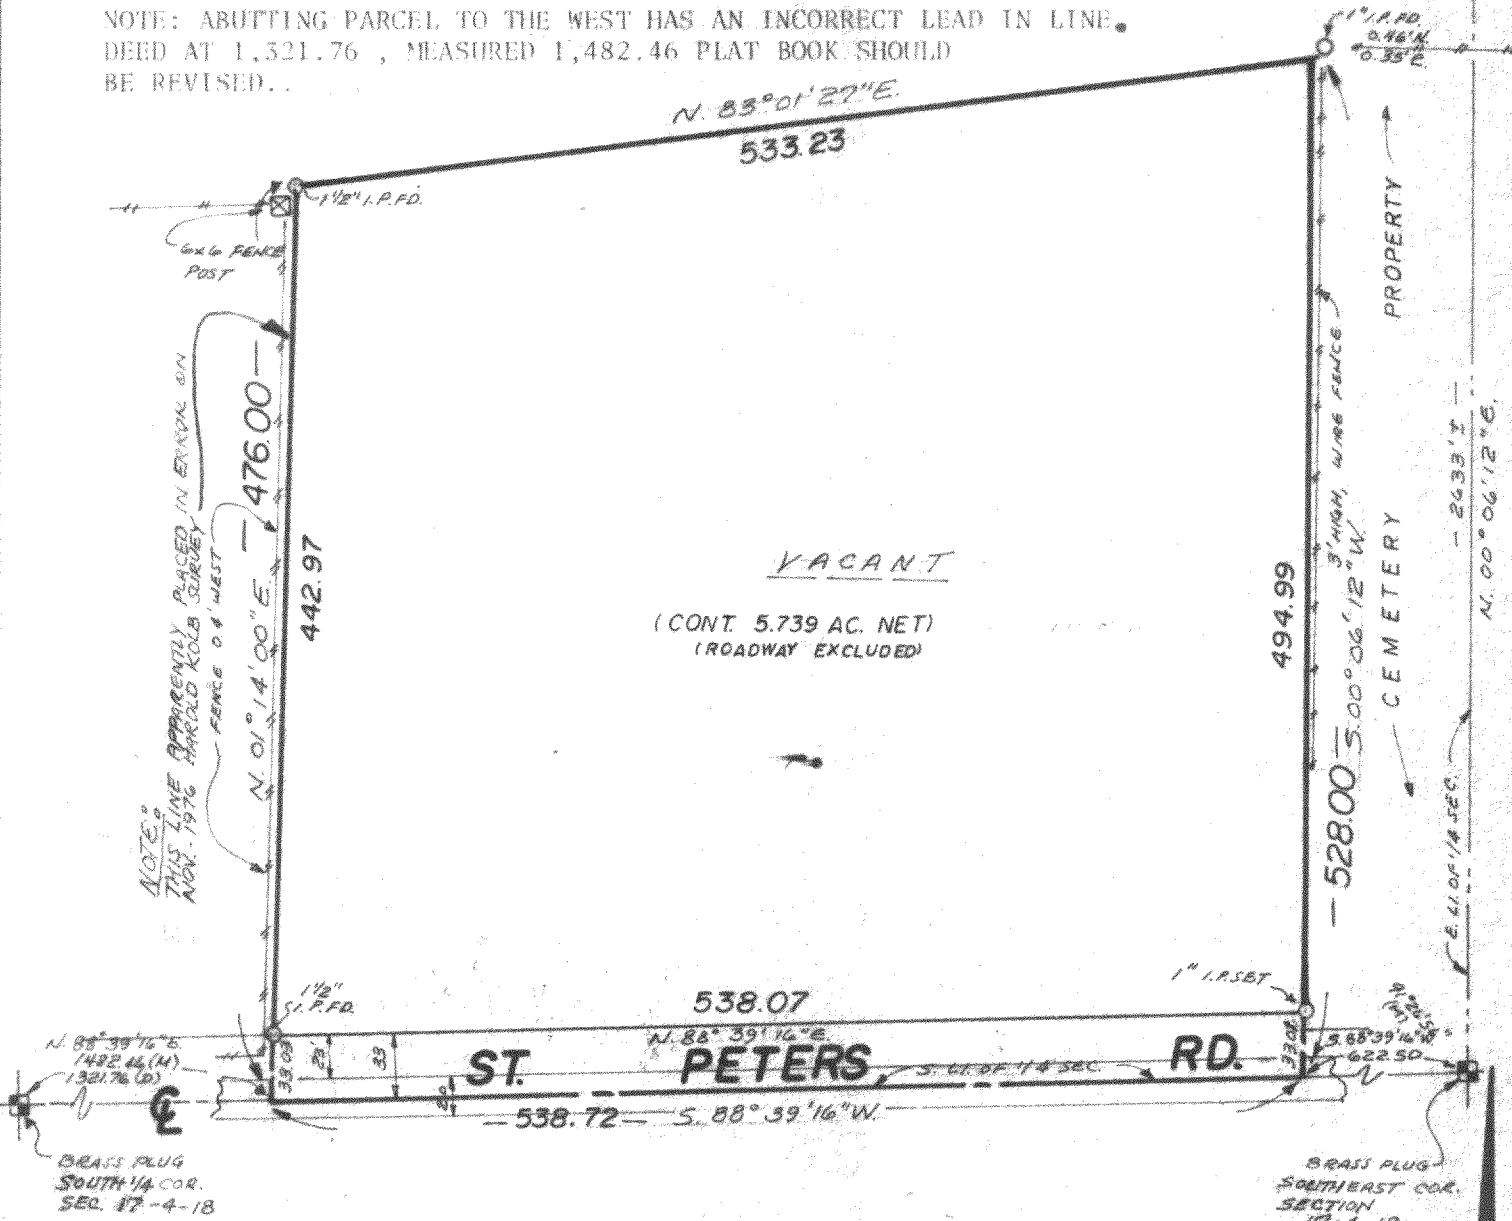

INMAN SURVEY

WEST OFFICE:
P.O. BOX 286
EAST TROY, WI 53120
(414) 642-3113

EAST OFFICE:
11221 W. FOREST HOME AVE.
MILWAUKEE, WI 53130
(414) 425-2060

SURVEY CERTIFICATE

State of Wisconsin) ss I certify that I have surveyed the above described (property) and the above map is a true representation thereof and shows the size and location of the Property, its exterior boundaries, the location and dimensions of all visible structures thereon, fences, apparent easements and roadways and visible encroachments, if any.

This survey is made for the exclusive use of the present owners of the Property, and also those who purchase, mortgage, or guarantee the title thereto within one (1) year from date hereof;

THOMAS INMAN, Registered Land Surveyor

DATE: 7-20-82

JOB NO.: 9781

Pd PET 17-9

418-433