


Plat of Survey

for

Joseph Kreutzer

The N 10' of Lot 9 and all of Lot 10, Block 1, Wilmer Grove Beach being a part of the E 1/2 of Section 18, T.4N., R.18E., Town of East Troy, Walworth County, Wisconsin.

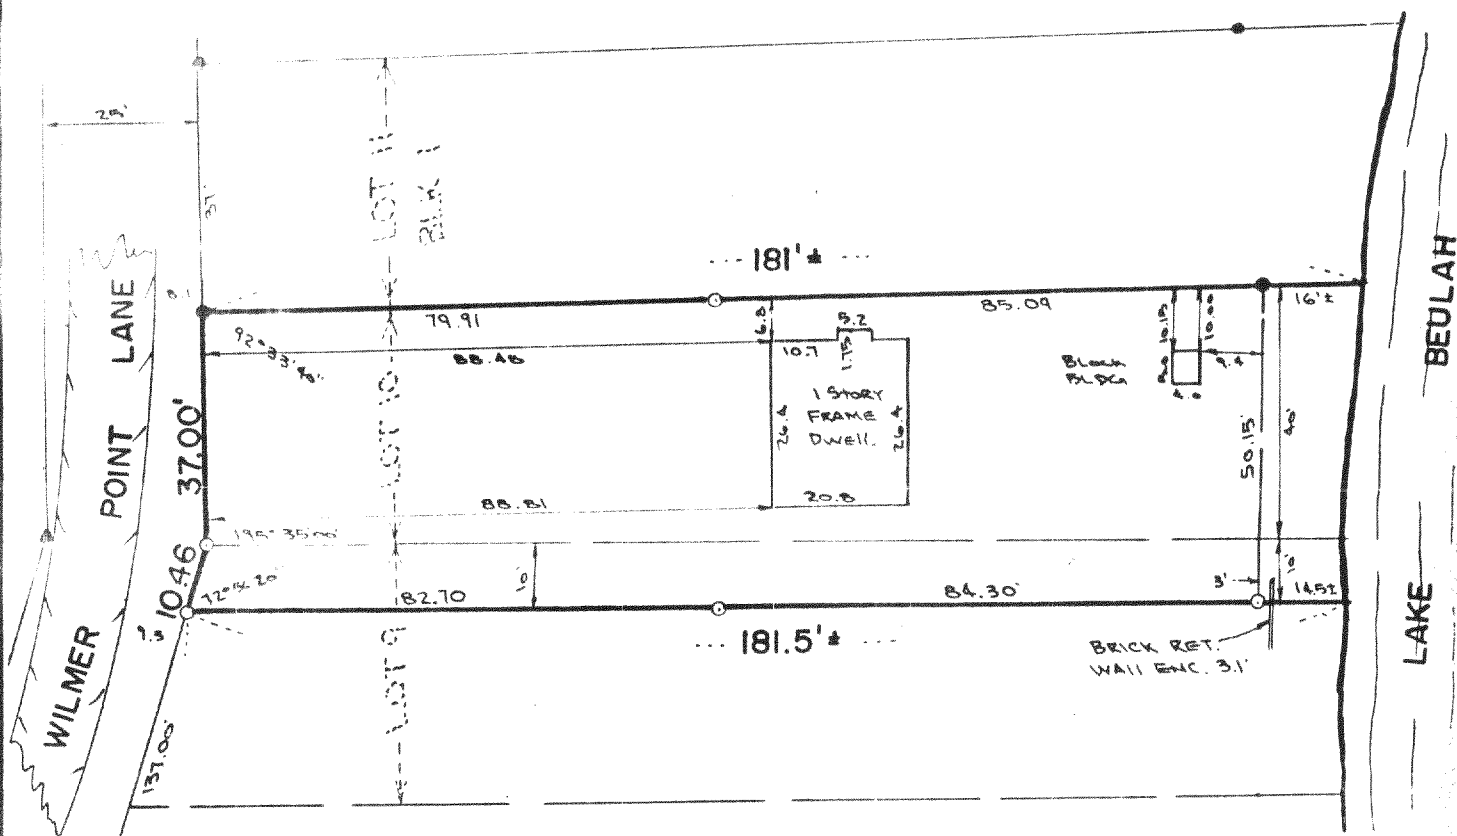


● - FOUND 1" IP UNLESS NOTED OTHERWISE
 ○ - SET 1" IP
 ▼ - FOUND IRON ROD

STATE OF WISCONSIN)
 WAUKESHA COUNTY) ss

CERTIFICATE

I CERTIFY THAT I HAVE SURVEYED THE ABOVE DESCRIBED PROPERTY, AND THE ABOVE MAP IS A TRUE REPRESENTATION THEREOF AND SHOWS THE SIZE AND LOCATION OF THE PROPERTY, ITS EXTERIOR BOUNDARIES, THE LOCATION AND DIMENSIONS OF ALL STRUCTURES THEREON, FENCES, APPARENT EASEMENTS AND ROADWAYS AND VISIBLE ENCROACHMENTS, IF ANY.
 THIS SURVEY IS MADE FOR THE EXCLUSIVE USE OF THE PRESENT OWNERS OF THE PROPERTY, AND ALSO THOSE WHO PURCHASE, MORTGAGE, OR GUARANTEE THE TITLE THERETO, WITHIN ONE (1) YEAR FROM DATE HEREOF; AND AS TO THEM I HEREBY CERTIFY THAT SAID SURVEY AND THE INFORMATION CONTAINED THEREON IS TO THE BEST OF MY KNOWLEDGE, INFORMATION AND BELIEF A TRUE AND ACCURATE REPRESENTATION THEREOF.

DATE JULY 7, 1982 Donald C. Chaput
 REGISTERED LAND SURVEYOR

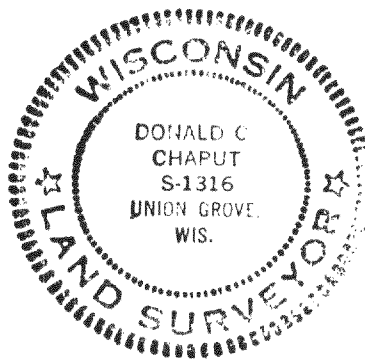

SCALE: 1" = 30'



418-434



THE CORNERSTONE GROUP, INC.

2000 EAST RACINE AVENUE,
 WAUKESHA, WISCONSIN 53186

PLANNING • ENGINEERING • SURVEYING • LANDSCAPE ARCHITECTS

DRAFTED BY: D.C.

CHECKED BY: D.C.

WAIVERS OBTAINED

JOB NO. 358