


Date June 28, 1982

PLAT OF SURVEY

Job No. Z-10-27172

LOT 19 - BLOCK 7 - MIRAMAR
being a subdivision located in Sections 10 and 11, Town 4 North, Range
18 East, Town of East Troy, Walworth County, Wisconsin.

Located at 1033 Hickory Street

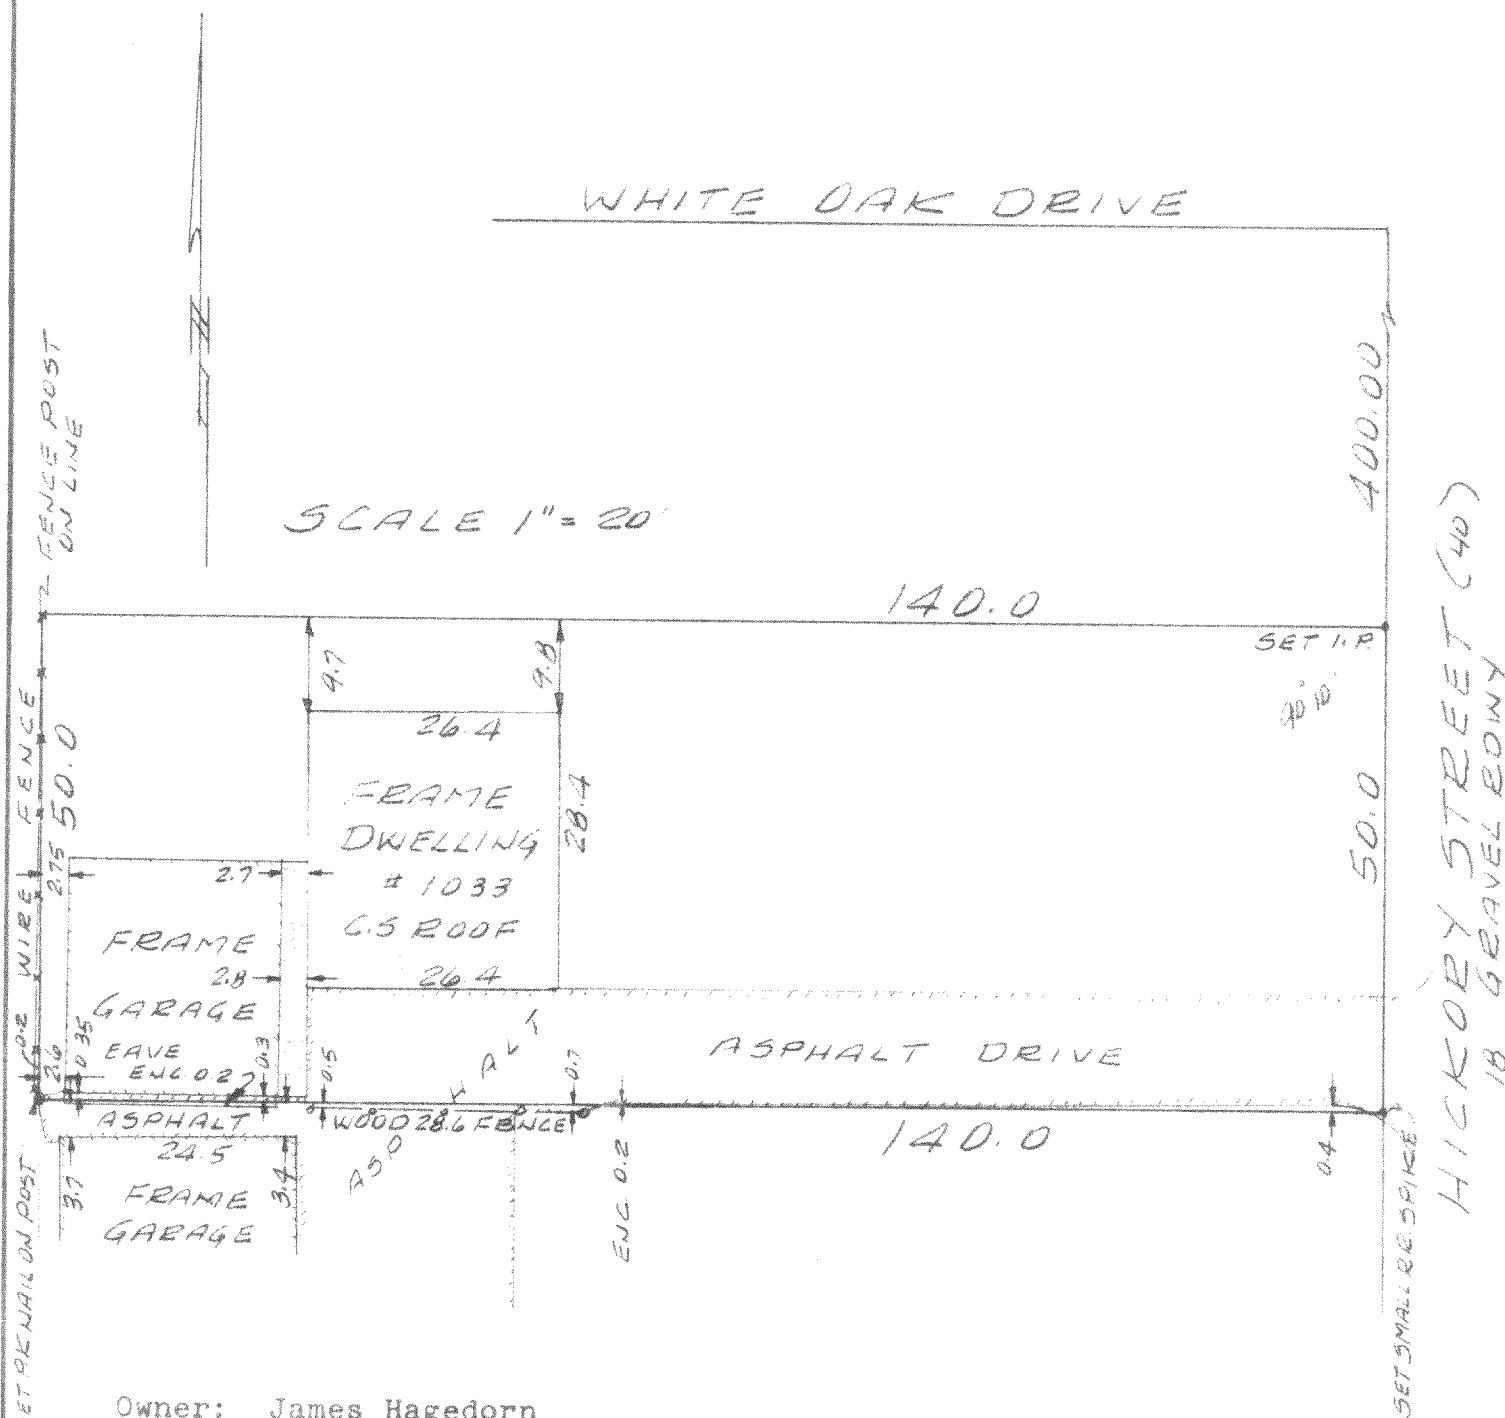

Owner: James Hagedorn

8522 West Lisbon Avenue
Milwaukee, Wisconsin 53222

Surveyed by
RICHARD J. LAMMI

PHONE
461-3730

SURVEYED FOR

Banco Mortgage Co.
P. O. Box 26144
Milwaukee, WI 53226

I have surveyed the above described property, and the above map is a true representation thereof and shows the size and location of the property, its exterior boundaries, the location and dimensions of all visible structures thereon, fences, apparent easements, roadways and visible encroachments.

This survey is made for the exclusive use of the present owners of the property; also those who purchase, mortgage or guarantee the title thereto, within one year from date hereof.

REGISTERED LAND SURVEYOR NO. 5-777 - STATE OF WISCONSIN



418-438