
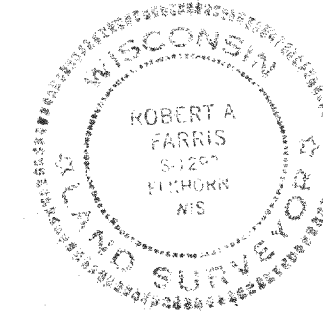



W 1/4 SEC 25
SE 1/4 SEC 7

PLAT OF SURVEY LOT 8, RONDA'S ROLLING ACRES
LOCATED IN SW 1/4 OF SE 1/4 OF SEC. 7, T. 4N, R. 18E
VALWORTH COUNTY, WISCONSIN

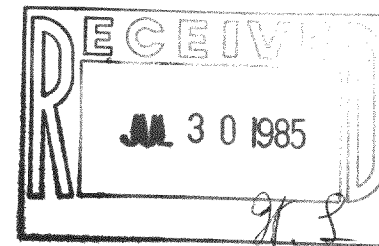

I hereby certify that I have surveyed the above described property and that the above map is a true representation thereof and shows the size and location of the property, its exterior boundaries, the location of all visible structures and dimensions of all principal buildings thereon, boundary fences, apparent easements, roadways and visible encroachments, if any.
This survey is made for the use of the present owners of the property, and also those who purchase, mortgage, or guarantee the title thereto within one (1) year from the date hereof.

Robert A. Farris
3/23/85

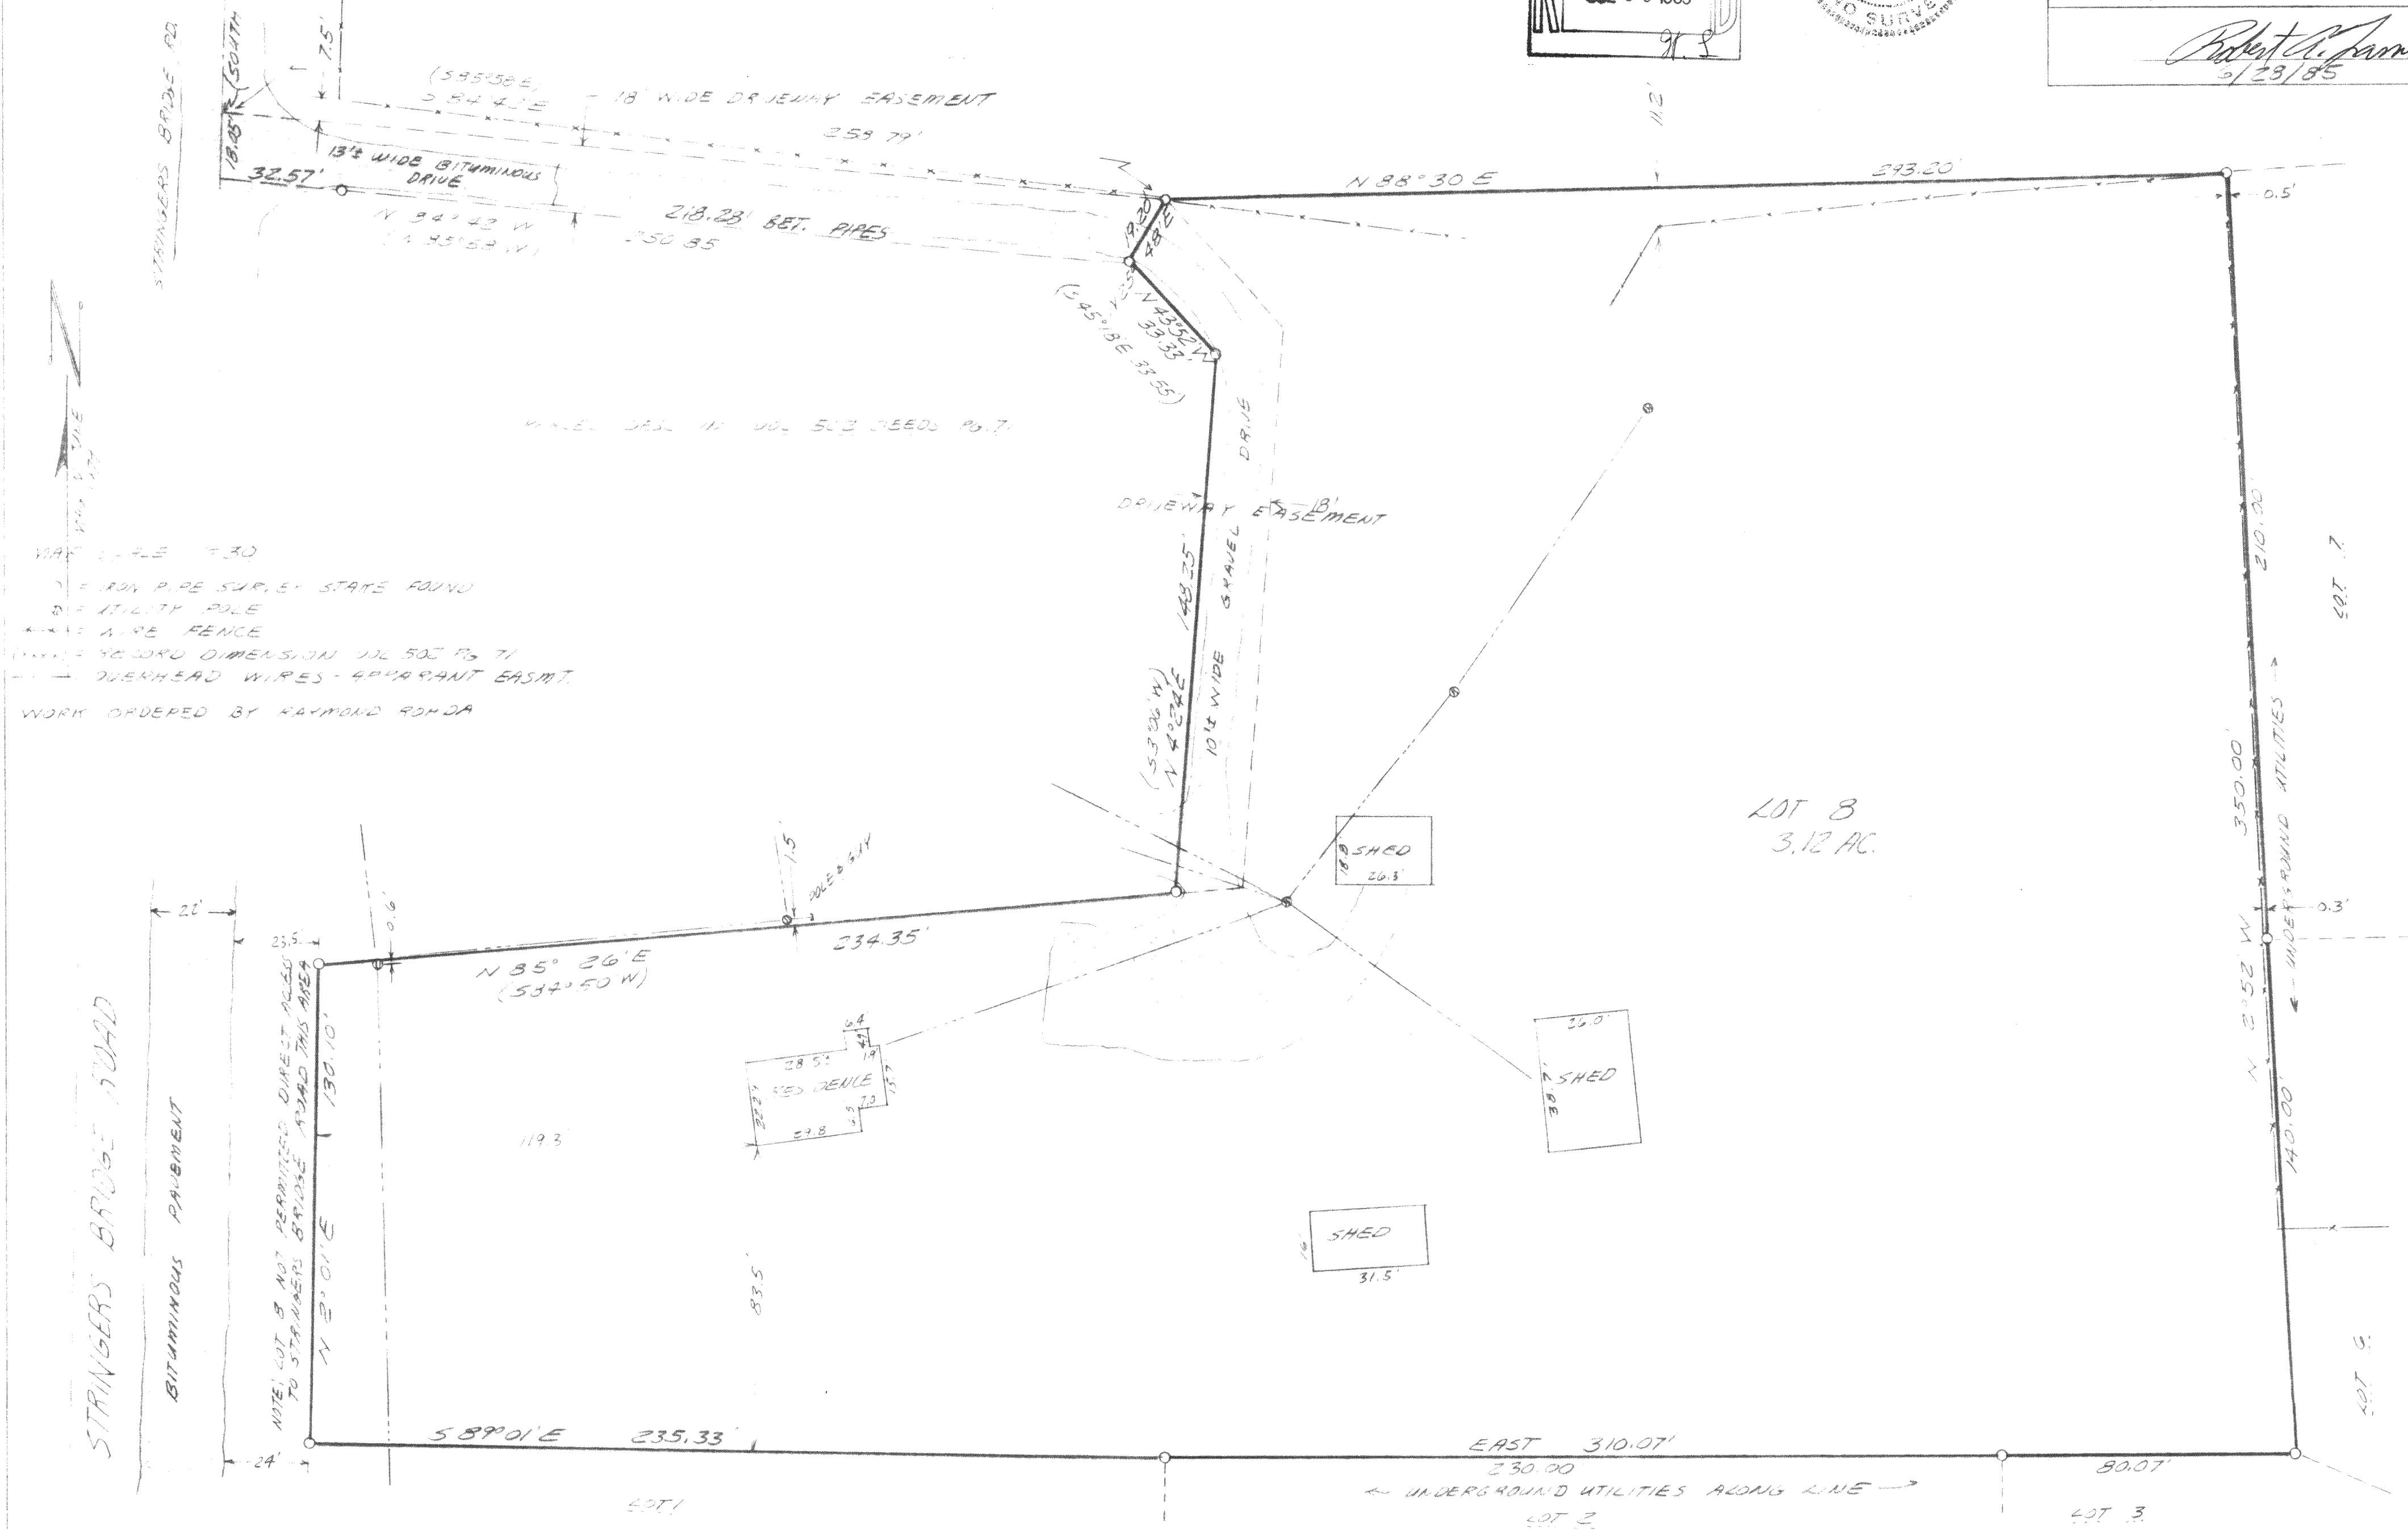

MAP SCALE 1" = 30'
1" = 30' RUN PIPE SURVEY STATE FOUND
2" = UTILITY POLE
4" = WIRE FENCE
DIMENSION RECORD DIMENSION 100' 50' TO 71'
OVERHEAD WIRES - APPARENT EASMT.
WORK ORDERED BY RAYMOND RONDA