
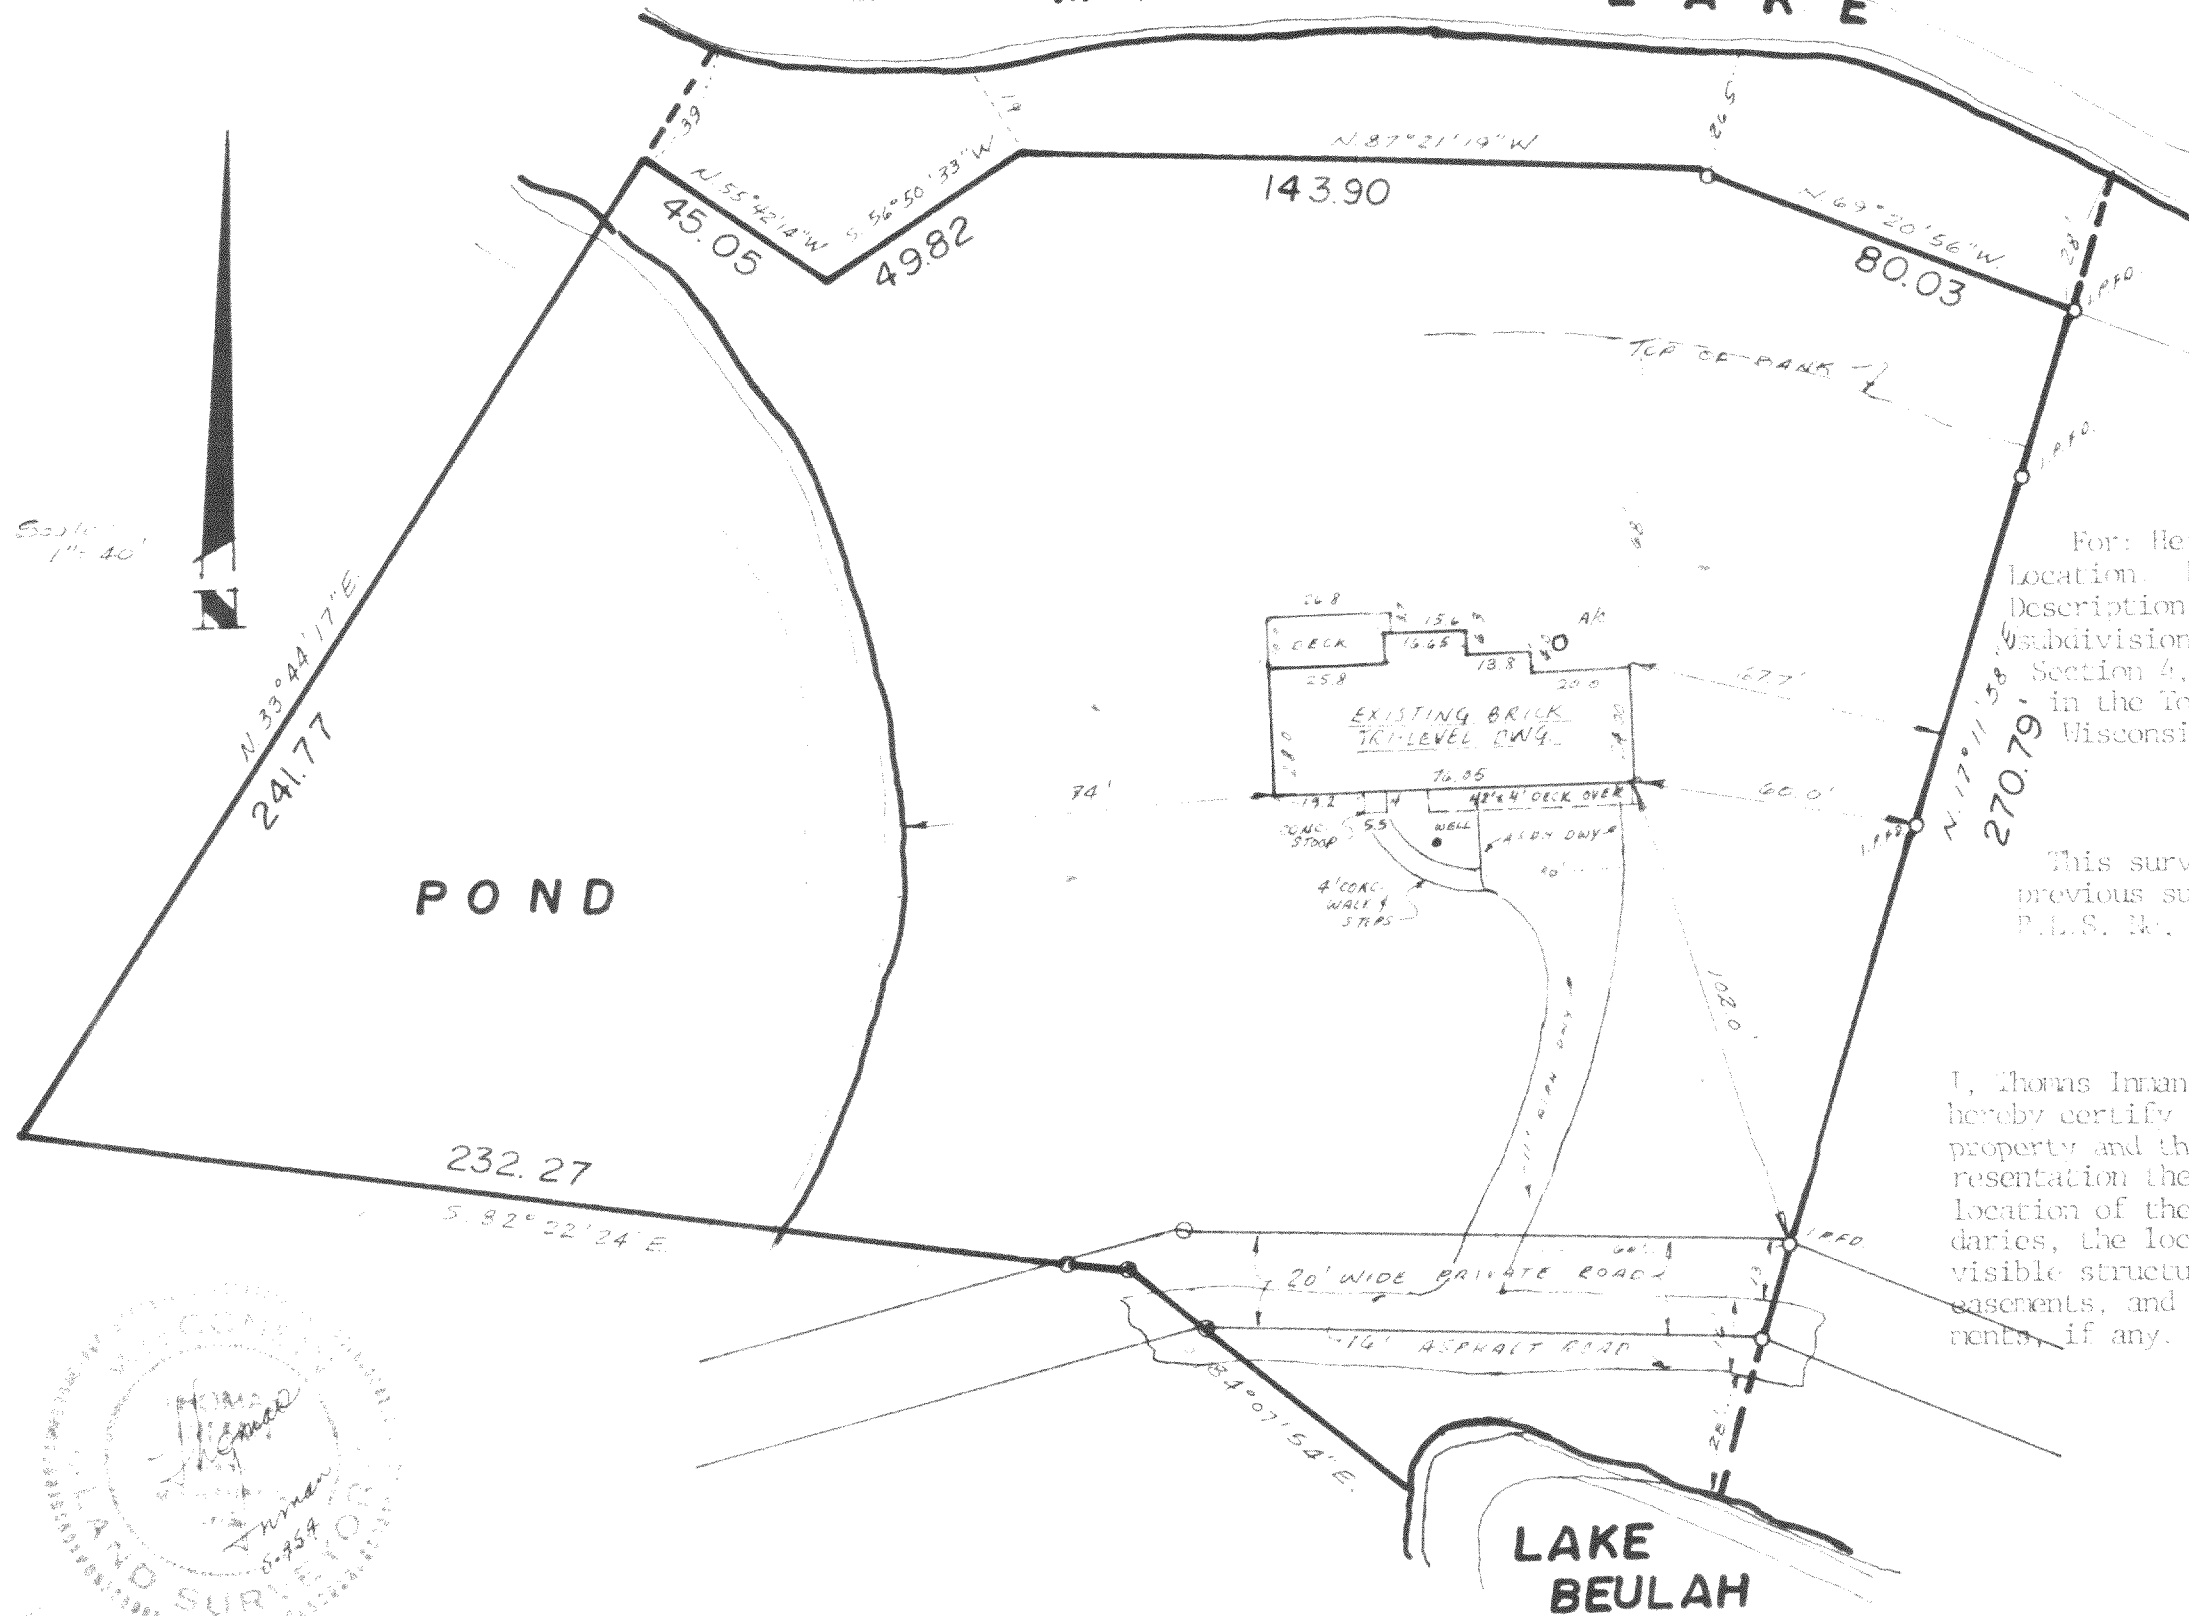


MILL LAKE

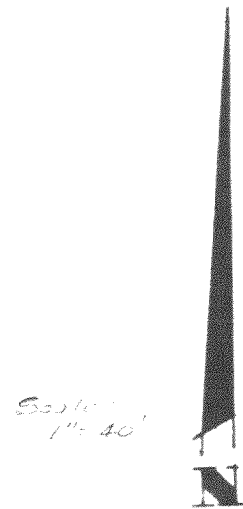


PLAT OF SURVEY

For: Herb Backbarth
 Location: Private Road
 Description: LOT 14 ISLAND CLUB
 Subdivision of a part of the S.W. 1/4 of
 Section 4, Town 4 North, Range 18 East,
 in the Town of East Troy, Walworth Co.,
 Wisconsin.

This survey is a re-enactment of a
 previous survey prepared by W. Shearman,
 P.L.S. No. 1378, done in Sept., 1977.

I, Thomas Innan, Registered Land Surveyor, do
 hereby certify that the above described
 property and the above map is a true rep-
 resentation thereof, and shows the size and
 location of the property, its exterior bound-
 aries, the location and dimensions of all
 visible structures thereon, fences, apparent
 easements, and roadways, and visible encroach-
 ments, if any.

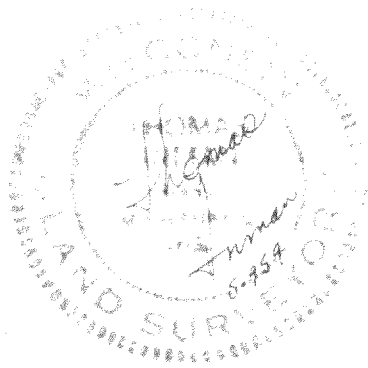

JOB NO. 11374
 AUG 8TH 1984

418-468