




PLAT OF SURVEY
OF
LOT 6, 7 & 8, BLOCK II OF
MIRAMAR SUBDIVISION
SEC. 10, T. 4 N., R. 18 E., WALWORTH CO.

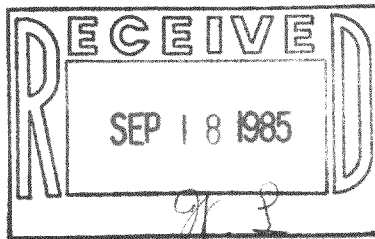

WORK ORDERED BY: DONALD SCHMIDT

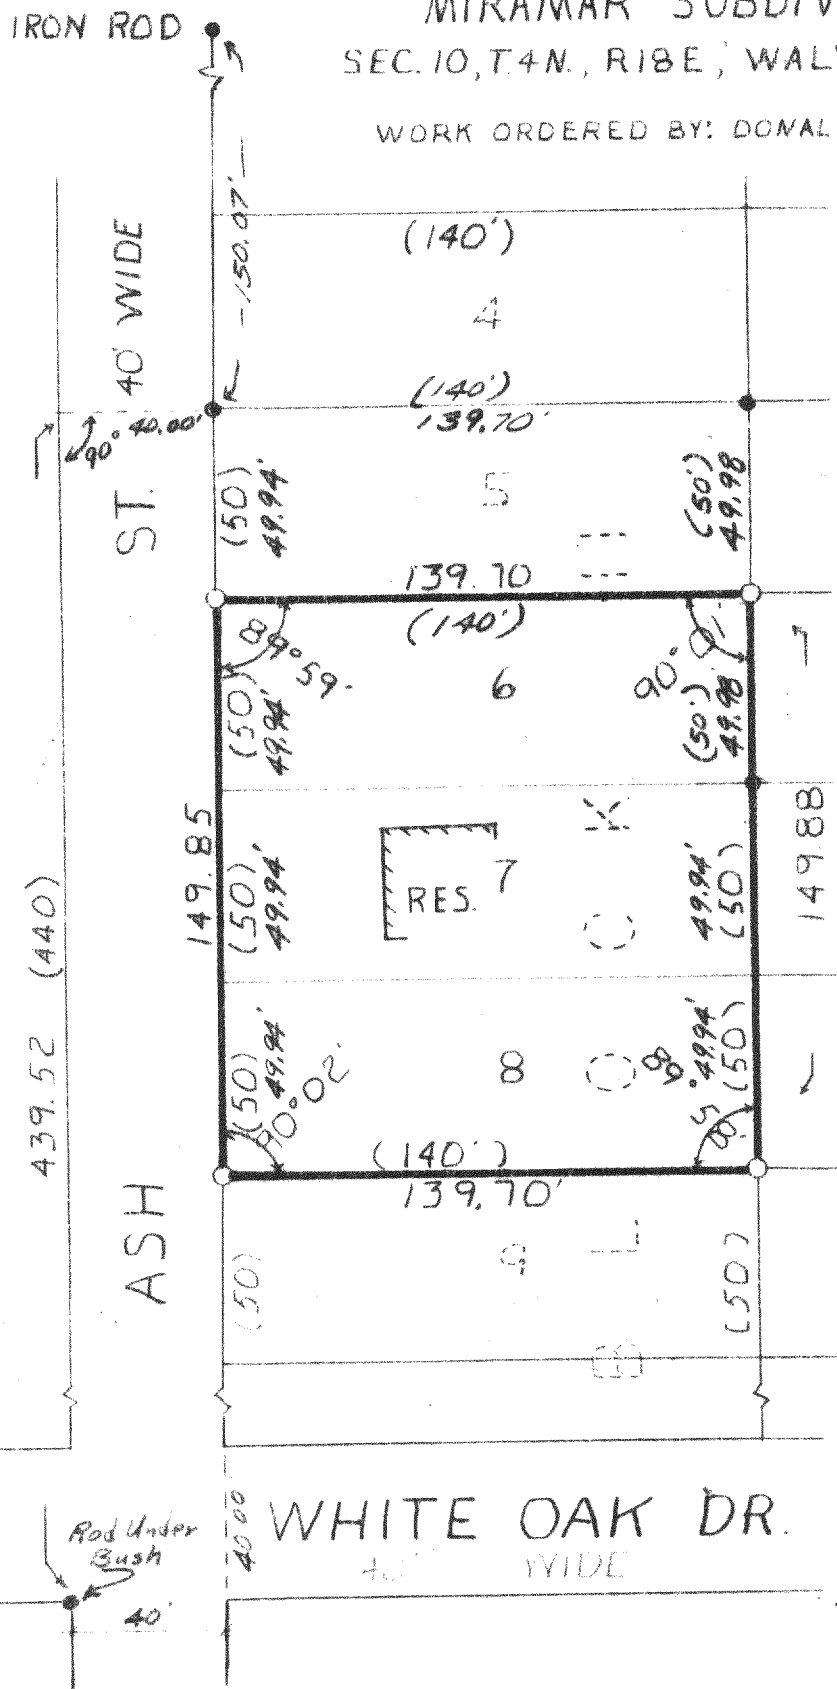

SCALE: 1"=50'

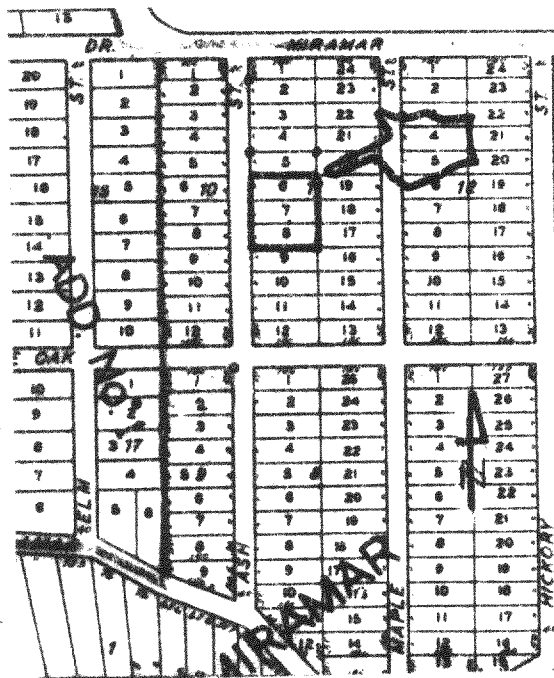

LOCATION SKETCH

LEGEND


- = FOUND IRON PIPE OR ROD
- = SET IRON PIPE 1"X24"
- (XXX) = RECORDED DIMENSION

FARRIS, HANSEN & ASSOCIATES, INC.
7 Ridgeway Court - P.O. Box 487
Elkhorn, Wisconsin
414-723-2098

I hereby certify that this plat of survey
is a true and accurate representation of
the boundary lines of the above described
property to the best of my professional
knowledge and belief.

Robert A. Farris
Robert A. Farris, P.L.S.

Dated this 7th day of August, 1985

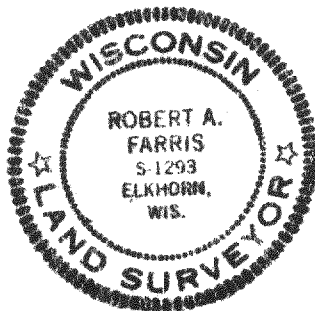

PROJ. # 2452

PMR-00113BI

418-477-F