

PLAT OF SURVEY OF

LOT 1 OF LAKE BEULAH COUNTRY CLUB SUBDIVISION
 LOCATED IN SECTION 18, T4N, R1E, TOWN OF EAST TROY,
 WALWORTH COUNTY, WISCONSIN.

Surveyed by ~

JENSEN SURVEYING & MAPPING S.C.

PO BOX 322

45 S. WISCONSIN ST.

ELKHORN, WISCONSIN




PHONE (414) 723-3434

53121

Surveyed for ~

MIKE BRENNEN

WILLIAMS BAY, WISC.

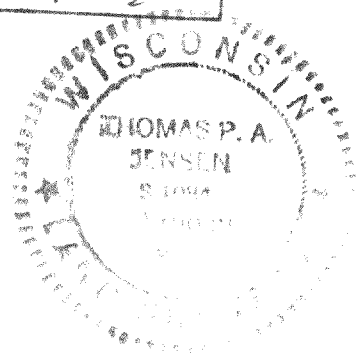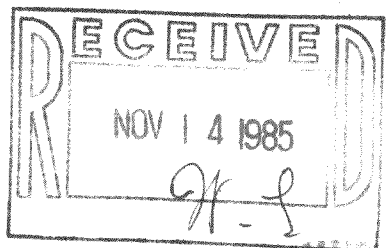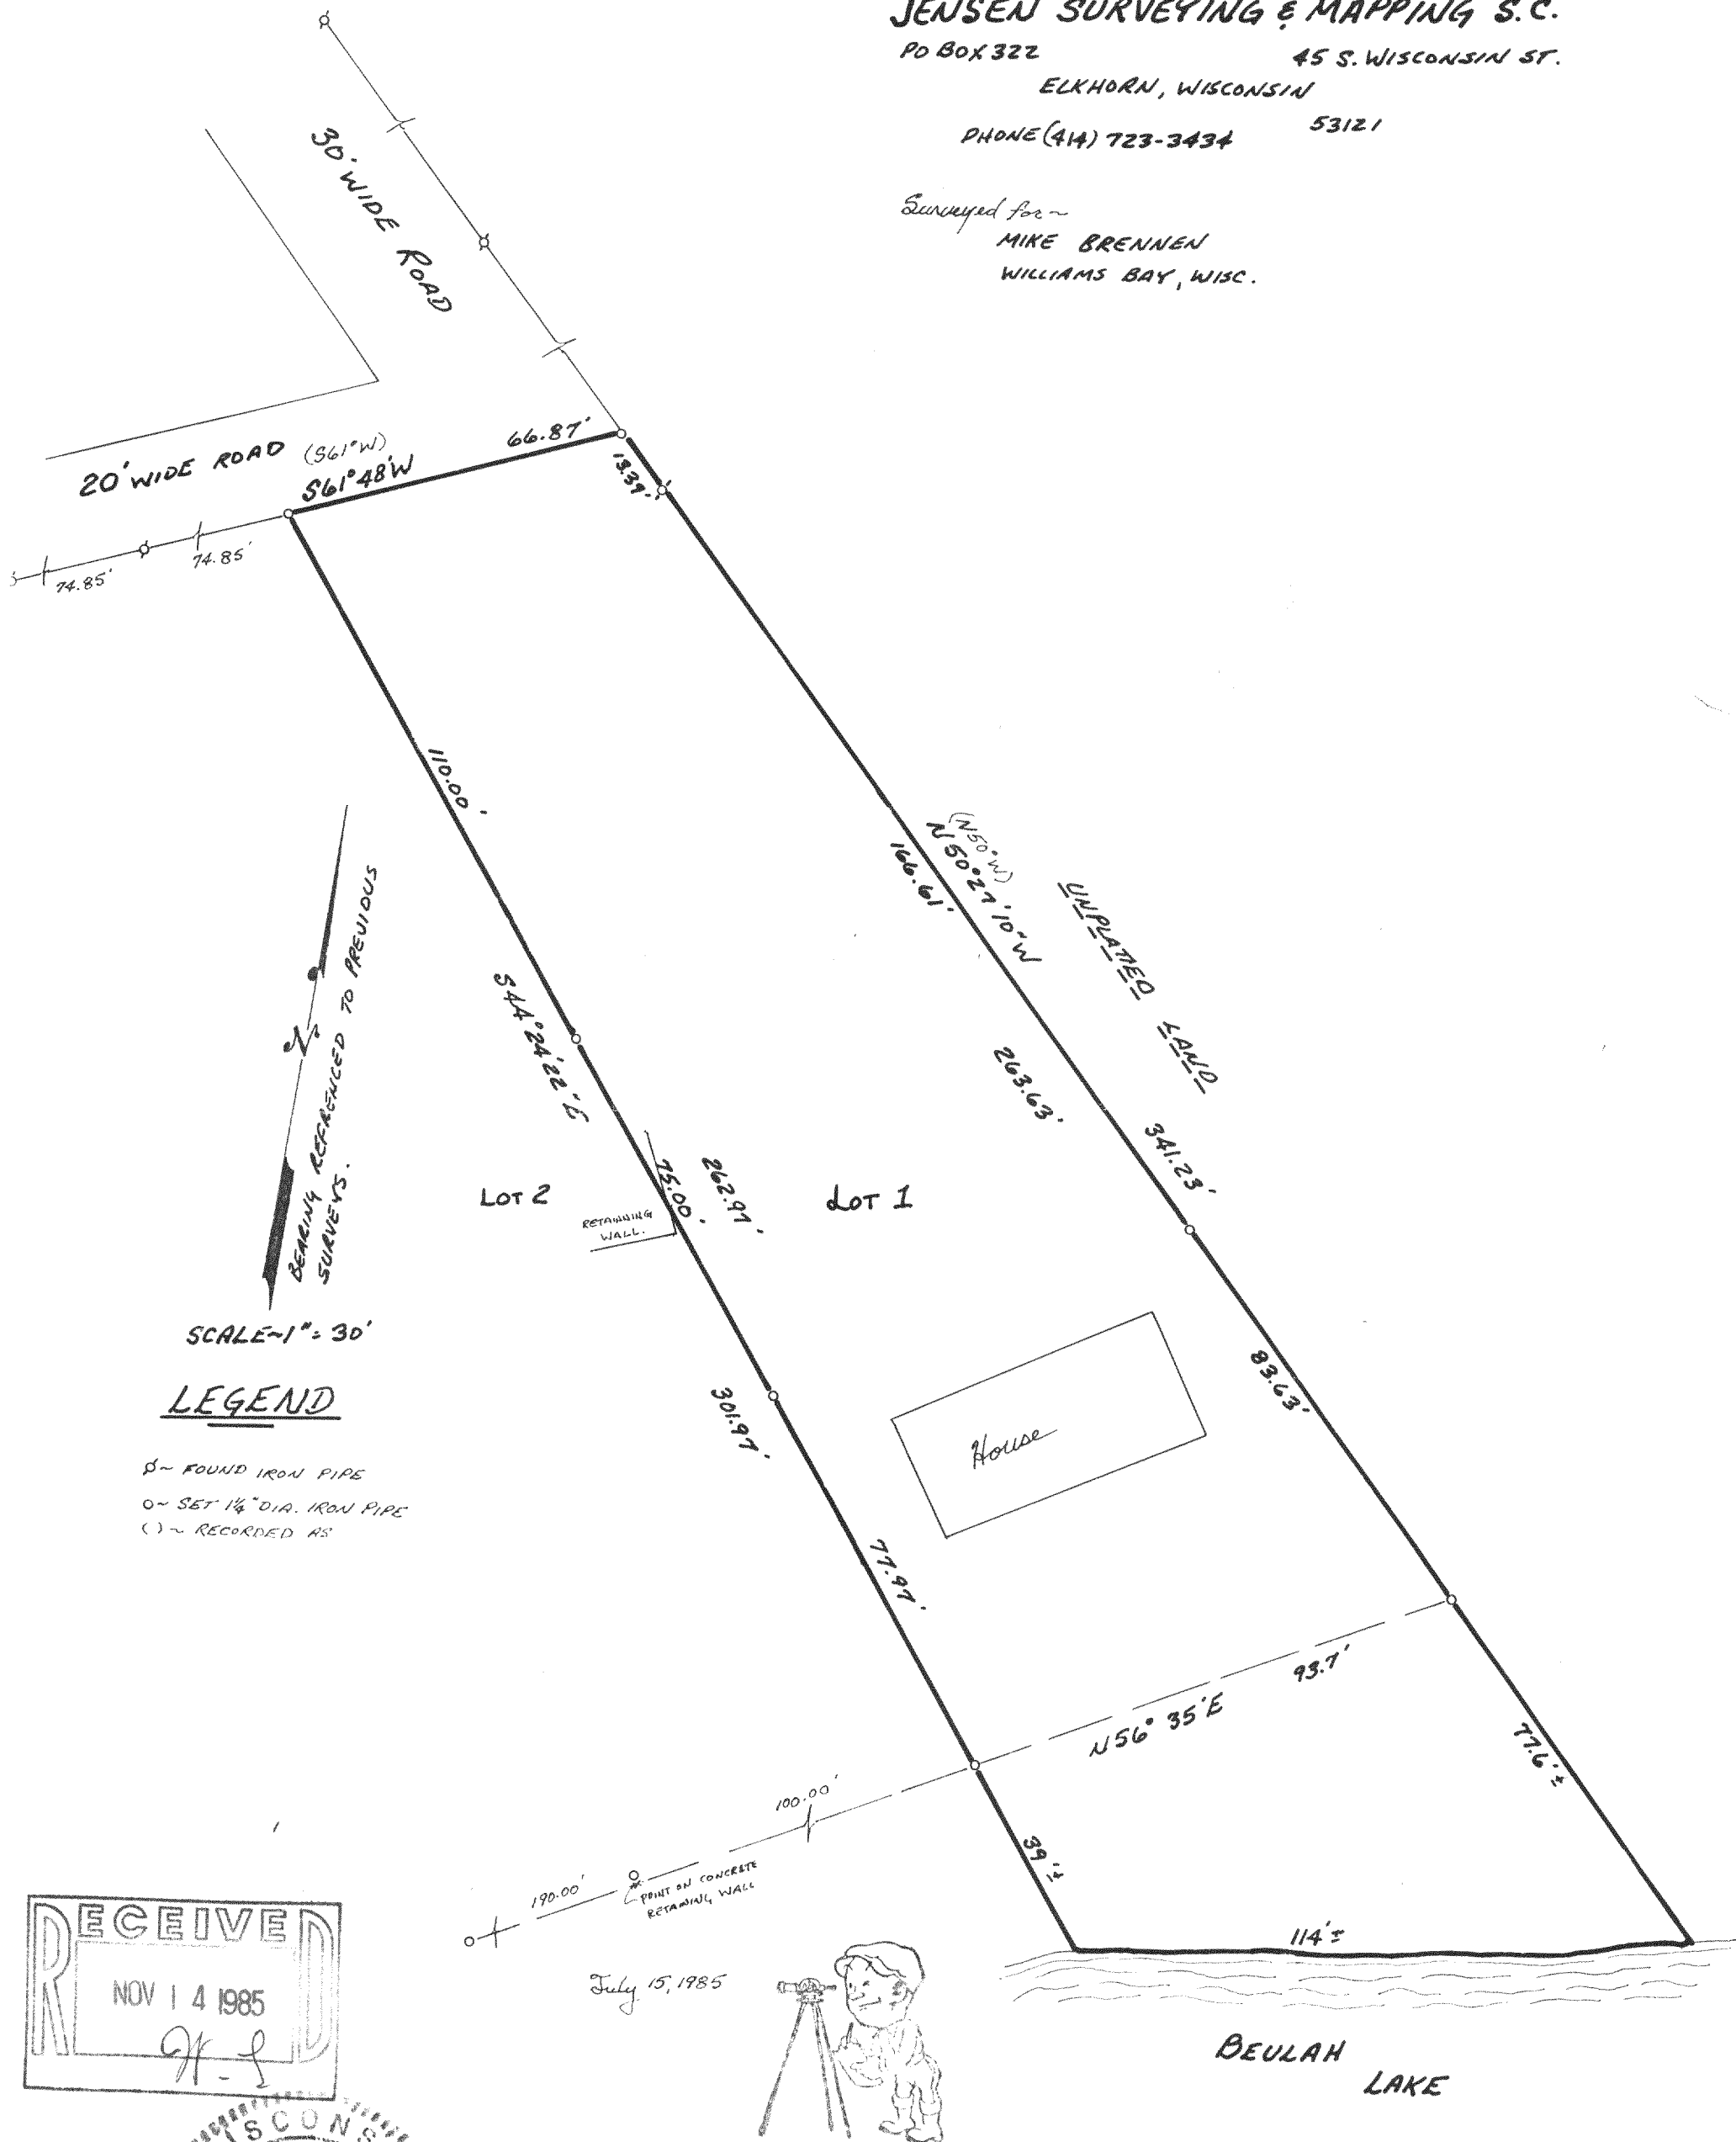

I, THOMAS P.A. JENSEN, WIS. REGISTERED LAND SURVEYOR, DO HEREBY CERTIFY THAT THIS SURVEY WAS PERFORMED BY ME, OR UNDER MY DIRECTION, IN FULL COMPLIANCE WITH THE OWNER'S/AGENT'S INSTRUCTIONS AND CHAPTER A-ES OF WIS. ADMIN. CODE "MINIMUM STANDARDS FOR PROPERTY SURVEYS"; AND THAT THIS MAP IS AN ACCURATE REPRESENTATION TO THE BEST OF MY KNOWLEDGE AND BELIEF.

Thomas P.A. Jensen
 THOMAS P.A. JENSEN S-1084

418-492

1985.059