
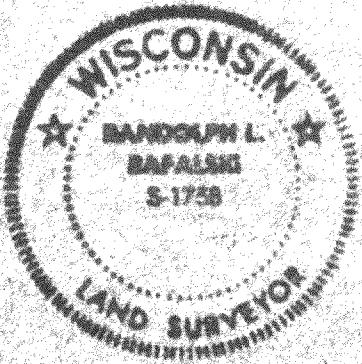
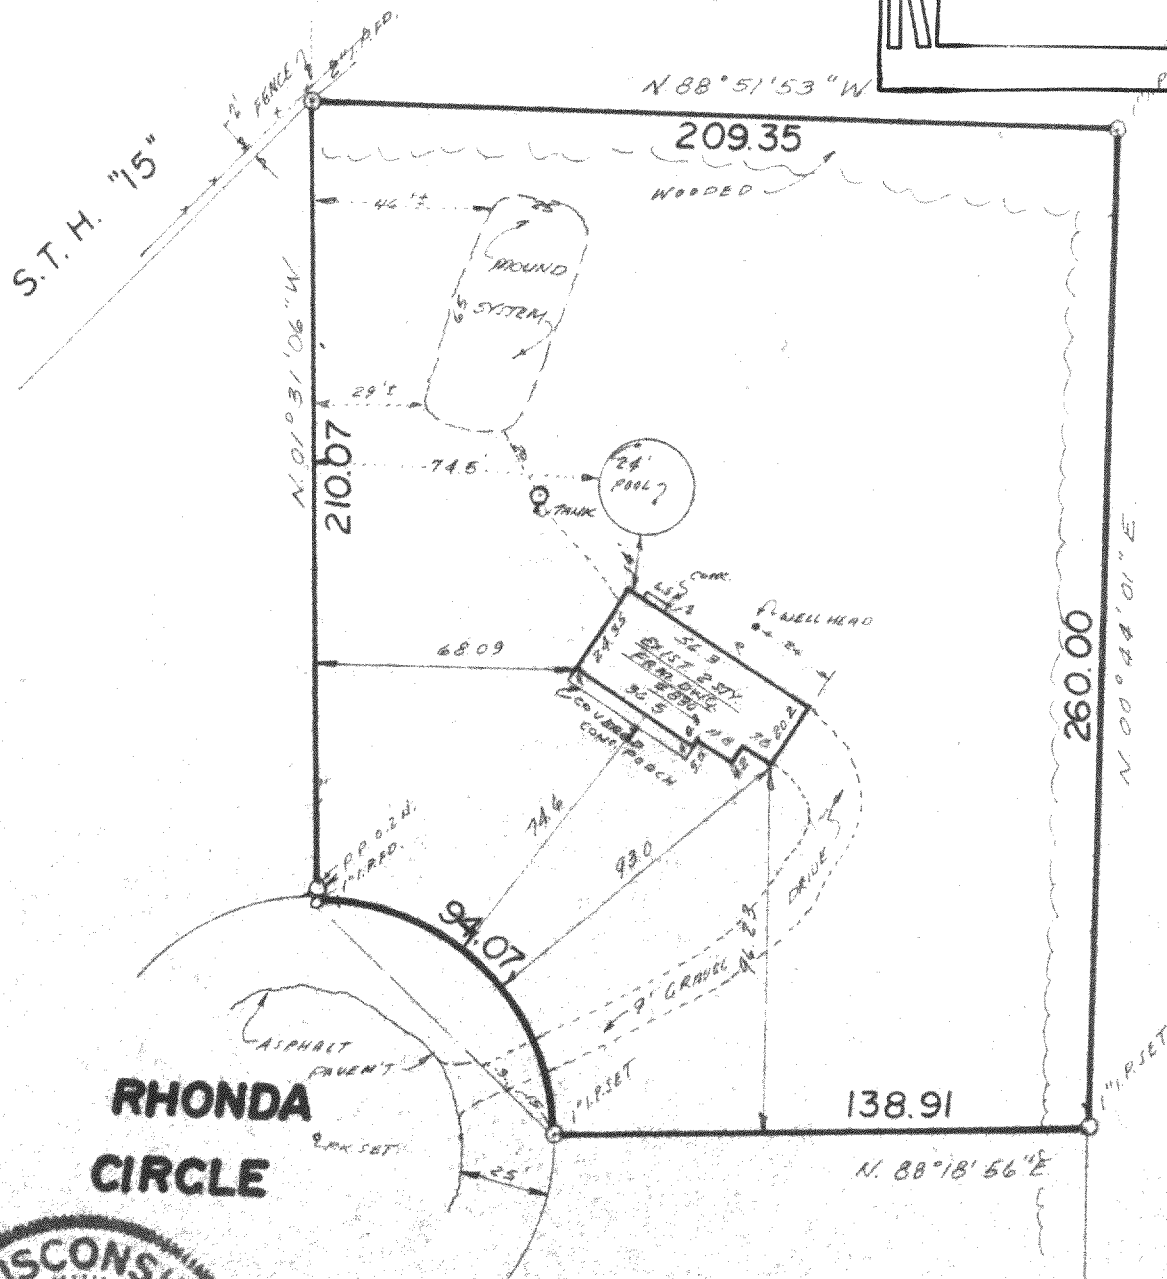


Plat of Survey

Survey For: First State Savings
Location: 830 Rhonda Circle

William B. Mattsen

Description: Parcel 3 of C.S.M. #189, said land being a part of the North East 1/4 of Section 10, in T.4 N., R.18 E., in the Town of East Troy, as recorded on November 17, 1972 in Volume 1 of C.S.M. at page 189, as Document No. 657457.

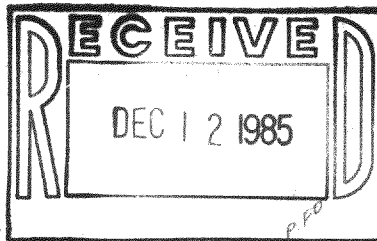

**INMAN SURVEY
& ASSOCIATES, INC.**
11221 W. FOREST HOME AVE.
HALE'S CORNERS, WISCONSIN 53130
PHONE 425-2060

CURVE DATA
RAD = 60.00
CHD = 34.73
 $\Delta = 89^{\circ} 50' 02''$
N $06^{\circ} 26' 05''$ W.

State of Wisconsin) ss
Milwaukee County

SURVEY CERTIFICATE

Scale: 1" = 50'

We, Inman Survey and Associates, Inc., certify that we have surveyed the above described property and the above map is a true representation thereof, and shows the size and location of the property, its exterior boundaries, the location and dimensions of all visible structures thereon, fences, apparent easements and roadways and visible encroachments, if any.

This survey is made for the exclusive use of the present owners of the Property, and also those who purchase, mortgage, or guarantee the title thereto, within one (1) year from date hereof.

Randolph L. Raphael

Wisconsin Registered Land Surveyor

Date: 8-19-85
Job No.: 12212

PA 189-3

418-495