


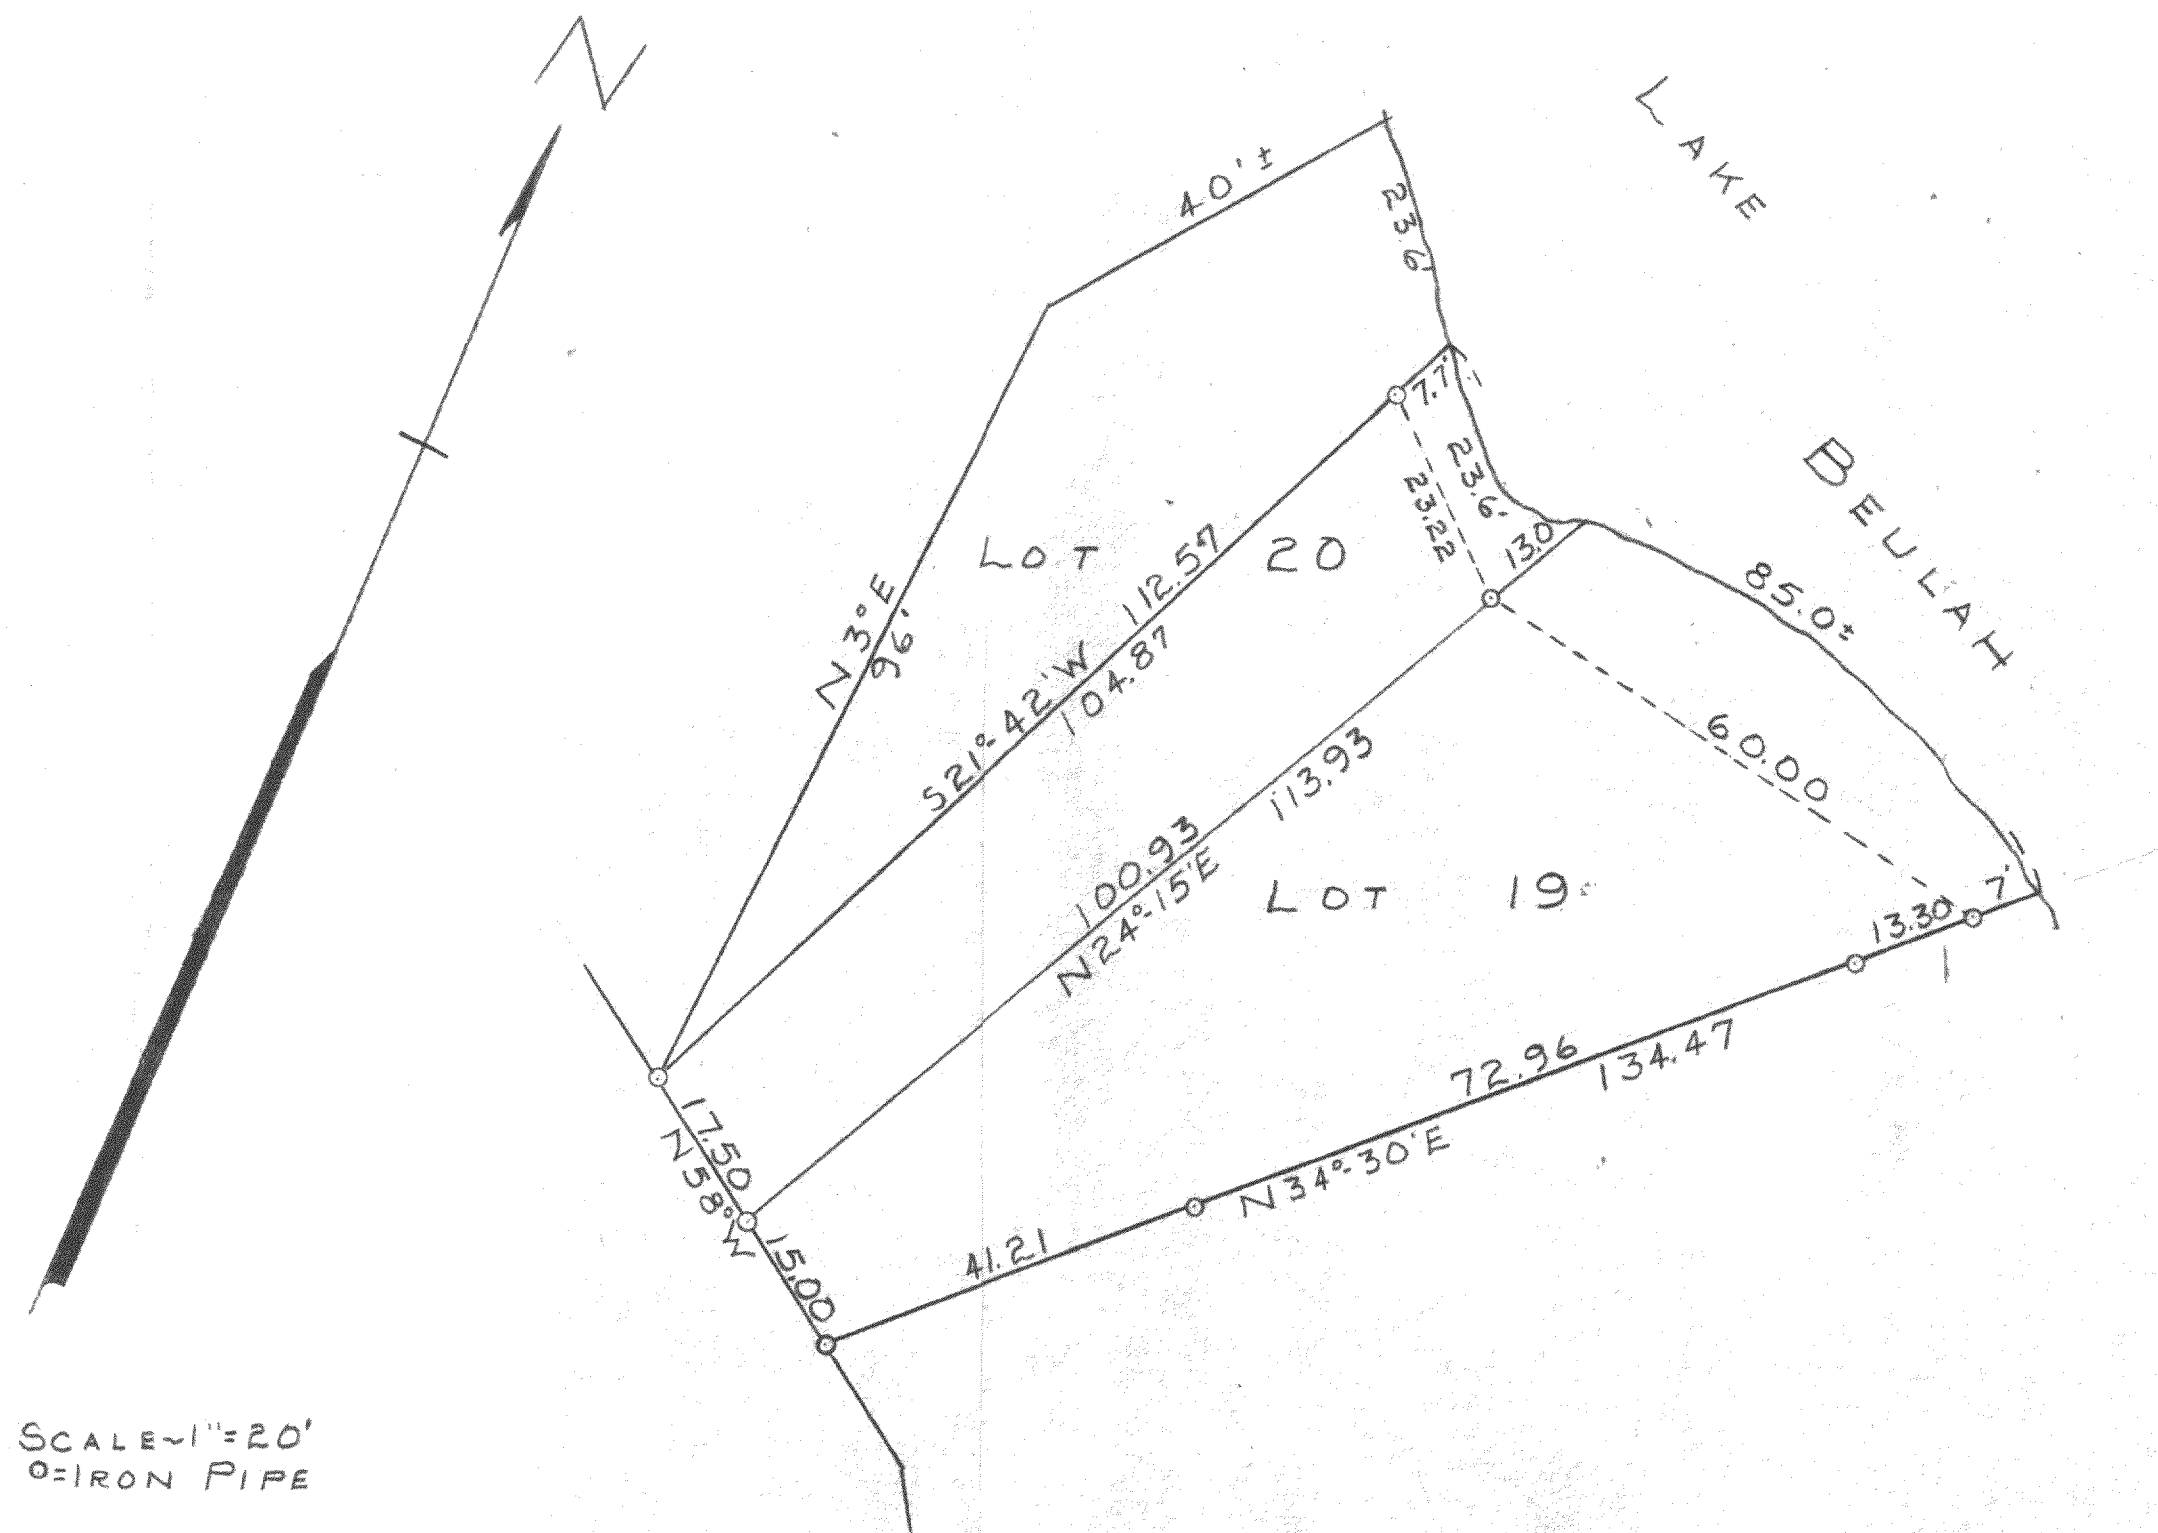

STATE OF WISCONSIN) ss
 COUNTY OF WALWORTH)

I, GEORGE T. DUNHAM, DO HEREBY CERTIFY THAT I HAVE SURVEYED THE
 PROPERTY DESCRIBED AS FOLLOWS:

LOT 19 AND THAT PART OF LOT 20 DESCRIBED AS FOLLOWS, TO WIT: BEGINNING
 AT THE MOST WESTERLY CORNER OF SAID LOT 20; THENCE N 21° 42' E
 112.57 FEET MORE OR LESS TO THE SHORE OF LAKE BEULAH; THENCE SOUTH-
 EASTERLY ALONG THE SHORE OF LAKE BEULAH 23.6 FEET MORE OR LESS TO THE
 SE'LY LINE OF SAID LOT; THENCE S 24° 15' W 113.93 FEET TO THE SE CORNER OF
 SAID LOT; THENCE N 58° W ALONG THE SW'LY LINE OF SAID LOT 17.50 FEET
 TO THE PLACE OF BEGINNING. ALL OF SAID LAND IS LOCATED IN BLOCK 1
 OF WILMER GROVE BEACH, A SUBDIVISION LOCATED IN SECTION 18, T4N R18E
 OF WALWORTH COUNTY, WISCONSIN

AND THAT THERE ARE NO ENCROACHMENTS ON SAID PROPERTY, AND THAT THE
 ABOVE PLAT IS A CORRECT REPRESENTATION OF THE PROPERTY LINES
 JULY 15, 1955

George T. Dunham
 GEORGE T. DUNHAM, SURVEYOR
 DELAVAN, WISCONSIN

W W- 15
 W W- 16

418-5