


ABERNATHY and ASSOCIATES

Kenneth B. Abernathy Jr.

Wisconsin Registered Land Surveyor S-1594

Rt. 3, Box 273
Elkhorn, Wisconsin 53121
Phone (414) 723-4260 (office)
(414) 723-1877 (residence)

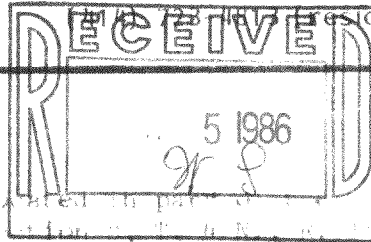

PLAT OF SURVEY


Part of Lots 13 and 14 of Romadka Park Subdivision being located in the Northeast 1/4 of Section 5, and part of the Northeast 1/4 of Section 6, Twp. 14 N., R. 12 E., S. 1 W., Walworth County, Wisconsin.

LEGAL DESCRIPTION: recorded in Volume 295 Page 873 as document No. 10000

Ordered by: Bob McKillop
2120 Rueben Dr.
Waukesha, WI. 53186

Owner: Harold Norling
2464 Byrnes Lane
Mukwonago, WI. 53140

Note: Set railroad spikes in Blacktop Driveway on west line of parcel. Owner to the north states that owners agreed mutually on the location of driveway and existing retaining wall.
South line of parcel is recorded as N 81° W 277' but was found to be monumented as indicated.

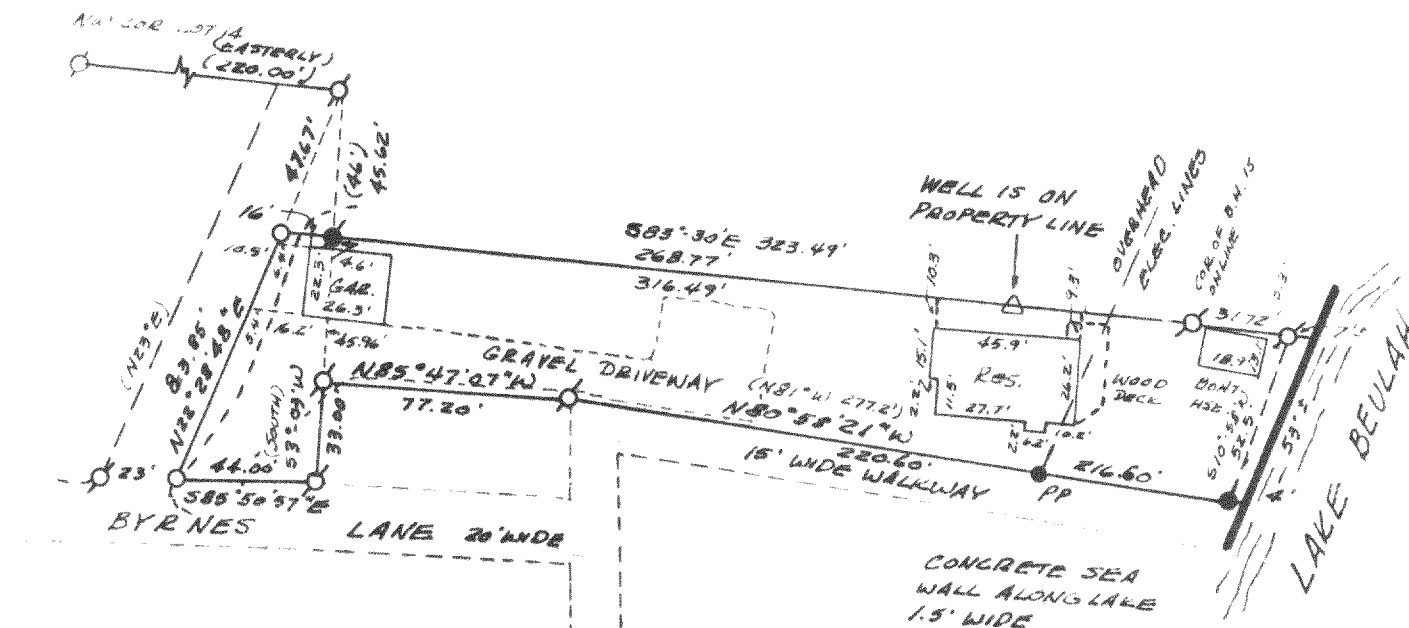

BEARINGS ARE BASED ON RECORDED LEGAL DESCRIPTION AND ASSUME THE NORTH LINE TO BEAR S 83° 30' E



Legend

- FOUND IRON PIPE
- FOUND IRON ROD
- FOUND BRASS CAPPED MONUMENT
- * FOUND CONCRETE MONUMENT
- + CHISEL CUT IN CONCRETE
- SET IRON ROD, 24" LONG, WEIGHING 1.5 LBS./LINEAL FT., 3/4" DIA.
- SET IRON ROD, 30" LONG, WEIGHING 4.5 LBS./LINEAL FT., 1-11/16" DIA.
- (xx) RECORDED AS DIMENSION
- x-x- EXISTING FENCE
- PP- POWER POLE

SCALE: 1" = 60 FEET

"I hereby certify that I have surveyed the above described property and that the above map is a true representation thereof and shows the size and location of the property, its exterior boundaries, the location of all visible structures and dimensions of all principal buildings thereon, boundary fences, apparent easements, roadways and visible encroachments, if any."

"This survey is made for the use of the present owners of the property, and also those who purchase, mortgage, or guarantee the title thereto within one year from date hereof."

Kenneth B. Abernathy Jr.


KENNETH B. ABERNATHY, JR.
WISCONSIN REGISTERED LAND SURVEYOR,
S-1594

Date: 4-17-86 Job No. 408

4-17-86

418-513

SURVEYING

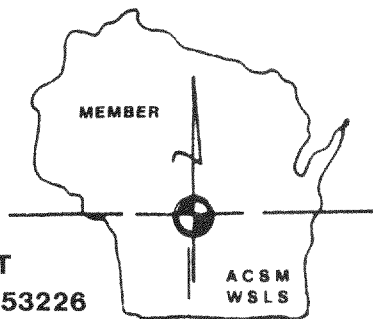

ASSOCIATES, INC.

2554 N. 100th STREET
WAUWATOSA, WISCONSIN 53226

FREDERICK W. SHIBILSKI RLS
(414) 257-2212

PLAT OF SURVEY
-of-


That part of the Northwest 1/4 of Section 7, T4N, R18E, in the Town of East Troy, Walworth County, Wisconsin bounded and described as follows:

Commencing at the West 1/4 corner of said Section; thence N 89° 06' 03" East along the South line of said 1/4 Section 1036.08 feet to the point of beginning; continuing thence N 89° 06' 03" East along the South line of said 1/4 Section 240.00 feet to a point being the Southwest corner of the Southeast 1/4 of said 1/4 Section; thence N 01° 11' 45" West along the West line of the East 1/2 of said 1/4 Section, 658.68 feet to a point; thence N 37° 44' 30" West 393.77 feet to a point in the centerline of a proposed road; thence S 47° 11' 00" West along the center line of a proposed road 290.68 feet to a point; thence S 16° 22' 23" East 808.93 feet to the point of beginning. Also known as Lot 7 of Fisherman's Wharf.

Also an easement for ingress over the following described land: That part of the Northwest 1/4 of Section 7, T4N, R18E, in the Town of East Troy, Walworth County, Wisconsin, bounded and described as follows:

Commencing at the West 1/4 corner of said Section; thence N 89° 06' 03" East, along the South line of said 1/4 Section; 33.00 feet to a point in the East line of Booth Lake Road; thence N 0° 49' 00" West, parallel to the West line of said 1/4 Section, 570.95 feet to the point of beginning; thence N 89° 11' 00" East 442.00 feet to a point of curve; thence Northeasterly along a curved line (having a radius of 418.00 feet with its center to the North and a chord 306.41 feet in length which bears N 68° 11' 00" East), an arc distance of 306.41 feet to a point of tangency; thence N 47° 11' 00" East, 404.16 feet to a point of curve; thence Northeasterly along a curved line (having a radius of 66.00 feet with its center to the Southeast and a chord 66.00 feet in length which bears N 77° 11' 00" East), an arc distance of 69.12 feet to a point of curve; thence Northwesterly along a curved line (having a radius of 66.00 feet with its center to the Northeast and a chord 114.32 which bears N 12° 49' 00" West), an arc distance of 276.46 feet to a point of tangency; thence S 47° 11' 00" West 518.48 feet to a point of curve; thence Southwesterly along a curved line (having a radius of 352.00 feet with its center to the Northwest and a chord 252.99 feet in length which bears S 68° 11' 00" West), an arc distance of 258.03 feet to a point of tangency; thence S 89° 11' 00" West, 442.00 feet to a point in the East line of Booth Lake Road; thence S 0° 49' 00" East parallel to the West line of said 1/4 Section, 66.00 feet to the point of beginning.

Survey location: 3261 Valley Road
Buyer: Michael & Joyce Kastern

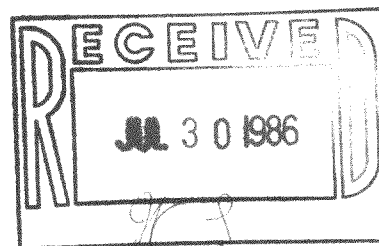

Surveyed for: AMERICAN MORTGAGE CORP. of WISC.

"I hereby certify that I have surveyed the above described property and that the above map is a true representation thereof and shows the size and location of the property, its exterior boundaries, the location of all visible structures and dimensions of all principal buildings thereon, boundary fences, apparent easements, roadways and encroachments, if any.

"This survey is made for the use of the present owners of the property, and also those who purchase, mortgage, or guarantee the title thereto within one year from date hereof."

MONUMENTATION BY WRITTEN AGREEMENT WITH THE ABOVE NAMED CLIENT (HAS BEEN) BEEN WAIVED IN ACCORDANCE WITH A-E 5.01 (1) (b) OF THE WISCONSIN ADMINISTRATIVE CODE



"THIS IS NOT AN ORIGINAL SURVEY UNLESS THIS SEAL IS RED."

SHEET 2 of 2

WISCONSIN REGISTERED LAND SURVEYOR

MAR. 25, 1986
DATE

dif, bjk
FIELD WORK BY

dif
DRAWN BY

10936
JOB NUMBER

414 512-15