

Lyons Mortgage
Daniel & Jeanne Breidenbach



PLAT OF SURVEY

LOCATION: 314 Horseshoe Lane, East Troy, Wisconsin

LEGAL DESCRIPTION: Lot 38 in FAIRWAY SUBDIVISION, being a re-subdivision of part of Williams Park Subdivision, located in the SW 1/4, NE 1/4 and the SE 1/4 of the NW 1/4 of Section 4, Town 4 North, Range 18 East, in the Town of East Troy, Walworth County, Wisconsin.

August 26, 1986

Survey No. 68533

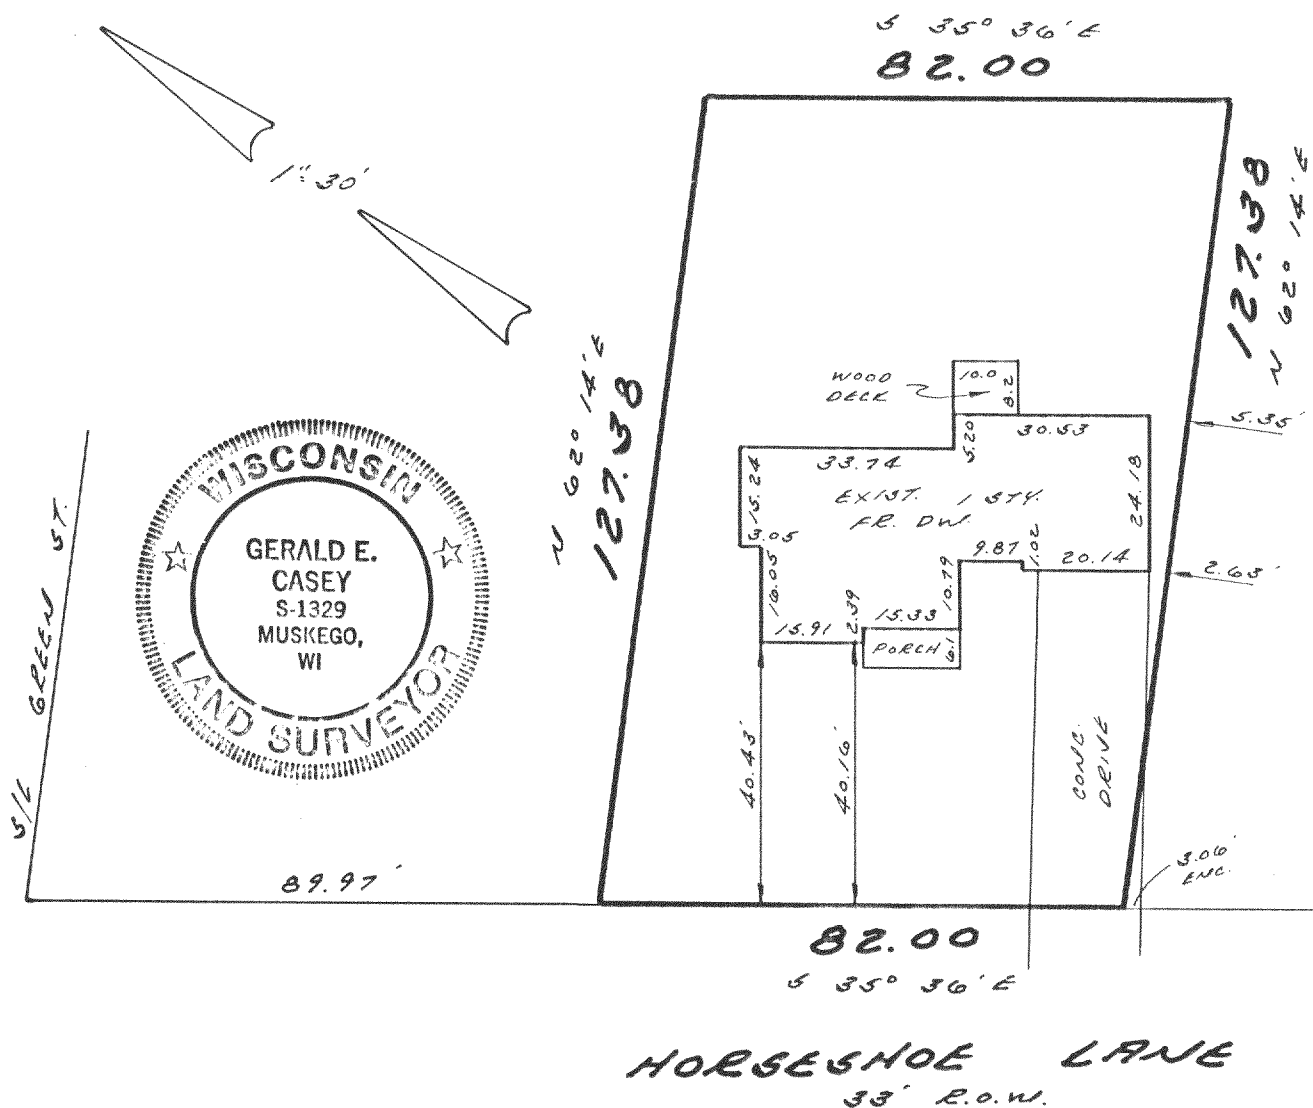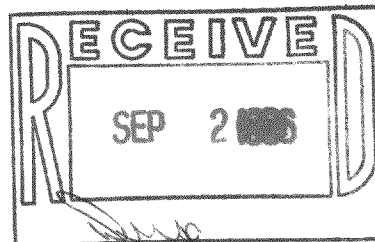

METROPOLITAN SURVEY SERVICE, INC.

REGISTERED LAND SURVEYORS

115 W. FOREST HOME AVE., SUITE 107 HALES CORNERS, WI 53130
529-5380

Mortgage Inspection

Monumentation has been waived in accordance with A-5 5.01 (b) of the Wisconsin Administrative Code.

PF-38

I HEREBY CERTIFY THAT I HAVE SURVEYED THE ABOVE DESCRIBED PROPERTY AND THAT THE ABOVE MAP IS A TRUE REPRESENTATION THEREOF AND SHOWS THE SIZE AND LOCATION OF THE PROPERTY, ITS EXTERIOR BOUNDARIES, THE LOCATION OF ALL VISIBLE STRUCTURES AND DIMENSIONS OF ALL PRINCIPAL BUILDINGS THEREON, BOUNDARY FENCES, APPARENT EASEMENTS AND ROADWAYS AND VISIBLE ENCROACHMENTS, IF ANY.

THIS SURVEY IS MADE FOR THE EXCLUSIVE USE OF THE PRESENT OWNERS OF THE PROPERTY, AND ALSO THOSE WHO PURCHASE, MORTGAGE, OR GUARANTEE THE TITLE THERE TO WITHIN ONE (1) YEAR FROM DATE HEREOF.

SIGNED

Gerald E. Casey
Registered Land Surveyor S-1329