



Date April 17, 1985

PLAT OF SURVEY

Job No. Z-11-32106

LOT 6 and the North 1/2 of LOT 7 - BLOCK 16 - MIRAMAR
being a subdivision of a part of the East-1/2 of Section 10, and the West
1/2 of Section 11, Town 4 North, Range 18 East, Town of East Troy, Walworth
County, Wisconsin.

Located at 930 Pine Street

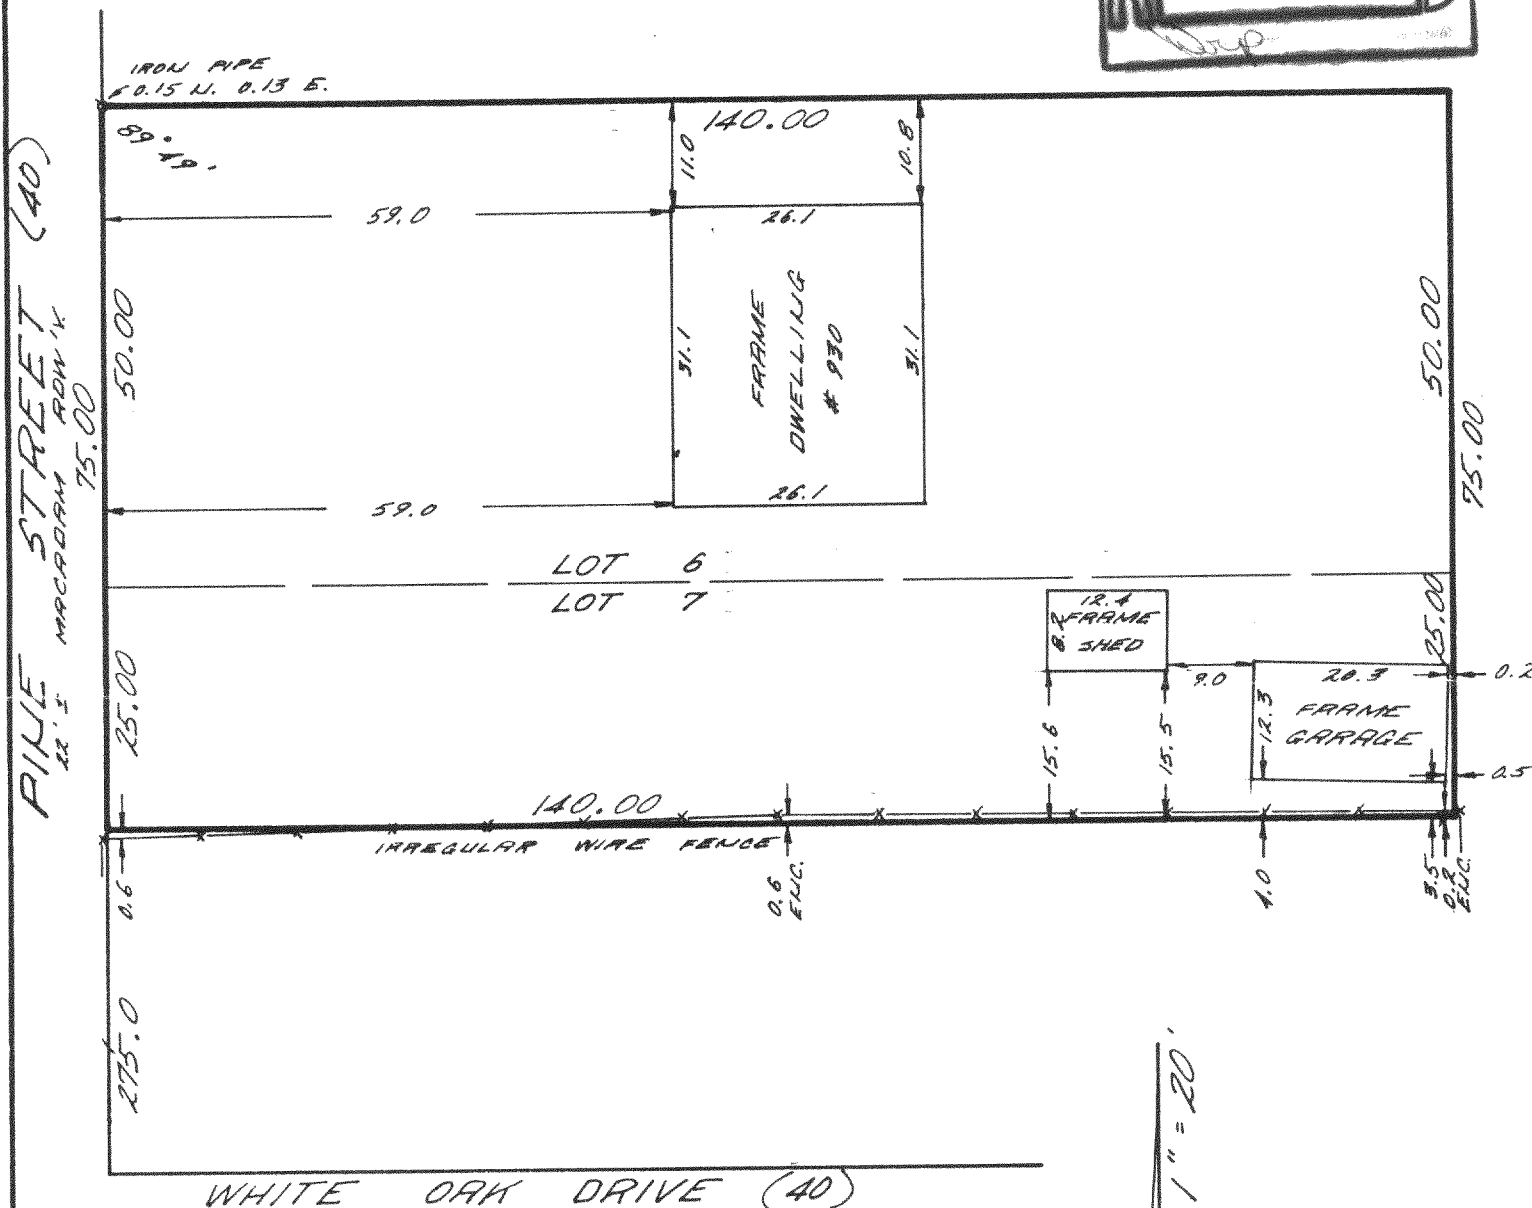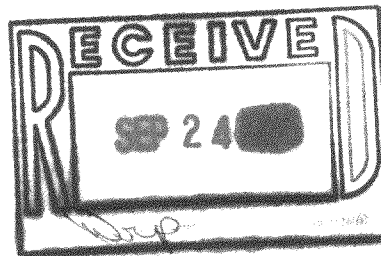

In accordance with Chapter A-E 5.01b, a signed agreement
is on file waiving the setting of monuments on the
property.

Owner: Bruce and Roberta Meyers

✕ - FOUND IRON PIPE

o - SET IRON PIPE

8522 West Lisbon Avenue
Milwaukee, Wisconsin 53222

SURVEYED FOR

Wauwatosa Mortgage Co.
2525 N. 124th Street
Brookfield, WI. 53005

LANDMARK SURVEYING CO.

I, Richard J. Lammi, surveyed the above described prop-
erty, and the above map is a true representation thereof
and shows the size and location of the property, its
exterior boundaries, the location and dimensions of
all visible structures thereon, fences, apparent ease-
ments, roadways and visible encroachments.

This survey is made for the exclusive use of the present
owners of the property; also those who purchase, mort-
gage or guarantee the title thereto, within one year
from date hereof.

Richard J. Lammi

REGISTERED LAND SURVEYOR NO. 5-777 - STATE OF WISCONSIN

PHONE
461-3730



PMR-188A