

Plat of Survey

of Lots 13, 14, and 15 of Block 15 of Miramar Subdivision,
Located in the N.W. $\frac{1}{4}$ of Section 11, T4N, R18E, Walworth
County, Wisconsin.


Description of Parcel 1.

Lot 15 and the North half of Lot 14, Block 15, Miramar Subd.


Description of Parcel 2.

Lot 13 and the South half of Lot 14, Block 15, Miramar Subd.

Owner: James Biagi
5400 Ocean Blvd. 20
Ft. Lauderdale, Flo. 33308

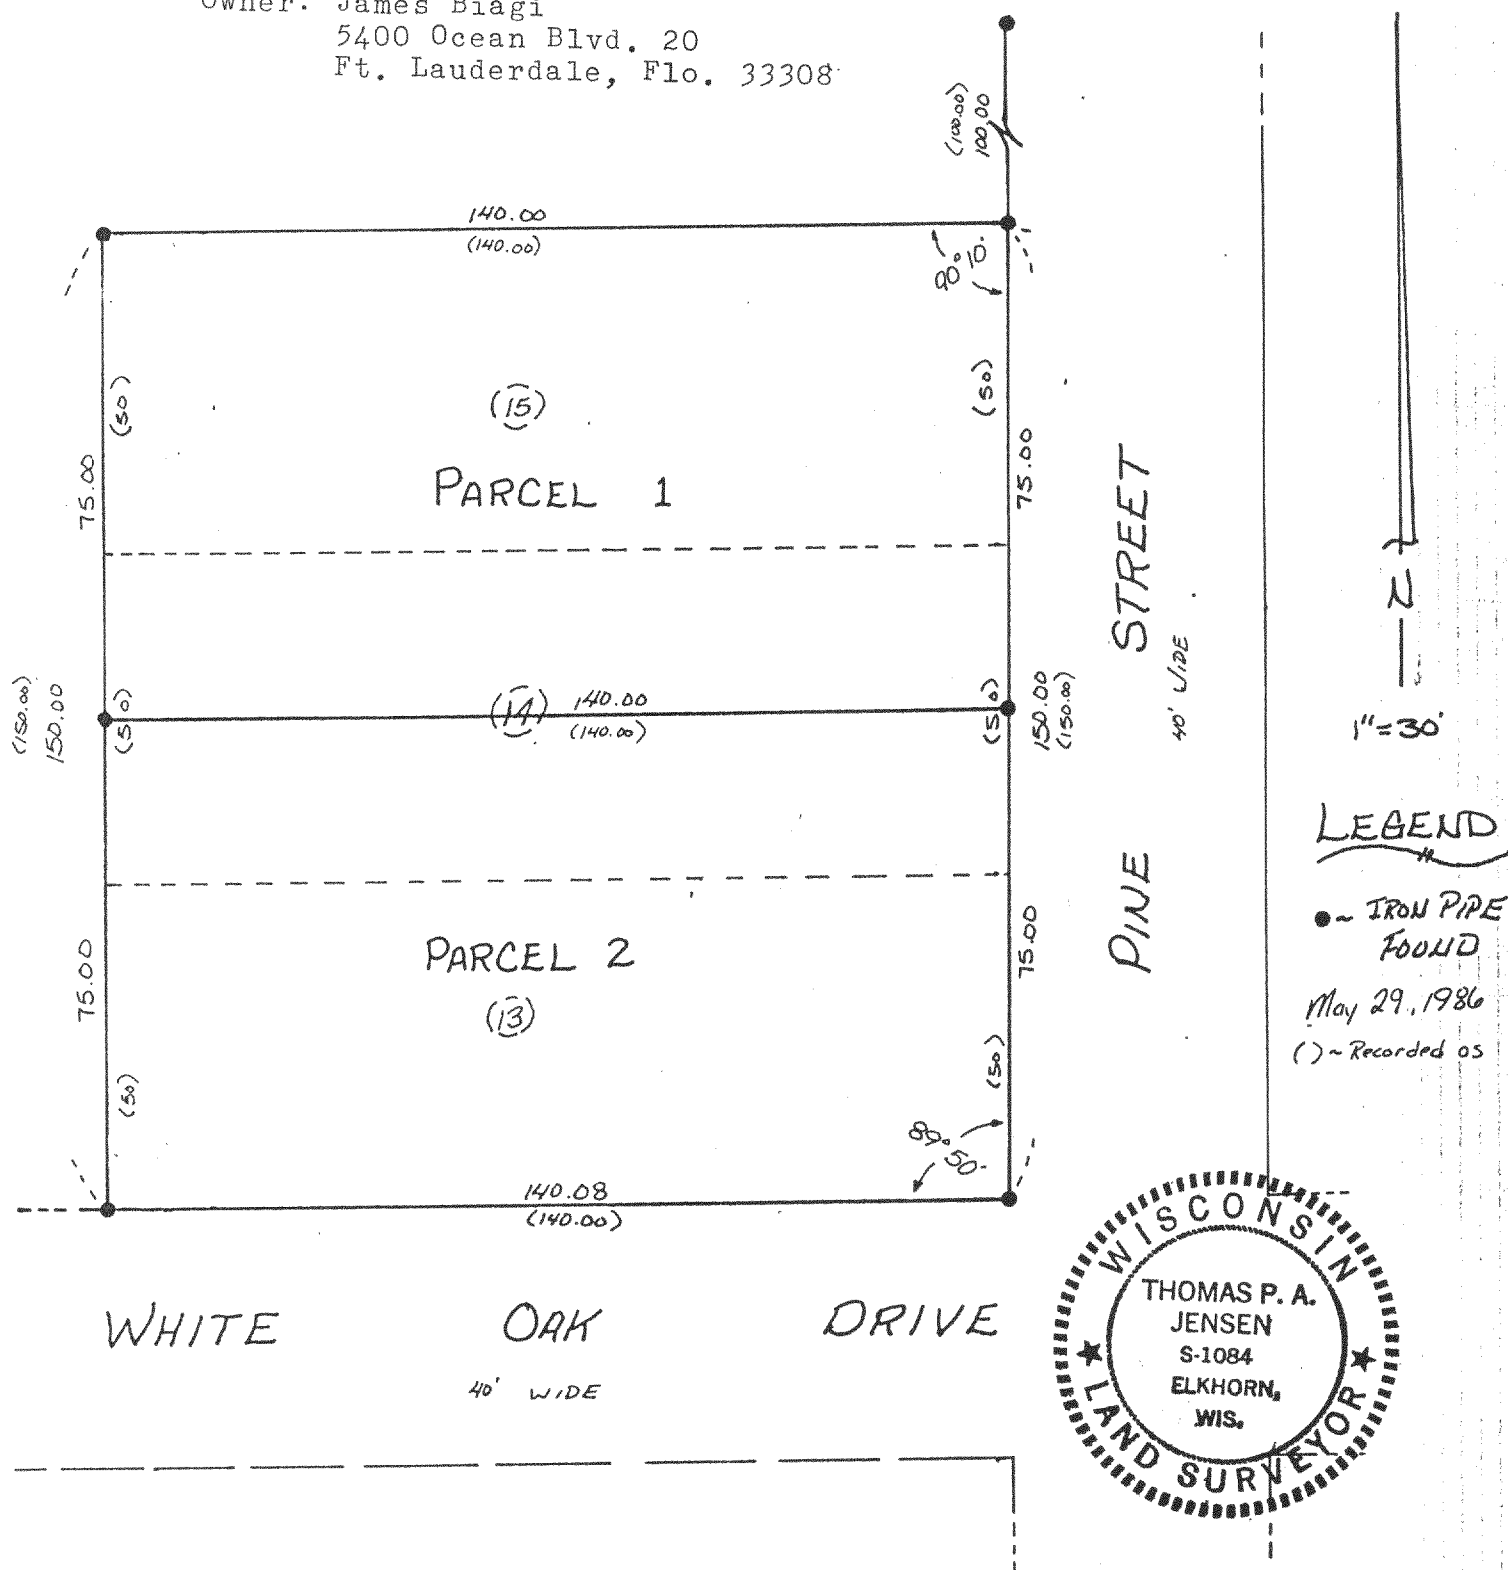

I, Thomas P.A. Jensen, Wisconsin Registered Land Surveyor, do hereby certify that this survey was performed by me, or under my direction, in full compliance with the owner's/agent's instructions and chapter A-E 5 of the Wisconsin Administrative Code "Minimum Standards For Property Surveys"; and that this map is an accurate representation thereof to the best of my knowledge and belief.

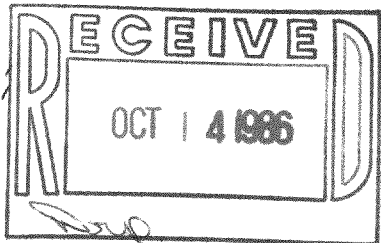

James Biagi *Thomas P. A. Jensen*

Thomas P.A. Jensen S-1084
Jensen Surveying & Mapping S.C.
45 S. Wisconsin St.
Elkhorn, Wisconsin. 53121
(414) 723-3434

1986.043 X 418-539