


PLAT OF SURVEY

OF A PARCEL OF LAND LOCATED IN THE N.E. 1/4 AND THE N.W. 1/4
OF SECTION 10, TOWN 4 NORTH, RANGE 18 EAST, WALWORTH CO., WISCONSIN.

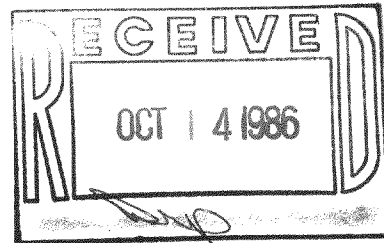


SURVEYED BY: JENSEN SURVEYING & MAPPING S.C.
PO. Box 322 - ELKHORN, WI. 53121

SURVEYED FOR: JOHN & OLGA BOCK
520 SANDEES ROAD
DEERFIELD, ILL. 60015

MAPPING DATE: MARCH 10, 1986


North 1/4 Section 10
Town 4 North, Range 18 East
(552.63)

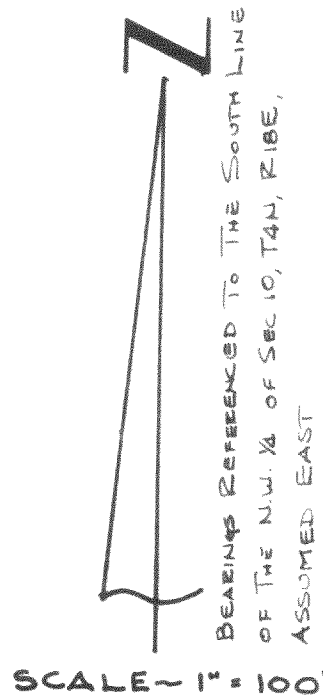

- IRON PIPE FOUND
- CONCRETE MONUMENT FOUND
- 3/4" DIA. IRON REBAR FOUND
- 3/4" DIA. IRON REBAR SET
- () RECORDED AS

I, Thomas P.A. Jensen, Wisconsin Registered Land Surveyor, do hereby certify that this survey was performed by me, or under my direction, in full compliance with the owner's/agent's instructions and chapter A-E 5 of the Wisconsin Administrative Code "Minimum Standards For Property Surveys"; and that this map is an accurate representation thereof to the best of my knowledge and belief.

Thomas P.A. Jensen S-1084
Jensen Surveying & Mapping S.C.
45 S. Wisconsin St.
Elkhorn, Wisconsin. 53121
(414) 723-3434

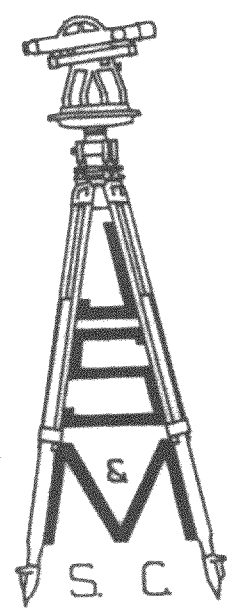

CERTIFIED SURVEY MAP NO. 1379
STATE TRUNK HIGHWAY "15"

33.67 ACRES

West 1/4 Corner
Town 4 North, Range 18 East

EAST

Center of Section 10
Town 4 North, Range 18 East
DEED - 200 1/2 RECS

UNPLATTED LAND

East 1/4 Corner
Section 10, Town 4 North, Range 18 East

DESCRIPTION

A parcel of land located in the N.W. 1/4 and the N.E. 1/4 of Section 10, T4N, R18E, Walworth County, Wisconsin, described as follows:

Commence at the West 1/4 corner of said Section 10; thence East, along the South Line of the N.W. 1/4 of said Section, 2001.46 feet to the East Line of State Trunk Highway "15" and the point of beginning of the land hereinafter described; thence N29°04'06"E, along the said East Line, 575.85 feet; thence N34°46'44"E, along said East Line, 301.50 feet; thence N29°04'06"E, along said East Line, 693.19 feet to the beginning of the arc of a curve to the right whose chord bears N33°11'11"E 795.614 with a radius of 5539.58 feet with a central angle of 8°14'10"; thence 796.299 feet to the South Line of Miramar Road (140' wide); thence N89°47'51"E, along said South Line, 85.72 feet to the West Line of Block 22 of Miramar Addition No. 1. (a subdivision located in the aforesaid N.E. 1/4); thence S0°27'44"E, along said West Line, 1306.95 feet to an angle point in the said West Line; thence S0°15'56"E, along the said West Line of said Block 22, 719.20 feet to the South Line of the N.E. 1/4 of said Section 10; thence N89°43'56"W, along the said South Line of the N.E. 1/4, 668.58 feet to the Center of said Section 10; thence West, along the South Line of the N.W. 1/4 of said Section 10, 655.06 feet to the point of beginning. Parcel contains 33.67 acres of land, more or less.

NOTE: THE ABOVE DESCRIPTION WAS DRAFTED FROM A PLAT OF SURVEY DATED 3/10/86. THE SURVEY WAS MADE BY JENSEN SURVEYING & MAPPING S.C. AND IS ON FILE AT THE WALWORTH COUNTY COURT HOUSE.

1984.021