

Plat of Survey

SITUATED ON LAKE DRIVE, IN THE VILLAGE OF EAST TROY, WISCONSIN.
LOT 2 IN BLOCK 1 IN SKONEY'S SUBDIVISION, BEING A SUBDIVISION OF A PART OF THE SE 1/4
OF THE SW 1/4 AND THE SW 1/4 OF THE SE 1/4 OF SECTION 10, T 4 N, R 18 E, IN THE
VILLAGE OF EAST TROY, WALWORTH COUNTY, WISCONSIN.

OCTOBER 24, 1986


RALPH AND ARVILLA STASZAK

SURVEY NO. 151134-S

SET IRON
PIPE


POTTERS
LAKE

FOUND
IRON PIPE

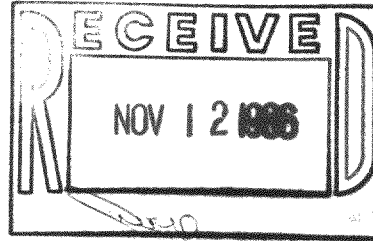

WELL CAP

SCALE-1"=30'-00"

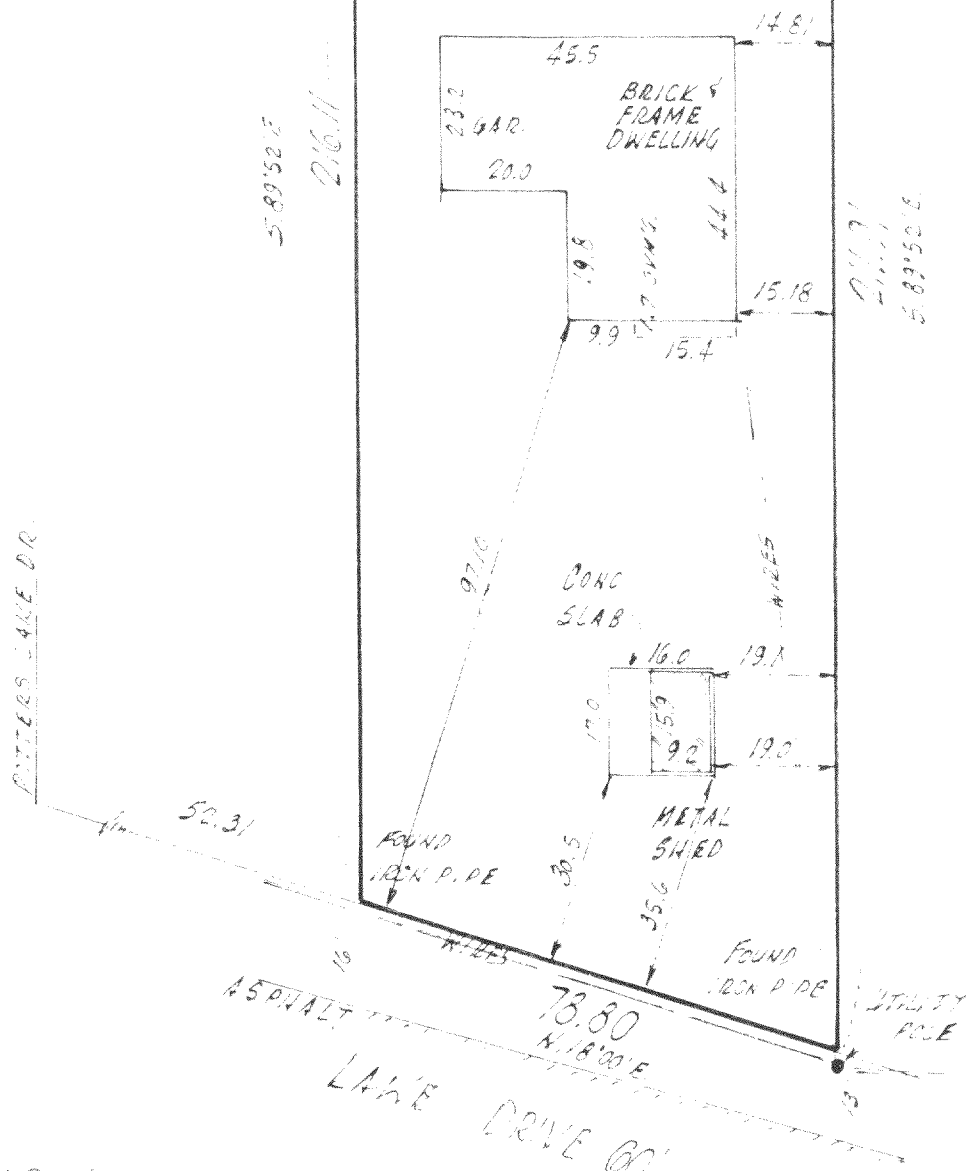


I Certify that I have surveyed the above described property (Property), and the above map is a true representation thereof and shows the size and location of the Property, its external boundaries, the location and dimensions of all visible structures thereon, boundary fences, apparent easements and roadway, and visible encroachments, if any.

This survey is made for the exclusive use of the present owners of the Property and also those who purchase, mortgage, or guarantee the title thereto within one (1) year from date hereof.

Kenneth E. Burke
SURVEYOR

THIS ORIGINAL
SURVEY
SEAL IS WARRANTED
TRUE

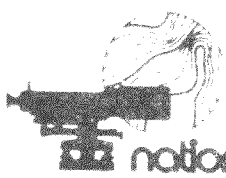

national survey engineering

3470 North 127th Street • P.O. Box 444 • Brookfield, Wisconsin, 53005 • Phone 414 781-1000

PSK-2

418-544