


PLAT OF SURVEY

LOT 3 DUTCHLAND ACRES

LOCATED IN SEC. 21, T.4N., R.18E. TOWNSHIP
OF EAST TROY, WALWORTH COUNTY, WISCONSIN
FOR RUSSEL KNUDSEN

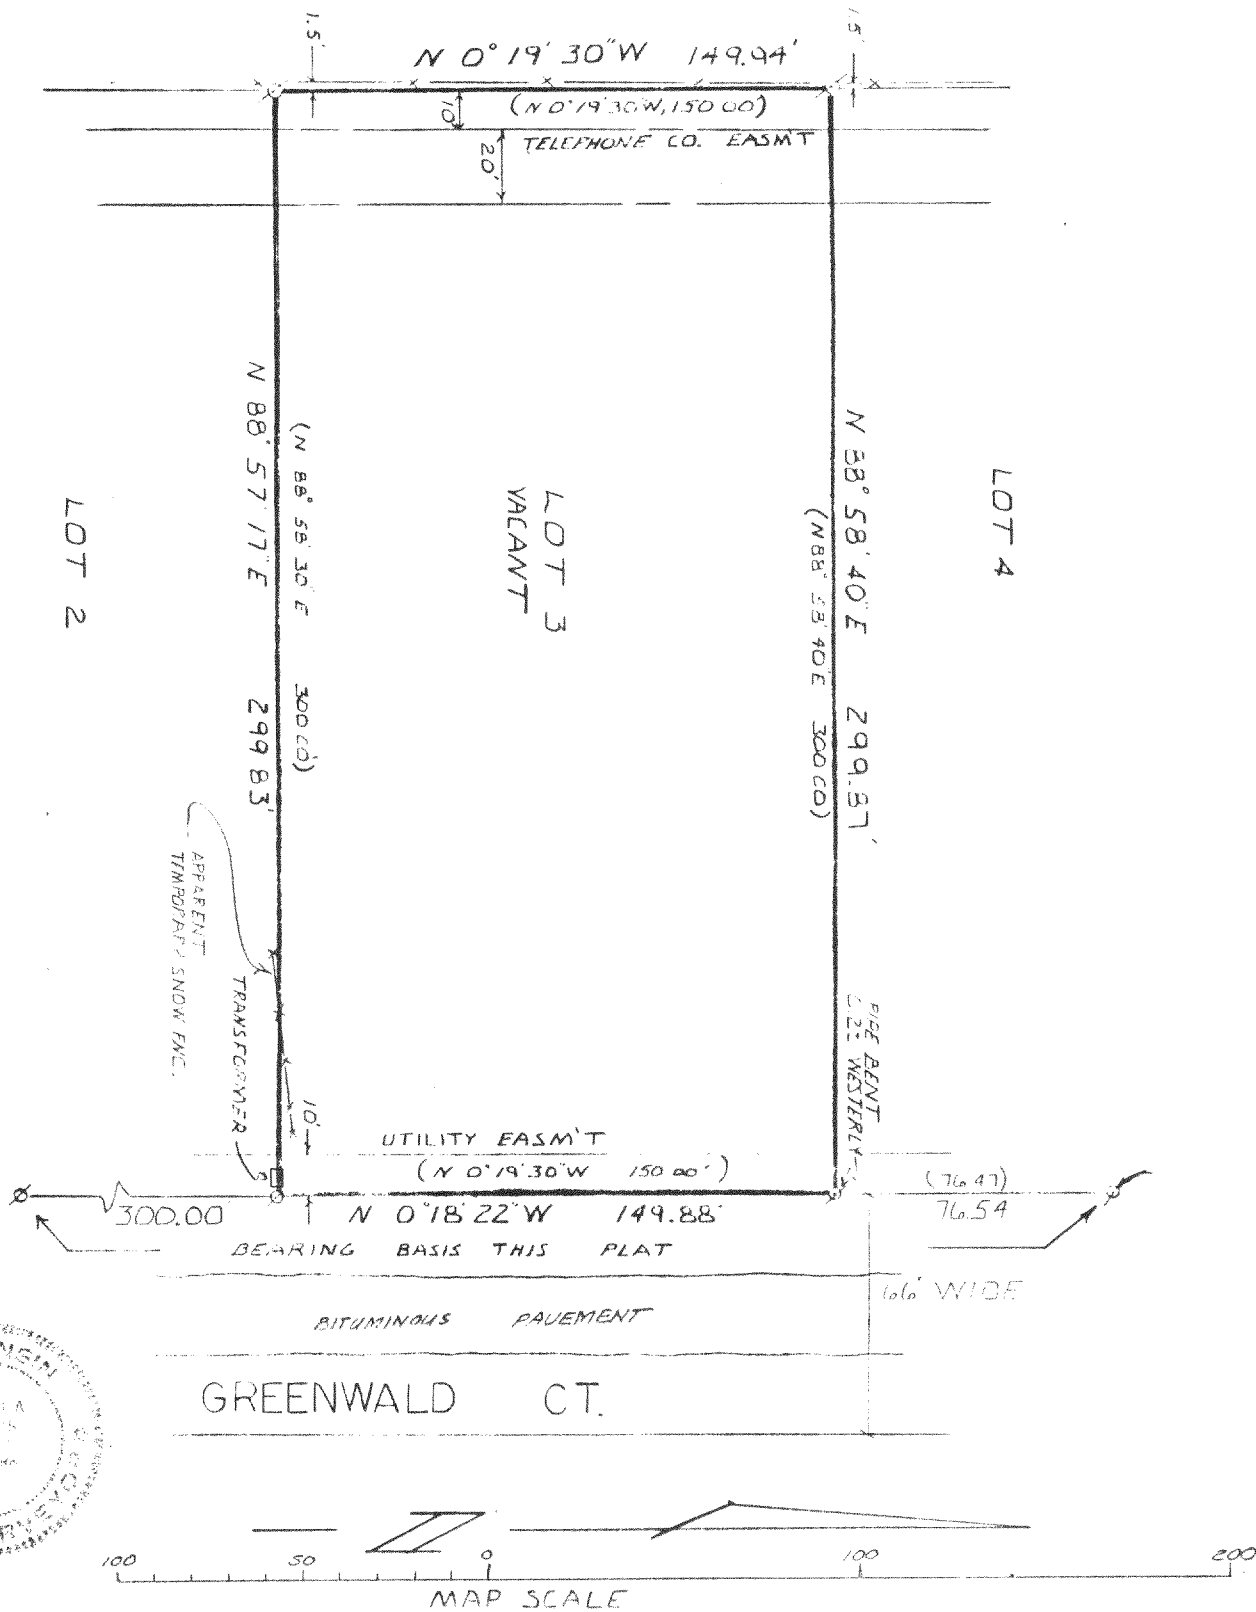

I hereby certify that I have surveyed the above described property and that the above map is a true representation thereof and shows the size and location of the property, its exterior boundaries, the location of all visible structures and dimensions of all principal buildings thereon, boundary fences, apparent easements, roadways and visible encroachments, if any.
This survey is made for the use of the present owners of the property, and also those who purchase, mortgage, or guarantee the title thereto within one (1) year from date hereof.

Q = FOUND PIPE SURVEY STK
(XXX) = RECORDED DIMENSION
X—X—X = FENCE

FARRIS, HANSEN & ASSOCIATES, INC.
7 Ridgeway Ct.
Elkhorn, WI 53121

DATED 03/04/87

PROJECT 2733

418-560