

Surveyed by ~

PO Box 322

45 S. WISCONSIN ST.

PHONE (414) 723-3434


53121

Surveyed for -

MIKE BRENNEN

RESERVED FOR KEEFE REAL EST

Box 268 W.H.H. Dis. 53184

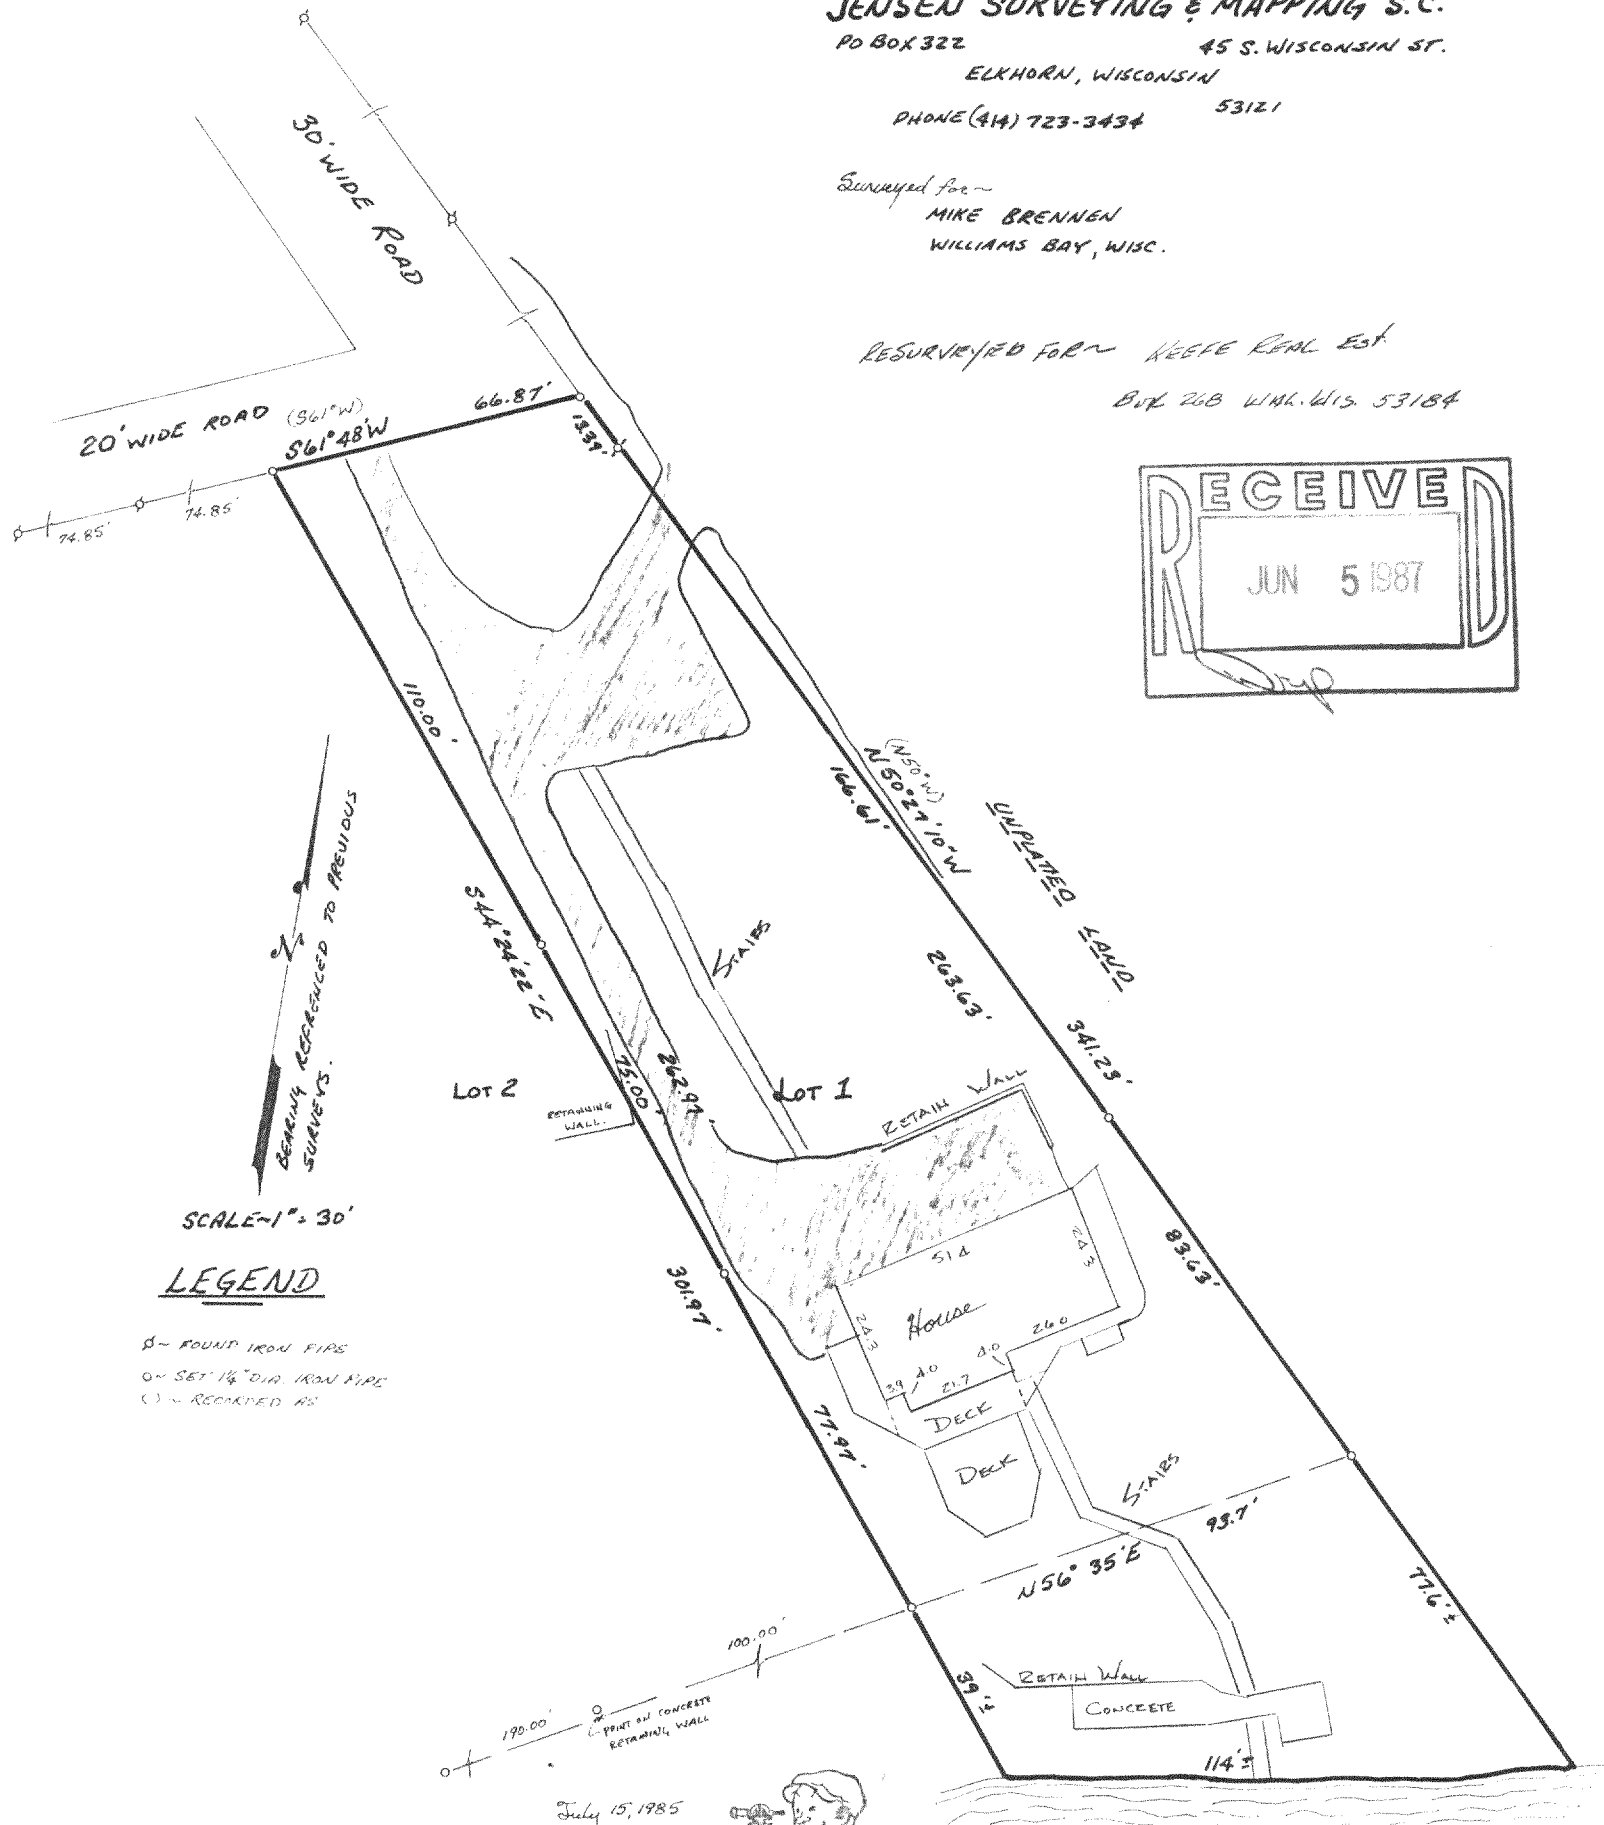

SCALE ~ 1" = 30'

LEGEND

Ø - FOUND IRON PIPE

0- SET 1 1/4" DIA. IRON PIPE

() - REPORTED AS

July 15, 1985
REVISED 10/30/86



BEULAH
LAKE

I, THOMAS P.A. JENSEN, WIS. REGISTERED LAND SURVEYOR, DO HEREBY CERTIFY THAT THIS SURVEY WAS PERFORMED BY ME, OR UNDER MY DIRECTION, IN FULL COMPLIANCE WITH THE OWNER'S/AGENT'S INSTRUCTIONS AND CHAPTER A-55 OF WIS. ADMIN. CODE "MINIMUM STANDARDS FOR PROPERTY SURVEYS"; AND THAT THIS MAP IS AN ACCURATE REPRESENTATION TO THE BEST OF MY KNOWLEDGE AND BELIEF.

THOMAS P. A. JENSEN S-1084

418-570



25

PL-1