



LOT 2, DUTCHLAND ACRES, LOCATED IN THE SOUTHEAST 1/4 OF THE NORTHEAST 1/4 OF SECTION 21,
T. 4 N., R. 18 E. OF THE 4TH P.M., TOWNSHIP OF EAST TROY, WALKWORTH COUNTY, WISCONSIN.

BEARING DATUM IS THAT OF RECORDED PLAT.

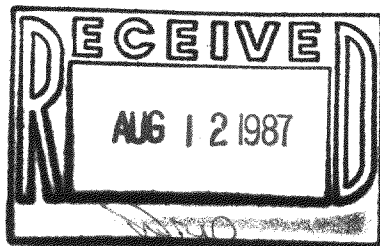

John F. Degen, Land Surveyor S 242

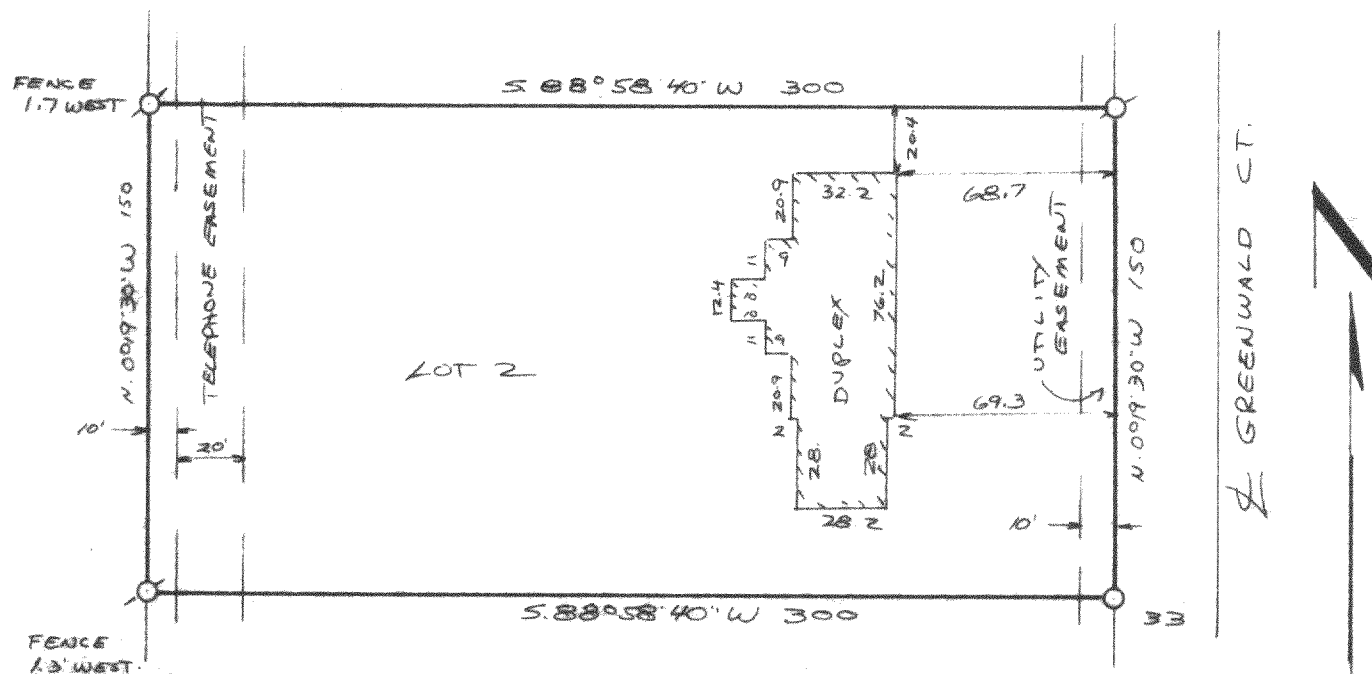

418-571

11-C-4 #37