

THE WESTERLY 71 FEET OF LOT 133 AND THE EASTERLY 19 FEET OF LOT 134 EXCEPT THAT PART OF THE EXTREME NORTH END OCCUPIED BY THE SAID ROAD CALLED BEULAH DRIVE, AS PER THE PLAT OF BEULAH HEIGHTS RECORDED BY THE REGISTER OF DEEDS IN VOL. 7 OF PLATS ON PAGES 14, 15 & 16 WAINWORTH COUNTY, WIS. CONSID. ALSO A RIGHT OF WAY 33 FEET WIDE FROM BEULAH DRIVE IN SAID BEULAH HEIGHTS IN A WESTERLY DIRECTION TO THE PUBLIC HIGHWAY. ALL OF SAID PROPERTY BEING LOCATED IN SAID BEULAH HEIGHTS SUBDIVISION OF PART OF SECTION 7, 8, 17 & 18, T. 4 N. R. 18 E.

SCALE 1" = 20'

0 = IRON PIPE STAKE SET.

♂ = IRON PIPE STAKE FOUND.


Δ = POWER POLE.

I have surveyed the above-described property, and the map hereon is a true representation thereof and shows the size and location of the property, its exterior boundaries, the location and dimensions of all visible structures thereon, fences, apparent easements and roadways and visible encroachments, if any.

This survey is made for the exclusive use of the present owners of the property, and also those who purchase, mortgage, or guarantee the title thereto, within one year from date hereof.

Dated at Burlington, this 7th day
of AUGUST, 1987

John F. Dagen
John F. Dagen, Land Surveyor 8 242

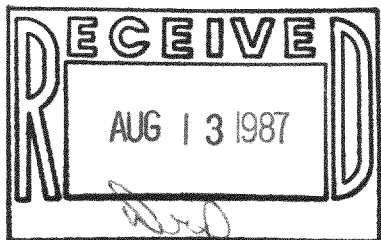

BEULAH HEIGHTS DE.
AS TRAVELED
18' BITUMINOUS SURFACE

3/4" O.D.
SET

2" P.P.E.
FOUND
BETWEEN
MASONRY GATES

105 133
104 134

276.84 TOTAL

OVER THE

GARAGE

GARAGE

1/2" pipe set

STAIRS
1.8 FROM
LINE

87.24
0.0 miles fence

3/4" D.P.E SET

DWELLING

Pump HOUSE

BOAT
HOUSE

SHED

OLD SEA WALL ENDS 0.24' EAST OF LINE

LAKE BEULAH 418-572

11-1-1
#25 PBH-17