


KOLB LAND CONSULTING, INC.
LAND SURVEYING • SUBDIVIDING • LAND PLANNING

929 WILLIAMS STREET

LAKE GENEVA, WISCONSIN 53147

414-248-3697

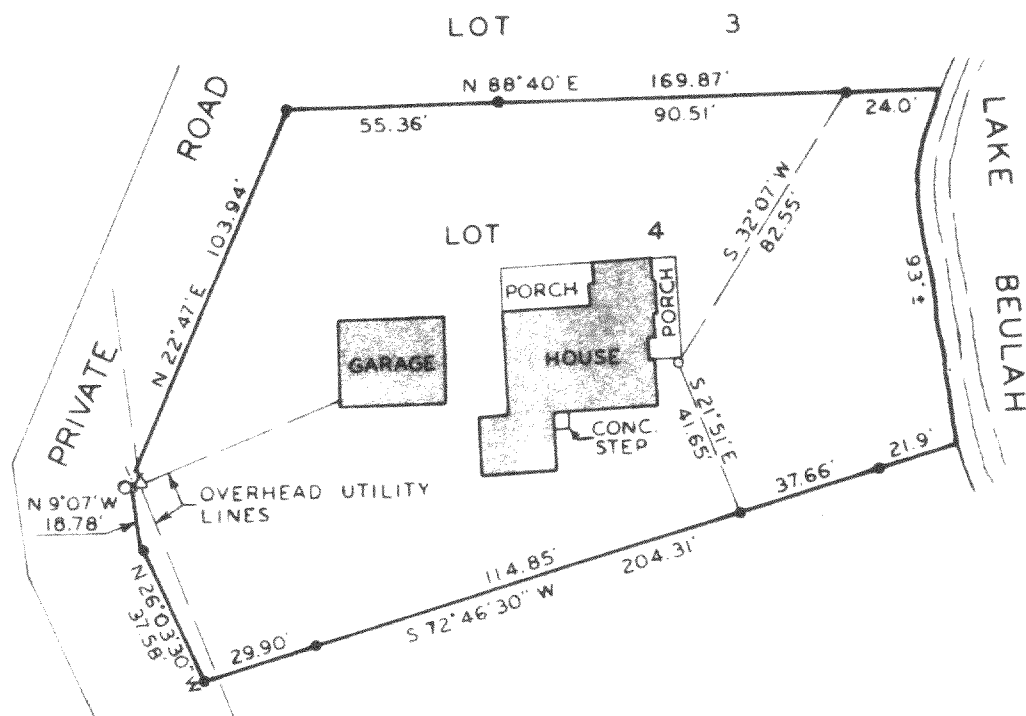


PLAT OF SURVEY OF

LOT 4 OF CERTIFIED SURVEY MAP NO. 27, LOCATED IN THE EAST 1/2 OF SECTION 9, T 4 N, R 18 E, TOWN OF EAST TROY, WALWORTH COUNTY, WISCONSIN.


NOTE: DISTANCES AND BEARINGS ARE AS SHOWN ON RECORDED CERTIFIED SURVEY MAP AND CHECK WITHIN MINIMUM STANDARDS OF THE WISCONSIN ADMINISTRATION CODE A-E 5.01.

ORDERED BY: REALTY EXECUTIVES
1132 SOUTH SHORE DRIVE
EAST TROY, WI. 53120

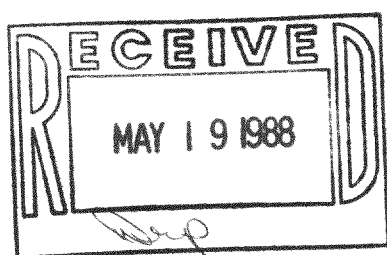

I HEREBY CERTIFY THAT I HAVE SURVEYED THE ABOVE DESCRIBED PROPERTY AND THAT THE ABOVE MAP IS A TRUE REPRESENTATION THEREOF AND SHOWS THE SIZE AND LOCATION OF THE PROPERTY, ITS EXTERIOR BOUNDARIES, THE LOCATION OF ALL VISIBLE STRUCTURES AND DIMENSIONS OF ALL PRINCIPAL BUILDINGS THEREON, BOUNDARY FENCES, APPARENT EASEMENTS, ROADWAYS AND VISIBLE ENCROACHMENTS, IF ANY, TO THE BEST OF MY KNOWLEDGE AND BELIEF.

THIS SURVEY IS MADE FOR THE USE OF THE PRESENT OWNERS OF THE PROPERTY, AND ALSO THOSE WHO PURCHASE, MORTGAGE, OR GUARANTEE THE TITLE THERETO WITHIN ONE (1) YEAR FROM DATE HEREOF. SURVEY NOT VALID UNLESS SURVEYOR'S SIGNATURE IS IN RED.

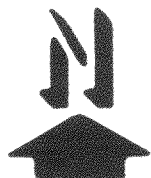

SCALE : 1" = 50'

LEGEND

- - IRON ROD FOUND
- o - IRON PIPE FOUND
- X - SPIKE SET
- Δ - UTILITY POLE
- o - TELEPHONE PEDESTAL

HAROLD H. KOLB

WISCONSIN REGISTERED LAND SURVEYOR, S-187

DATE JANUARY 14, 1988

REVISED

REVISED

PA27-4

419-613