


WALWORTH COUNTY  
SURVEYING & MAPPING  
LAKE GENEVA, WISCONSIN


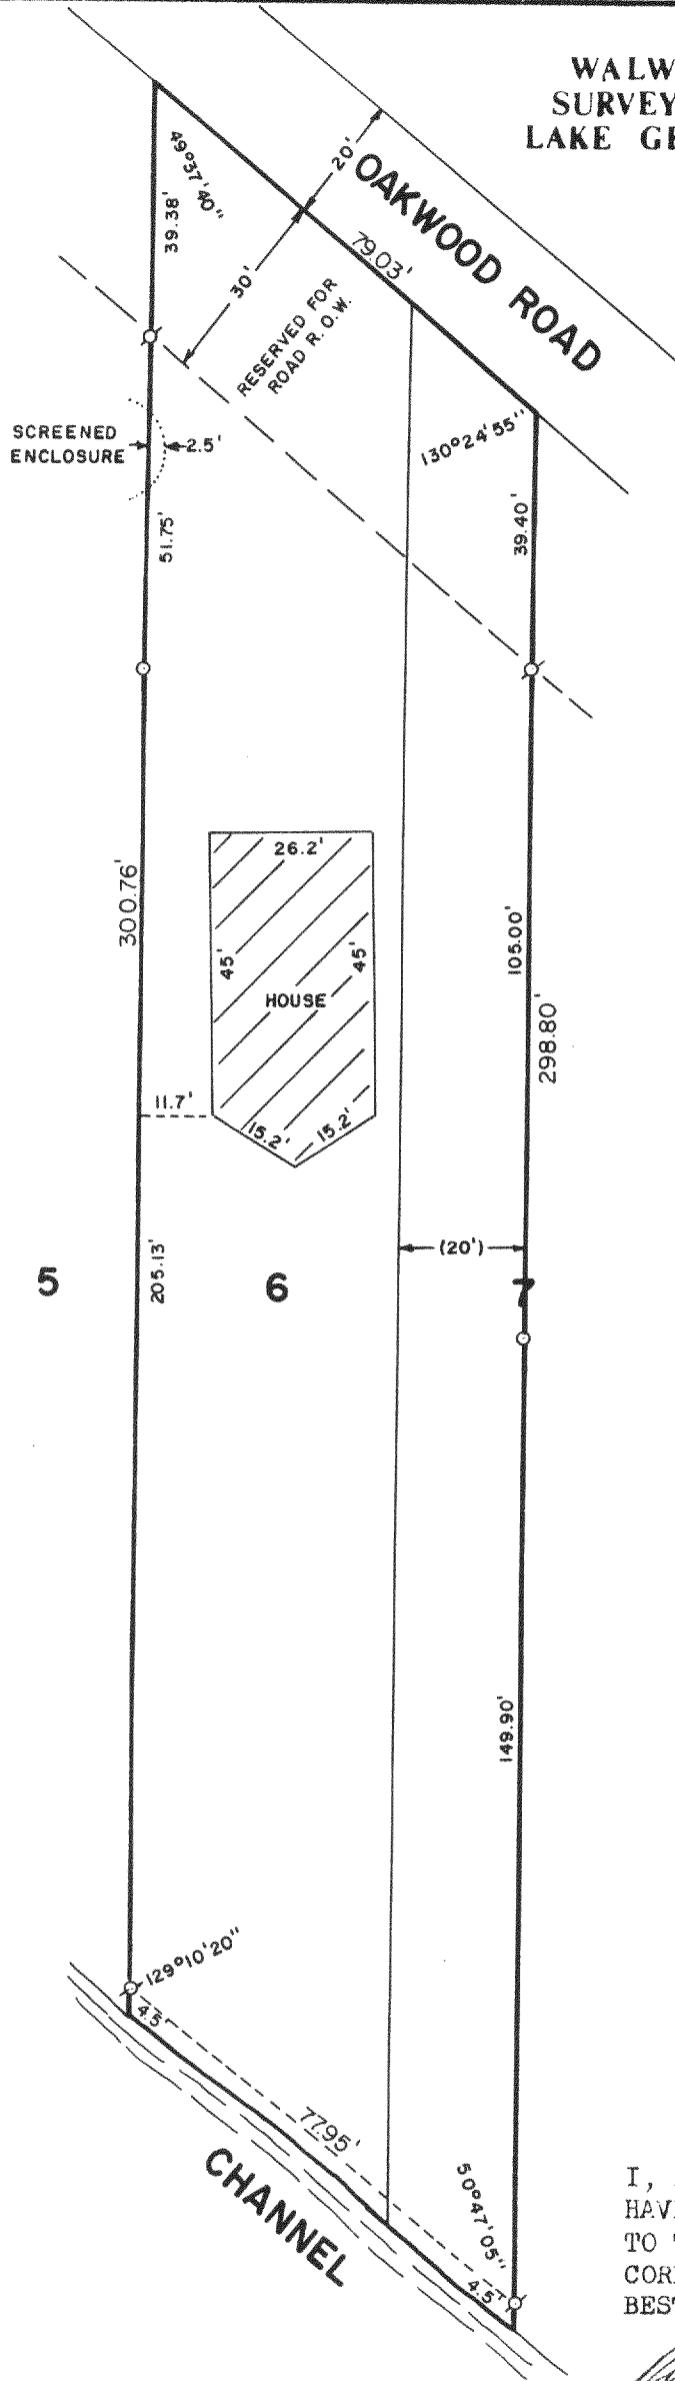


PLAT OF SURVEY OF

LOT 6 AND THE WEST 20 FEET OF LOT  
7 OF OAKWOOD PARK SUBDIVISION,  
LOCATED IN T 4 N, R 18 E, WALWORTH  
COUNTY, WISCONSIN.

ORDERED BY: CLAIR TIEDE  
RT. 3, BOX 227E  
MUKWONAGO, WISCONSIN  
53149

NOTE: SCREENED ENCLOSURE IS LOCATED  
ON A FLAGSTONE BASE.

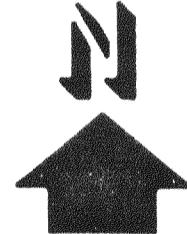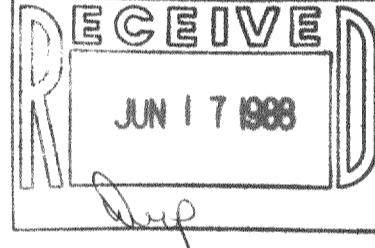

SCALE: 1" = 30'

P - IRON PIPE FOUND  
O - IRON ROD PLACED

I, ROBERT M. BAERENWALD, DO HEREBY CERTIFY THAT I  
HAVE SURVEYED THE PROPERTY HEREON DESCRIBED ACCORDING  
TO THE OFFICIAL RECORDS AND THAT THE PLAT HEREON IS A  
CORRECT REPRESENTATION OF THE PROPERTY LINES TO THE  
BEST OF MY KNOWLEDGE AND BELIEF.

Robert M. Baerwald  
ROBERT M. BAERENWALD  
WISCONSIN REGISTERED LAND SURVEYOR, S-1508

DATE April 18, 1988 JOB NO. 1484

NOTE: THIS IS NOT A CERTIFIED COPY UNLESS SEALED.

418-616