


D. Cooper & CO., INC

Rt 4 Box 508B * Elkhorn WI 53121

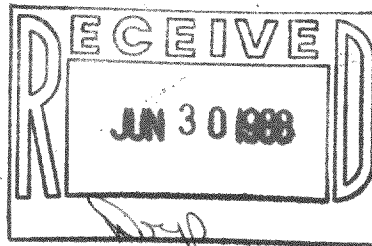


Plat of Survey of Lots 3 and 4, Block 2, Frasers and Hunters Addition,
being located in Section 12, Town 4 North, Range 18 East Walworth
County, Wisconsin.

Survey ordered by Main Street Realty
East Troy

Bearing reference: Centerline of Highway
"24" assumed to bear
N 40 00'E as recorded

FOUND IRON
FOUND IRON
S.T.H. "24"

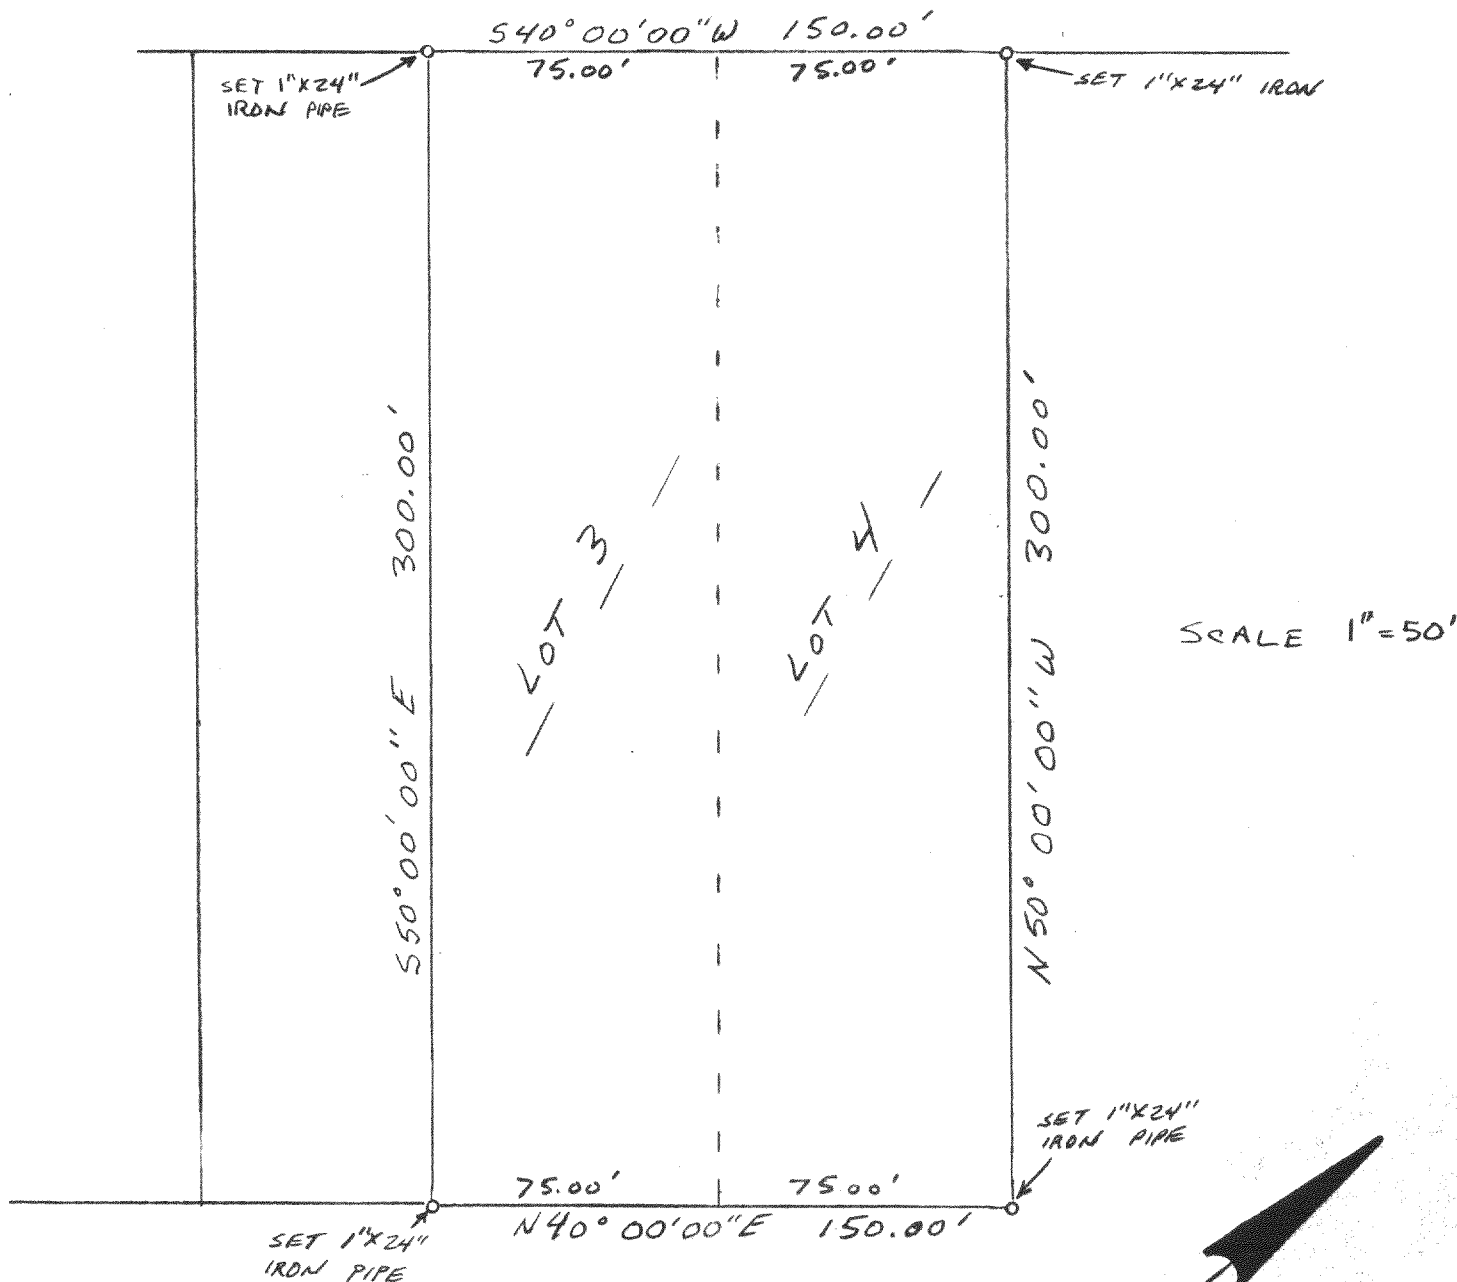



I hereby certify that I have surveyed the
property described hereon and that the
map shown hereon is a true and accurate
representation thereof to the best of my
professional knowledge and belief.

Dated this 25 day of April, 1988

Daniel D. Cooper

Daniel D. Cooper, RLS No. S-1464

PLBSA-7

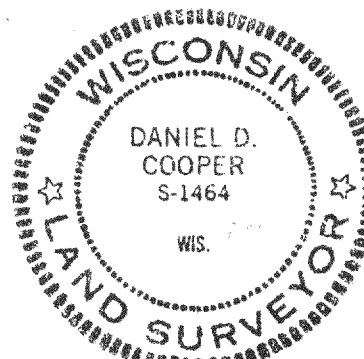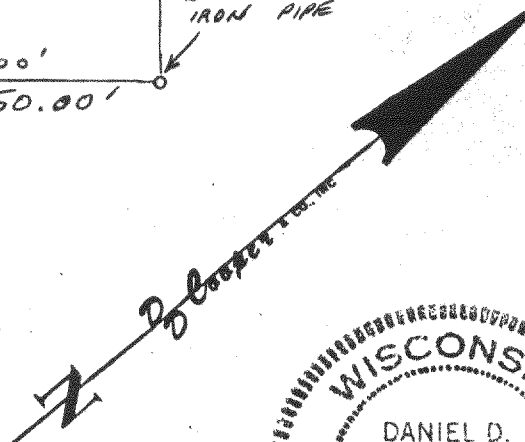

DRAWING NO. 3237