

Date September 26, 1988

PLAT OF SURVEY

Job No. Z-10-37182



LOT 2 - BLOCK 2 - SKONEY'S SUBDIVISION
located in the southeast 1/4 of the Southwest 1/4 and the Southwest 1/4
of the southeast 1/4 of Section 10, Town 4 North, Range 18 East in the
Town of East Troy, Walworth County, Wisconsin.

Located at 1719 Spleas Skoney Road

Owner: Franklin and Norbel Brautigam

S P L E A S S K O N E Y R O A D (50')

20± MACADAM ROADWAY

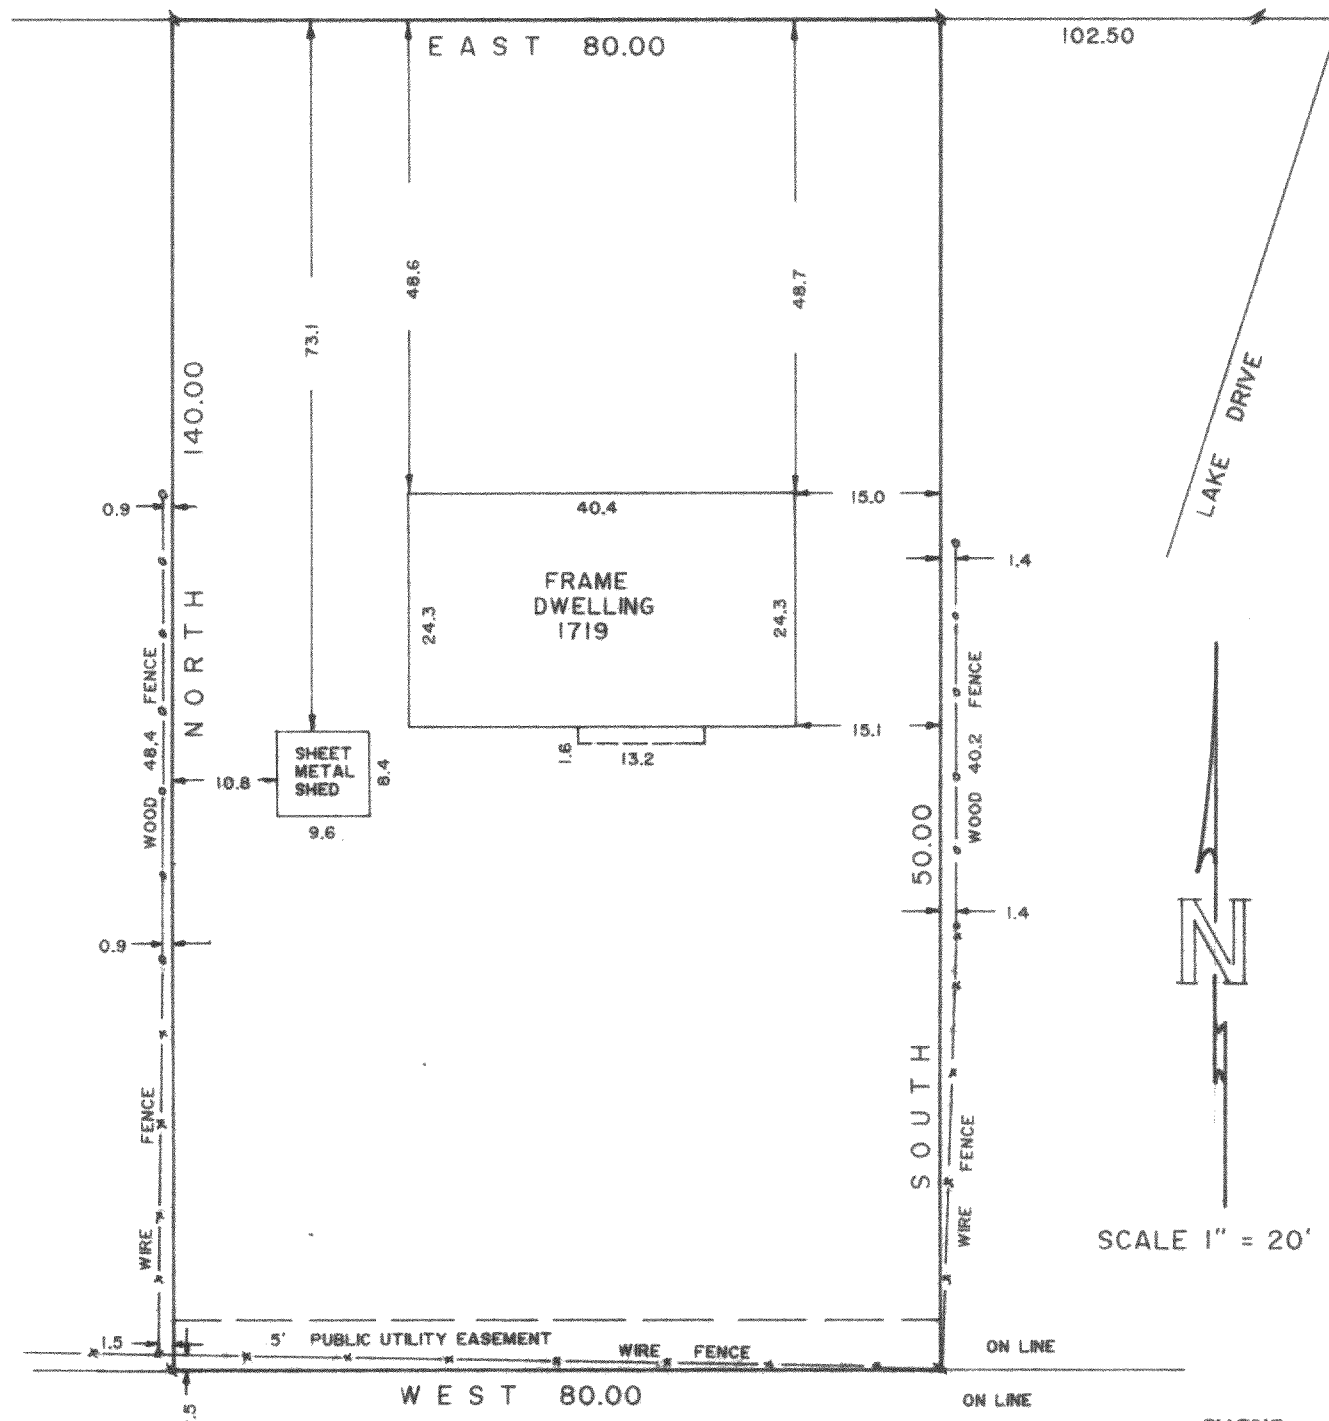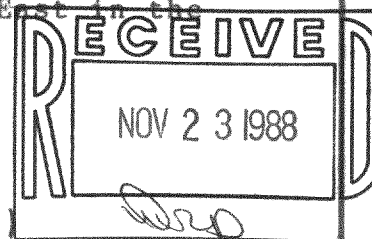

— FOUND IRON PIPE

o — SET IRON PIPE

8522 West Lisbon Avenue
Milwaukee, Wisconsin 53222

SURVEYED FOR

Security Savings and Loan Association
1055 North Mayfair Rd.
Wauwatosa, WI 53226


LANDMARK SURVEYING CO.

I, Richard J. Lammi, surveyed the above described property, and the above map is a true representation thereof and shows the size and location of the property, its exterior boundaries, the location and dimensions of all visible structures thereon, fences, apparent easements, roadways and visible encroachments.

This survey is made for the exclusive use of the present owners of the property; also those who purchase, mortgage or guarantee the title thereto, within one year from date hereof.

[Signature]
REGISTERED LAND SURVEYOR NO. 5-777 - STATE OF WISCONSIN

PHONE
461-3730

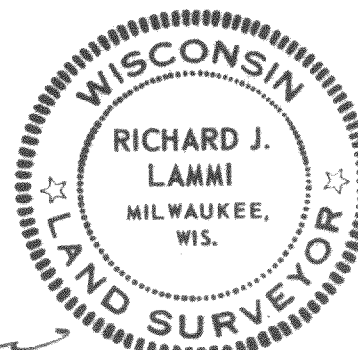

418-635

PSK-10