


BELLAH LAKE

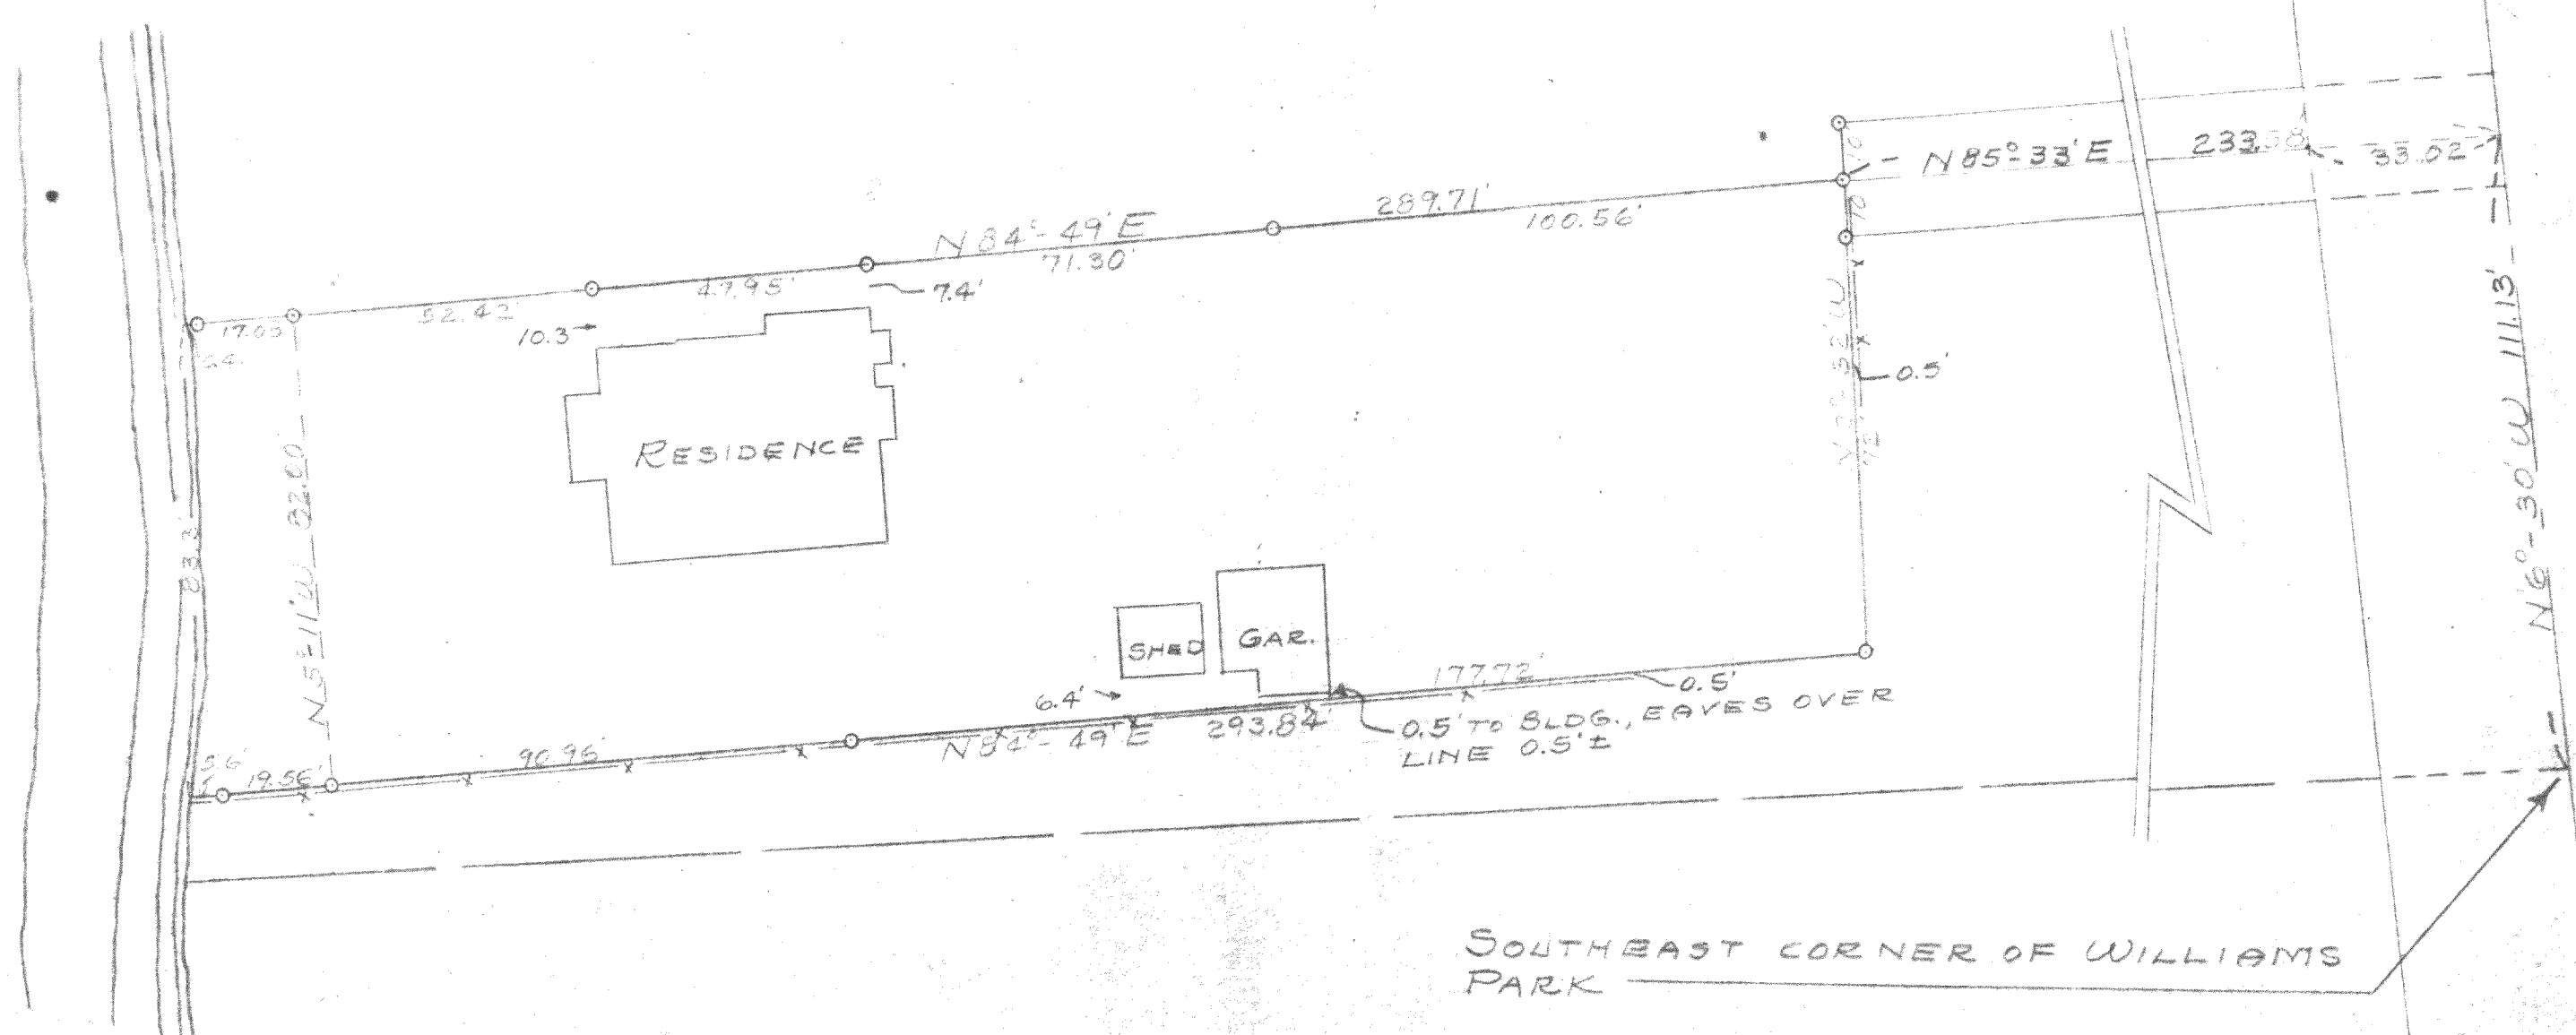

PLAT OF SURVEY  
OF

LAND LOCATED IN WILLIAMS  
PARK SUBDIVISION IN SEC-  
TION 4, T4N R18E OF WAL-  
WORTH COUNTY WISCONSIN.

Lloyd L. Jensen  
SURVEYOR

SCALE 1" = 30'

DATE AUGUST 1955

418-63J

WP-1