


WAUKESHA, WIS. 53186

(414) 542-5616

RONALD H. ZIMMERMAN  
REGISTERED LAND SURVEYOR


PLAT OF SURVEY

FOR

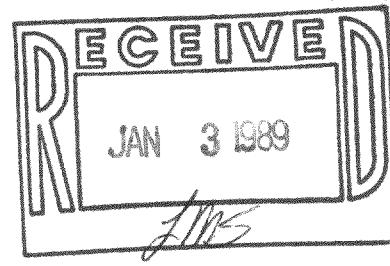

JOSEPH TOMASKA

BEULAH

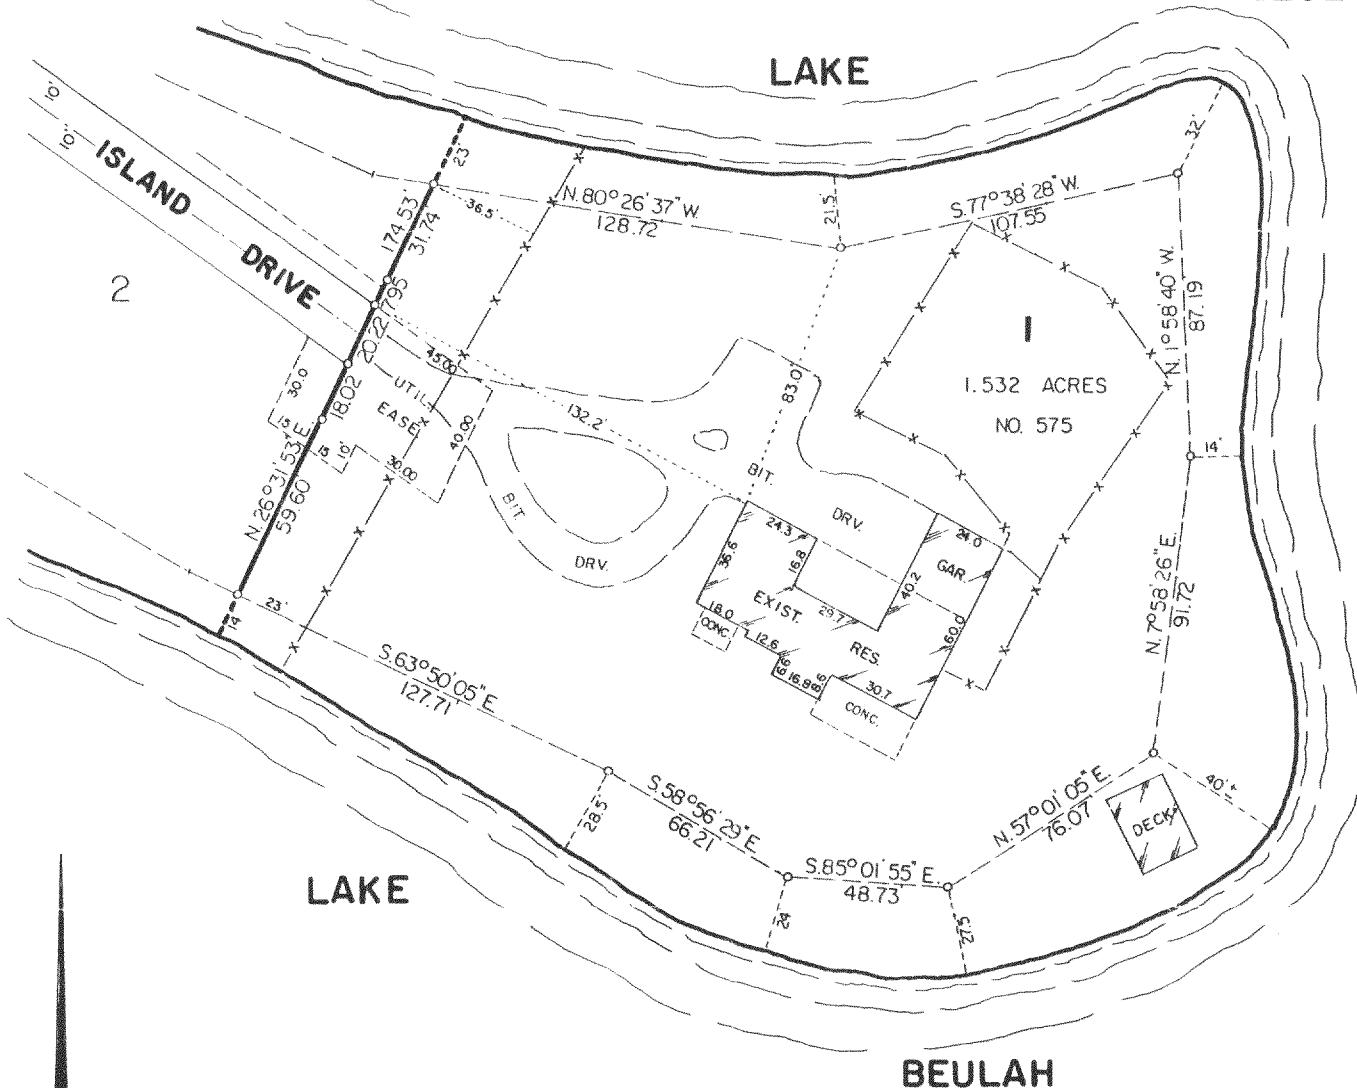

SCALE 1" = 60'

○ - INDICATES IRON BAR, FOUND.

lot 1 of island Club according to the plat thereof recorded June 1, 1973 in Volume 17 of Plats on pages 13-14, together with an easement in common with others from Island Club Subdivision to Walworth County Highway "J", together with right to use the 20 foot private road as laid out in said subdivision, in Walworth County, Wisconsin.

CERTIFICATION

STATE OF WISCONSIN / SS  
COUNTY OF WAUKESHA /

I HAVE SURVEYED THE ABOVE DESCRIBED PROPERTY AND THE ABOVE MAP IS A TRUE REPRESENTATION THEREOF AND SHOWS THE SIZE AND LOCATION OF THE PROPERTY, ITS EXTERIOR BOUNDARIES, THE LOCATION AND DIMENSIONS OF ALL VISIBLE STRUCTURES THEREON, FENCES, APPARENT EASEMENTS AND ROADWAYS AND VISIBLE ENCROACHMENTS, IF ANY.

THIS SURVEY IS MADE FOR THE EXCLUSIVE USE OF THE PRESENT OWNERS OF THE PROPERTY, AND ALSO THOSE WHO PURCHASE, MORTGAGE, OR GUARANTEE THE TITLE THERETO WITHIN ONE (1) YEAR FROM DATE HEREOF; AND AS TO THEM I WARRANT THE ACCURACY OF SAID SURVEY AND MAP.

Ronald H. Zimmerman  
RONALD H. ZIMMERMAN  
S-868



DATE DECEMBER 19 1988

S-868

418-645