

POTTERS

Plat of Survey



LAKE

FOR
KEN CERNY

KNOWN AS 1504 SHOREWOOD DRIVE, IN THE TOWN OF EAST TROY, WISCONSIN.
LOT 58 IN SHOREWOOD, BEING A SUBDIVISION OF A PART OF THE SE 1/4 AND THE SW 1/4 OF
SECTION 11, AND THE NW 1/4 OF SECTION 14, AND THE NE 1/4 OF SECTION 15, T. 4 N., R. 19 E.
IN THE TOWN OF EAST TROY, IN WALWORTH COUNTY, WISCONSIN.

FEBRUARY 22, 1989
MARCH 9, 1989

SURVEY NO. 152723-S
REVISION NO. 1

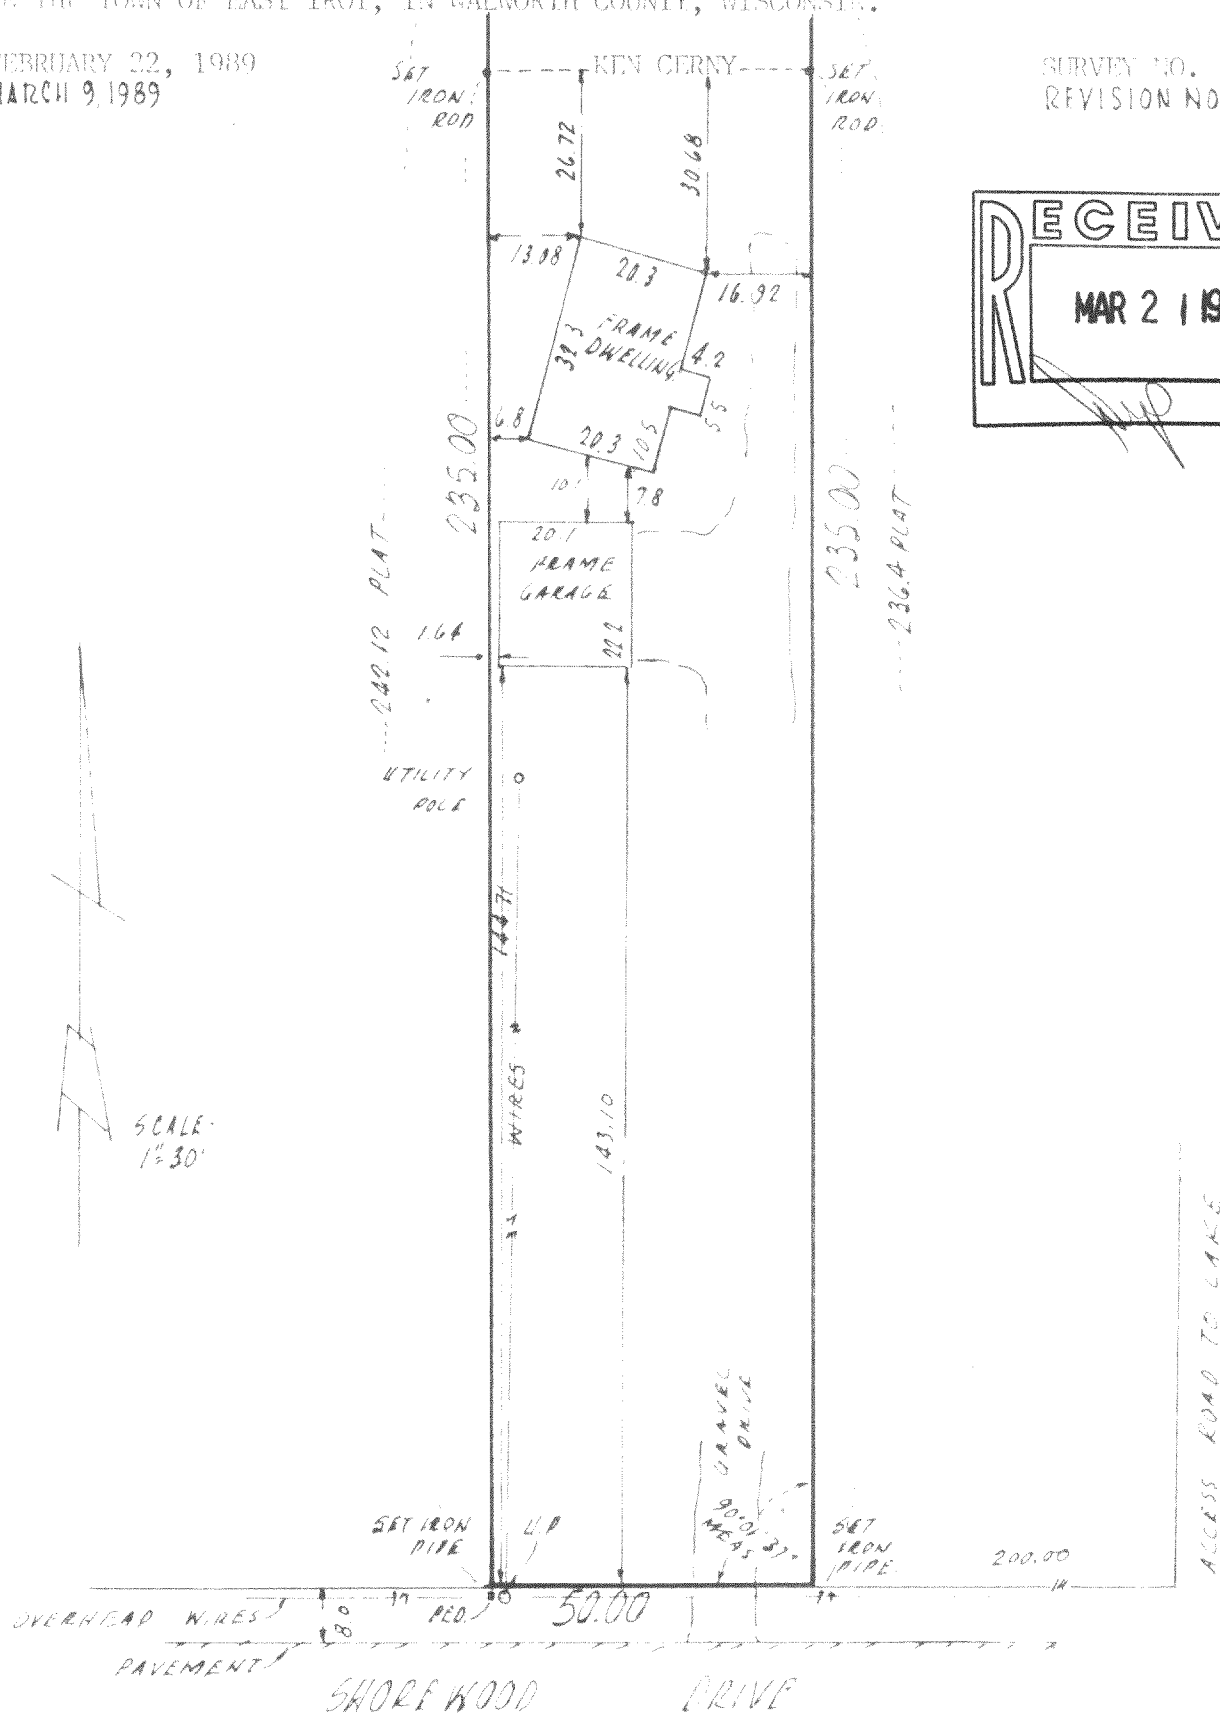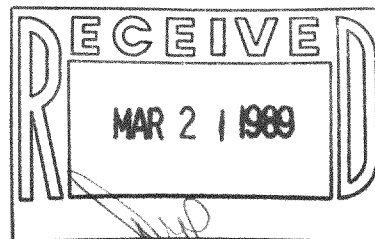

I Certify that I have surveyed the above described property (Property) and the above map is a true representation thereof and shows the size and location of the Property, its exterior boundaries, the location and dimensions of all visible structures thereon, boundary fences, apparent easements and roadways and visible encroachments, if any. This survey is made for the exclusive use of the present owners of the Property and also those who purchase, mortgage, or guarantee the title thereto, within one (1) year from date hereof.



national survey engineering
3470 north 127th street brookfield, wisconsin 53008
p. o. box 53008-0444 phone 414 781-1000

Kenneth E. Berke
SURVEYOR

THIS IS ORIGINAL
PRINT ONLY IF
SEAL IS IMPRINTED
IN RED

418-662

