
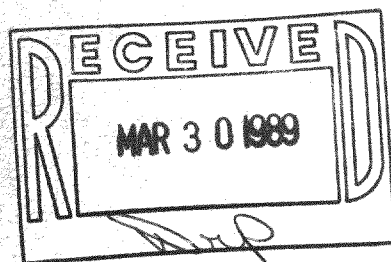


PLAT OF SURVEY
 of PART OF LOTS 8 & 9 WILMER GROVE BEACH SUBD. LOCATED
 IN SECTION 18, T.4N., R.18E., WALWORTH CO., WISC.

I HEREBY CERTIFY THAT THIS MAP
 IS A TRUE & ACCURATE REPRESENTATION
 OF THE BOUNDARY LINES & THE LOCATION
 OF PRINCIPAL BUILDINGS TO THE
 BEST OF MY PROFESSIONAL KNOWLEDGE
 & BELIEF

Robert A. Farris

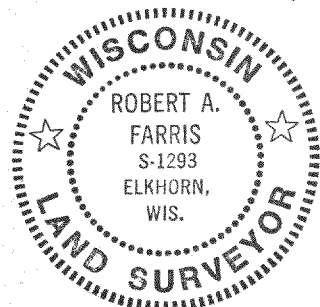

N




LEGEND

⊙ = IRON PIPE SURVEY
 STK FOUND

(xxx) = RECORD DIMENSION

--- = OVERHEAD WIRES

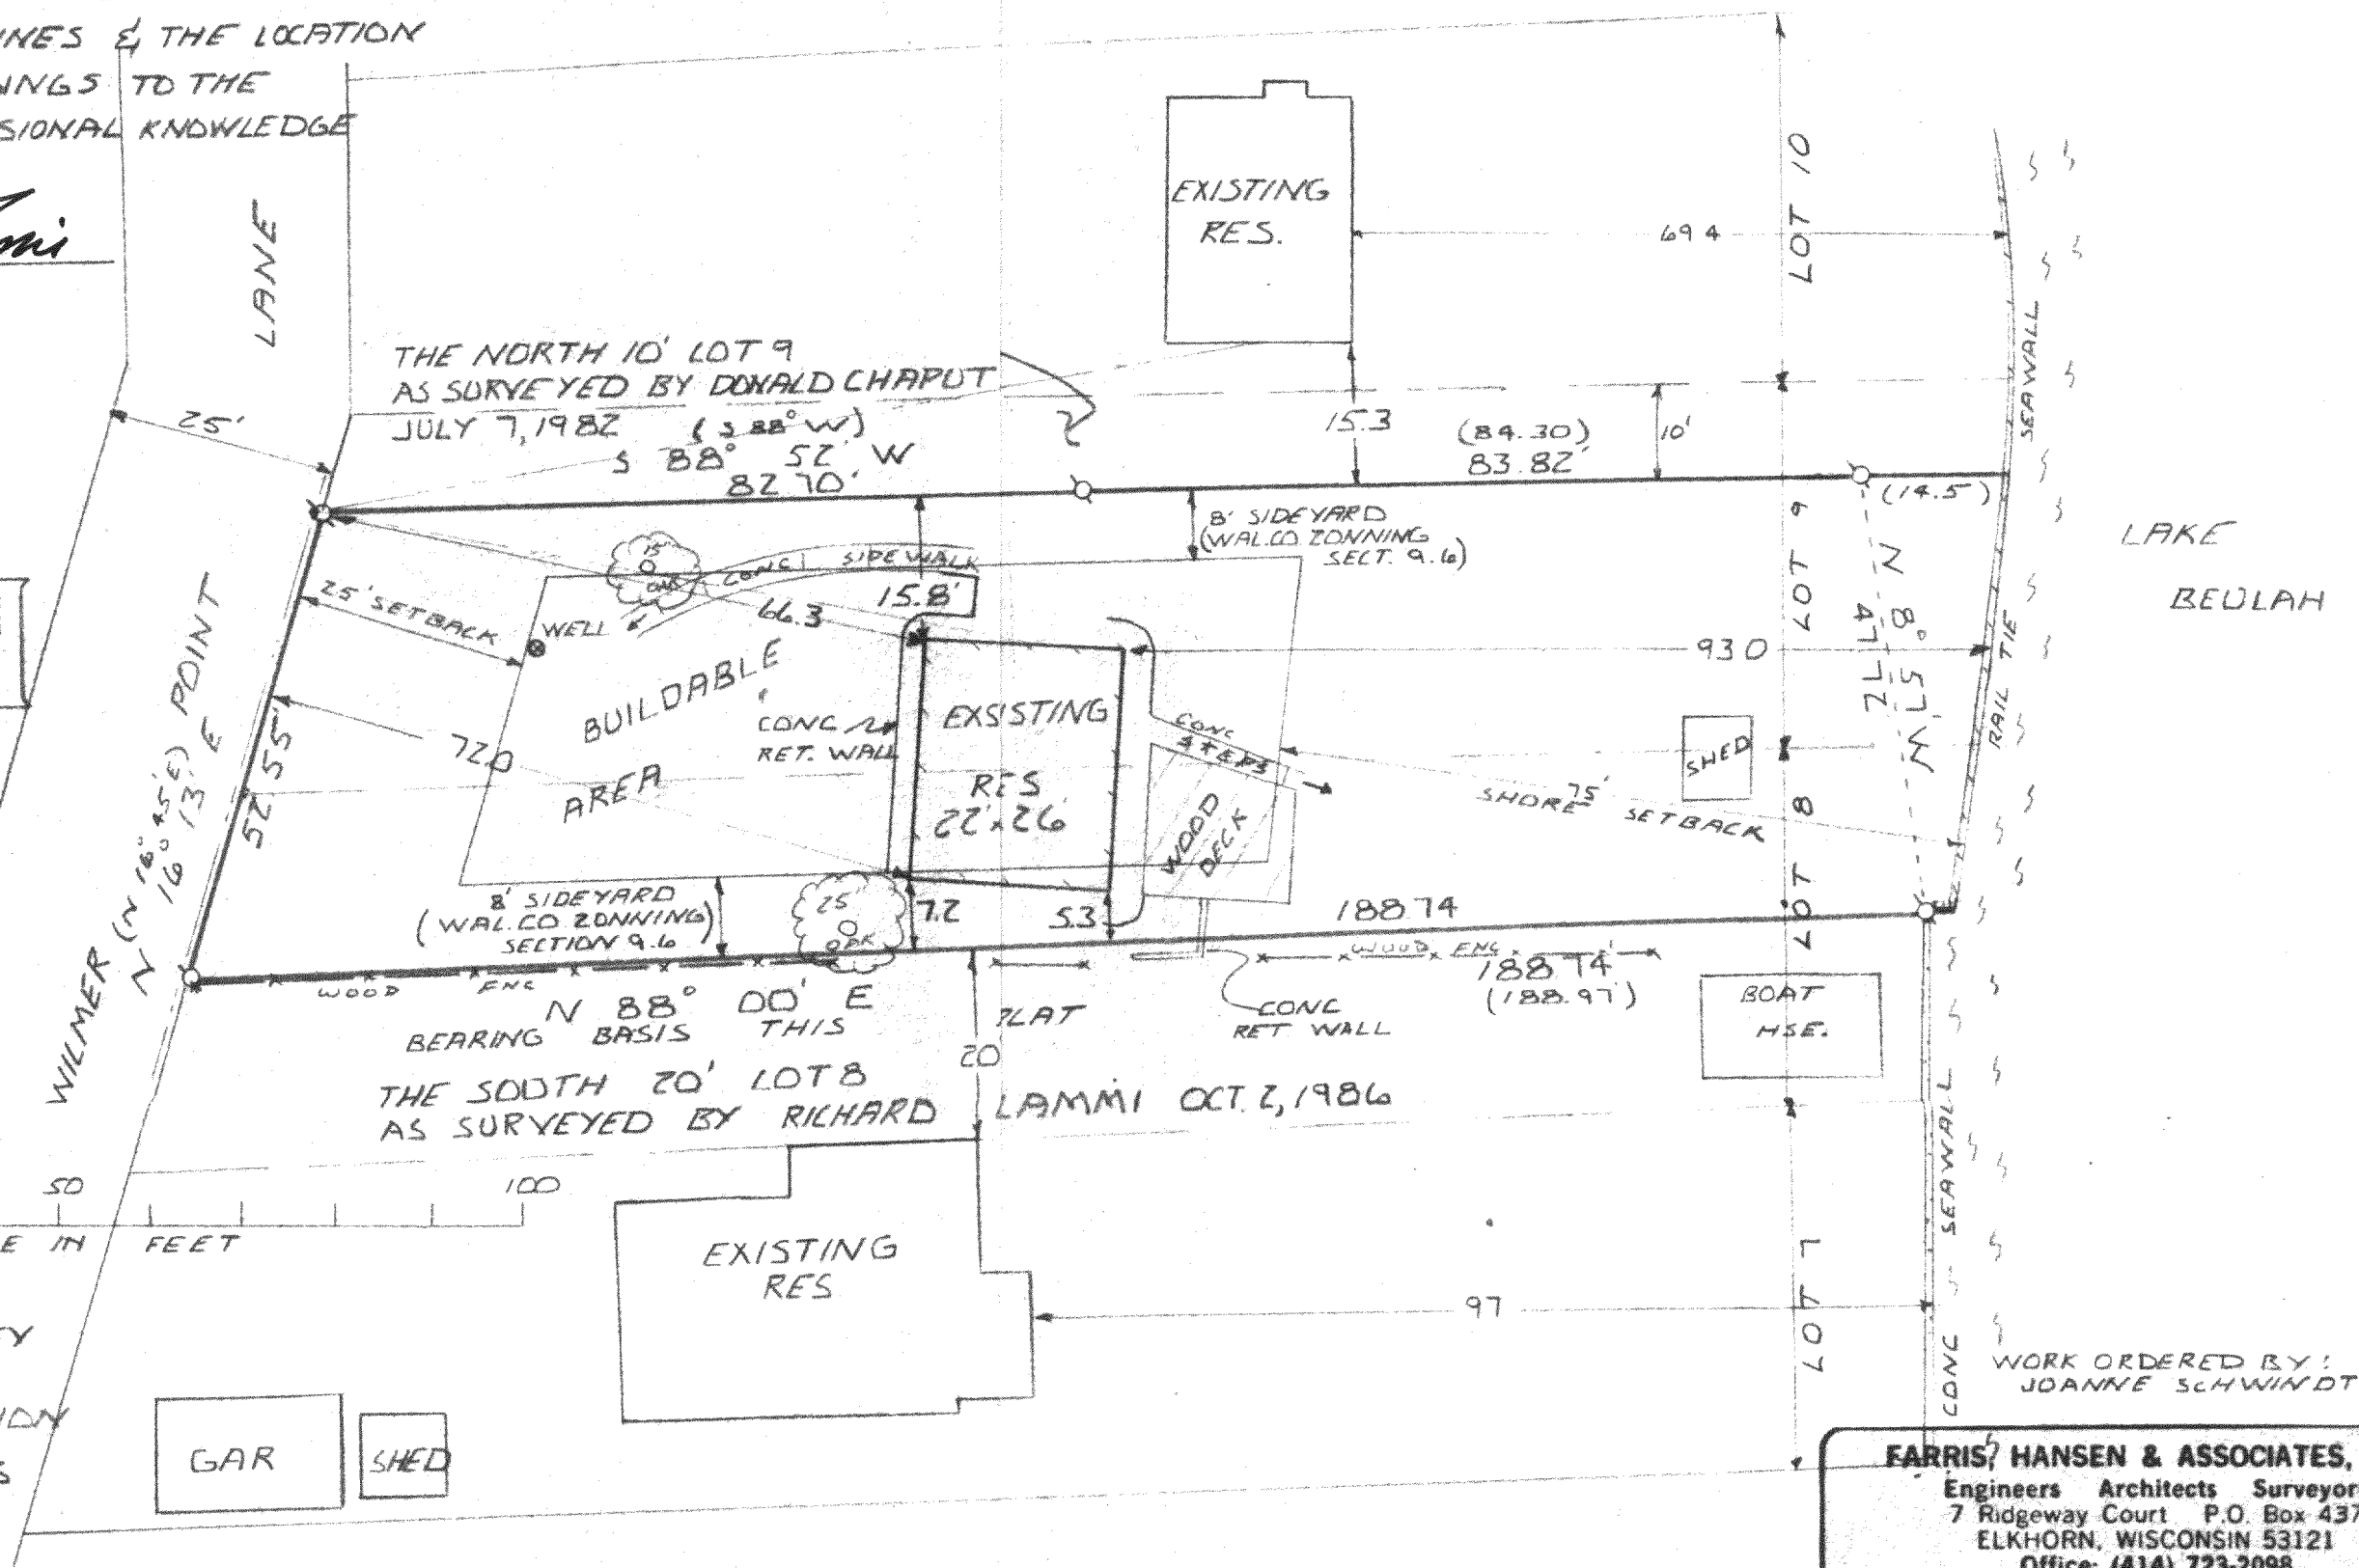

WORK ORDERED BY:
 JOANNE SCHWINDT

FARRIS, HANSEN & ASSOCIATES, INC.
 Engineers Architects Surveyors
 7 Ridgeway Court P.O. Box 437
 ELKHORN, WISCONSIN 53121
 Office: (414) 723-2098

PROJECT 3173

MARCH 3, 1989

418-664