




RECEIVED
SEP 22 1989

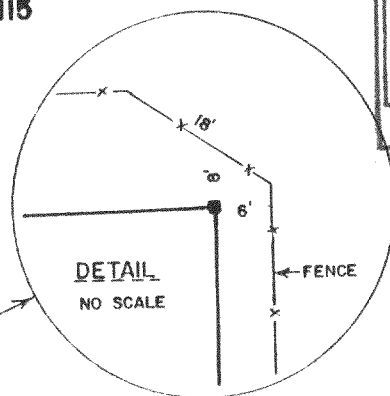

A PARCEL OF LAND LOCATED IN THE SOUTHEAST 1/4 OF SECTION 17, T4N,R18E, WALWORTH COUNTY, WISCONSIN AND DESCRIBED AS FOLLOWS: COMMENCING AT THE SOUTH 1/4 CORNER OF SAID SECTION 17; THENCE N 88° 39'34" E 1921.19 FEET ALONG THE SOUTH LINE OF THE SOUTHEAST 1/4 OF SAID SECTION 17 TO THE PLACE OF BEGINNING; THENCE N 0°08'50" E 476.15 FEET; THENCE S 88°36'45" W 590.47 FEET; THENCE N 1°02'50" E 1787.83 FEET; THENCE S 81°33'00" E 378.58 FEET; THENCE N 0°03'45" W 429.10 FEET TO THE NORTH LINE OF SAID SOUTHEAST 1/4 OF SECTION 17; THENCE N 88° 42'25" E 902.00 FEET ALONG SAID NORTH LINE TO THE EAST 1/4 CORNER OF SAID SECTION 17; THENCE S 0° 03'45" E 1748.24 FEET ALONG THE EAST LINE OF SAID SOUTHEAST 1/4 OF SECTION 17; THENCE S 88°39'34" W 622.50 FEET; THENCE S 0°03'45" E 878.00 FEET TO THE SOUTH LINE OF SAID SOUTHEAST 1/4 OF SECTION 17; THENCE S 88°39'34" W 99.94 FEET ALONG SAID SOUTH LINE TO THE PLACE OF BEGINNING, CONTAINING 55.65 ACRES OF LAND.

ORDERED BY: FARM CREDIT SERVICES OF SOUTHEAST
WISCONSIN
1705 HIGHWAY 14 WEST, P.O. BOX 1589
JANESVILLE, WI. 53547-1589

NOTE: THE WISCONSIN ELECTRIC POWER COMPANY HAS AN EASEMENT OVER THE S.E. 1/4 OF SECTION 17-4-18 AS DESCRIBED IN VOL. 286, PAGE 101 OF DEEDS, AS DOC. # 352267.

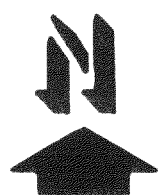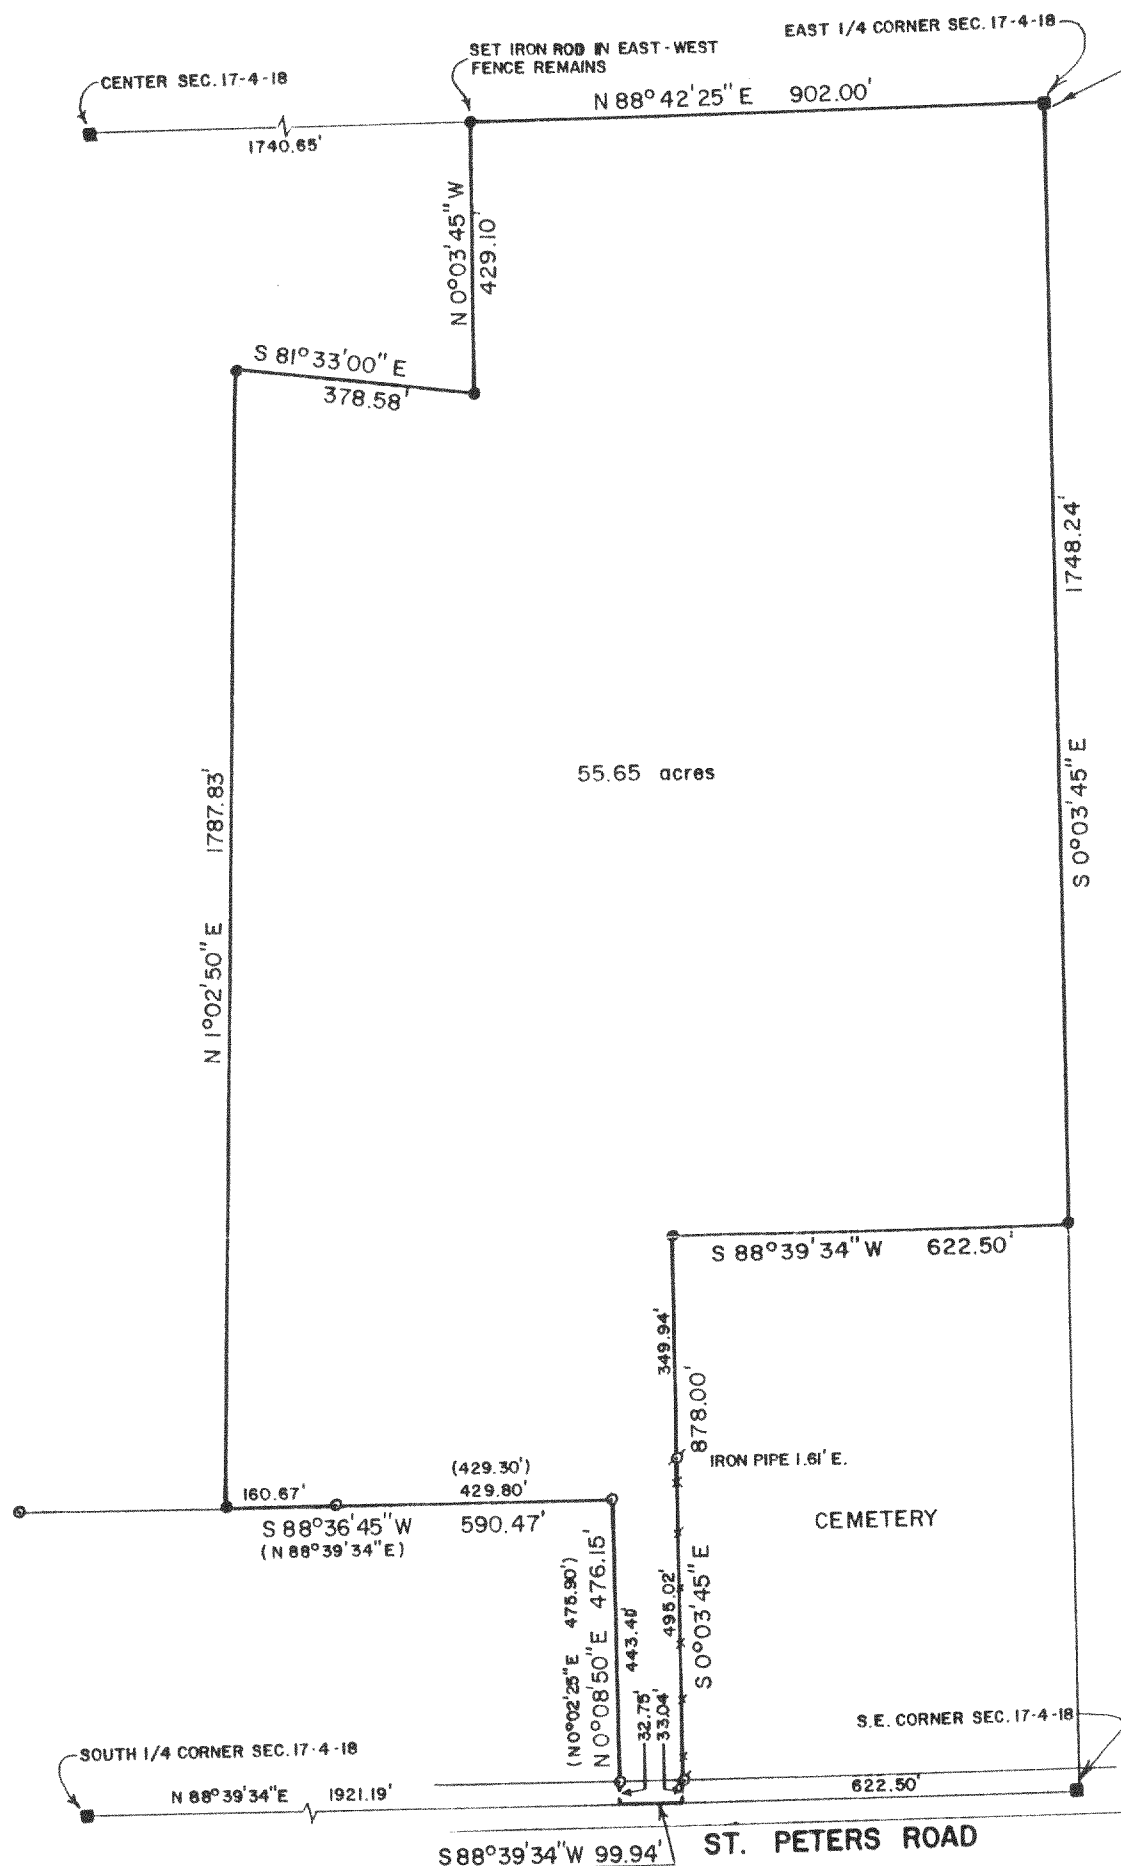

LEGEND

- o - IRON PIPE FOUND
- o - IRON PIPE FOUND IN
CONCRETE
- - IRON ROD SET
- - WALWORTH COUNTY SECTION CORNER
MONUMENT FOUND
-) - RECORDED AS
- - FENCE

THIS SURVEY IS MADE FOR THE USE OF THE PRESENT OWNERS OF THE PROPERTY, AND ALSO THOSE WHO PURCHASE, MORTGAGE, OR GUARANTEE THE TITLE THERETO WITHIN ONE (1) YEAR FROM THE DATE HEREOF.

David F. Abell
DAVID F. ABELL
WISCONSIN REGISTERED LAND SURVEYOR, S-1596

DATE May 13, 1989 JOB NUMBER - 89007
NOTE: THIS IS NOT A CERTIFIED COPY UNLESS SEALED.

PET 17-5

T- EAST 1000

418-672