

REGIONAL CONSULTING ENGINEERS, INC.

PROFESSIONAL ENGINEERS AND SURVEYORS

4842 NO. 88TH ST.

MILWAUKEE, WISCONSIN



PHONE 464-4638

PLAT OF SURVEY

POTTER'S LAKE



DESCRIPTION: Lot 49 in Shorewood, being a subdivision of a part of the Southeast One Quarter of Section 10, the Southwest One Quarter of Section 11, the Northwest One Quarter of Section 14 and the Northeast One Quarter of Section 15, all in Township 4 North, Range 18 East in the Town of East Troy, Walworth County, Wisconsin
OWNERS: John B. and Kristen Korte- Evens 1328 Shorewood Drive

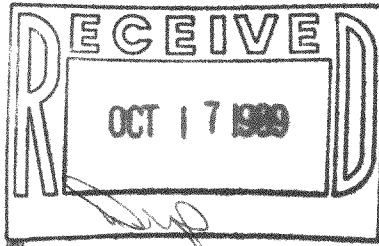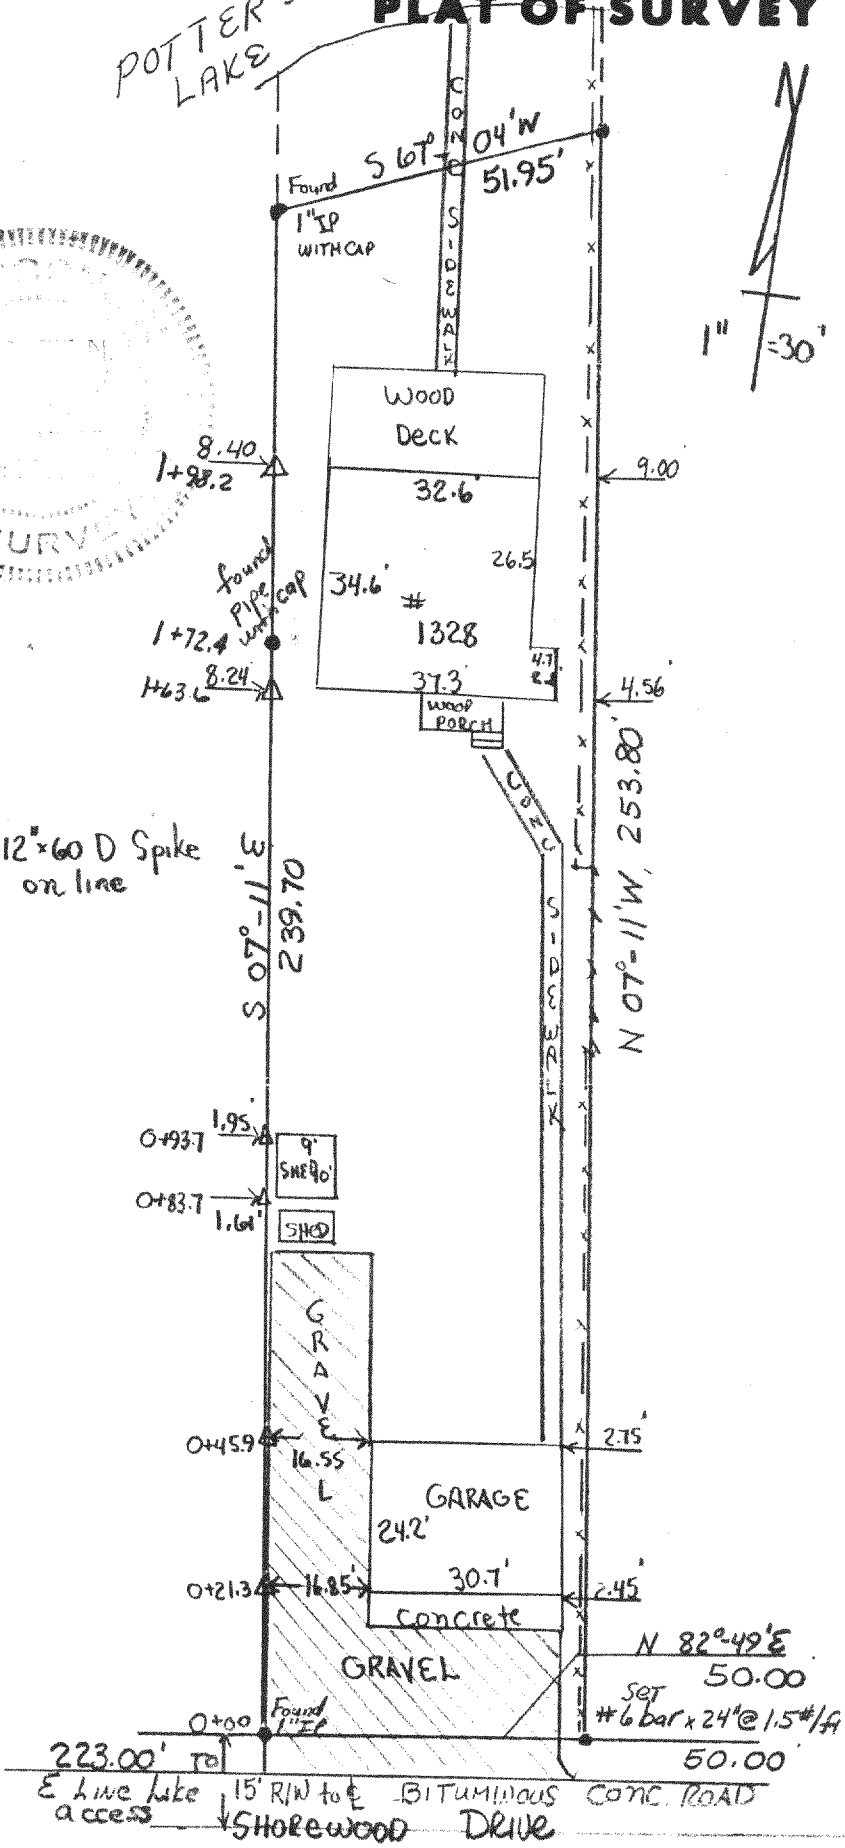

STATE OF WISCONSIN } ss.
COUNTY OF MILWAUKEE

I HAVE SURVEYED THE ABOVE-DESCRIBED PROPERTY AND THE ABOVE MAP IS A TRUE REPRESENTATION THEREOF AND SHOWS THE SIZE AND LOCATION OF THE PROPERTY, ITS EXTERIOR BOUNDARIES, THE LOCATION AND DIMENSIONS OF ALL VISIBLE STRUCTURES THEREON, FENCES, APPARENT EASEMENTS AND ROADWAYS AND VISIBLE ENCROACHMENTS, IF ANY.

THIS SURVEY IS MADE FOR THE EXCLUSIVE USE OF THE PRESENT OWNERS OF THE PROPERTY, AND ALSO THOSE WHO PURCHASE, MORTGAGE, OR GUARANTEE THE TITLE THERETO WITHIN ONE (1) YEAR FROM DATE HEREOF; AND AS TO THEM I CERTIFY THE ACCURACY OF SAID SURVEY AND MAP.

NOTE: AN AGREEMENT EXISTS BETWEEN REGIONAL CONSULTING ENGINEERS, INC. AND THE LENDING INSTITUTION TO OMIT THE RESETTING OF ANY MISSING LOT CORNER PIPES ON THIS SURVEY UNLESS SPECIFICALLY REQUESTED AT THE TIME OF SURVEY ORDER PLACEMENT.

DATED THIS 15th DAY OF October 19 89

Robert M. Korte- Evens
SURVEYOR

JOB NO

89356

PS - 47

418-673