

Date March 13, 1989



PLAT OF SURVEY

Job No. Z-18-37532

LOT 7 AND THE SOUTH 20 FEET OF LOT 8 - BLOCK 1 - WILMER GROVE BEACH
lying and being in the East 1/2 of Section 18, Town 4 North, Range 18 East, Town of East Troy,
Walworth County, Wisconsin.

Located at 1516 Wilmer Grove

Owner: Ronald J. Vavrik

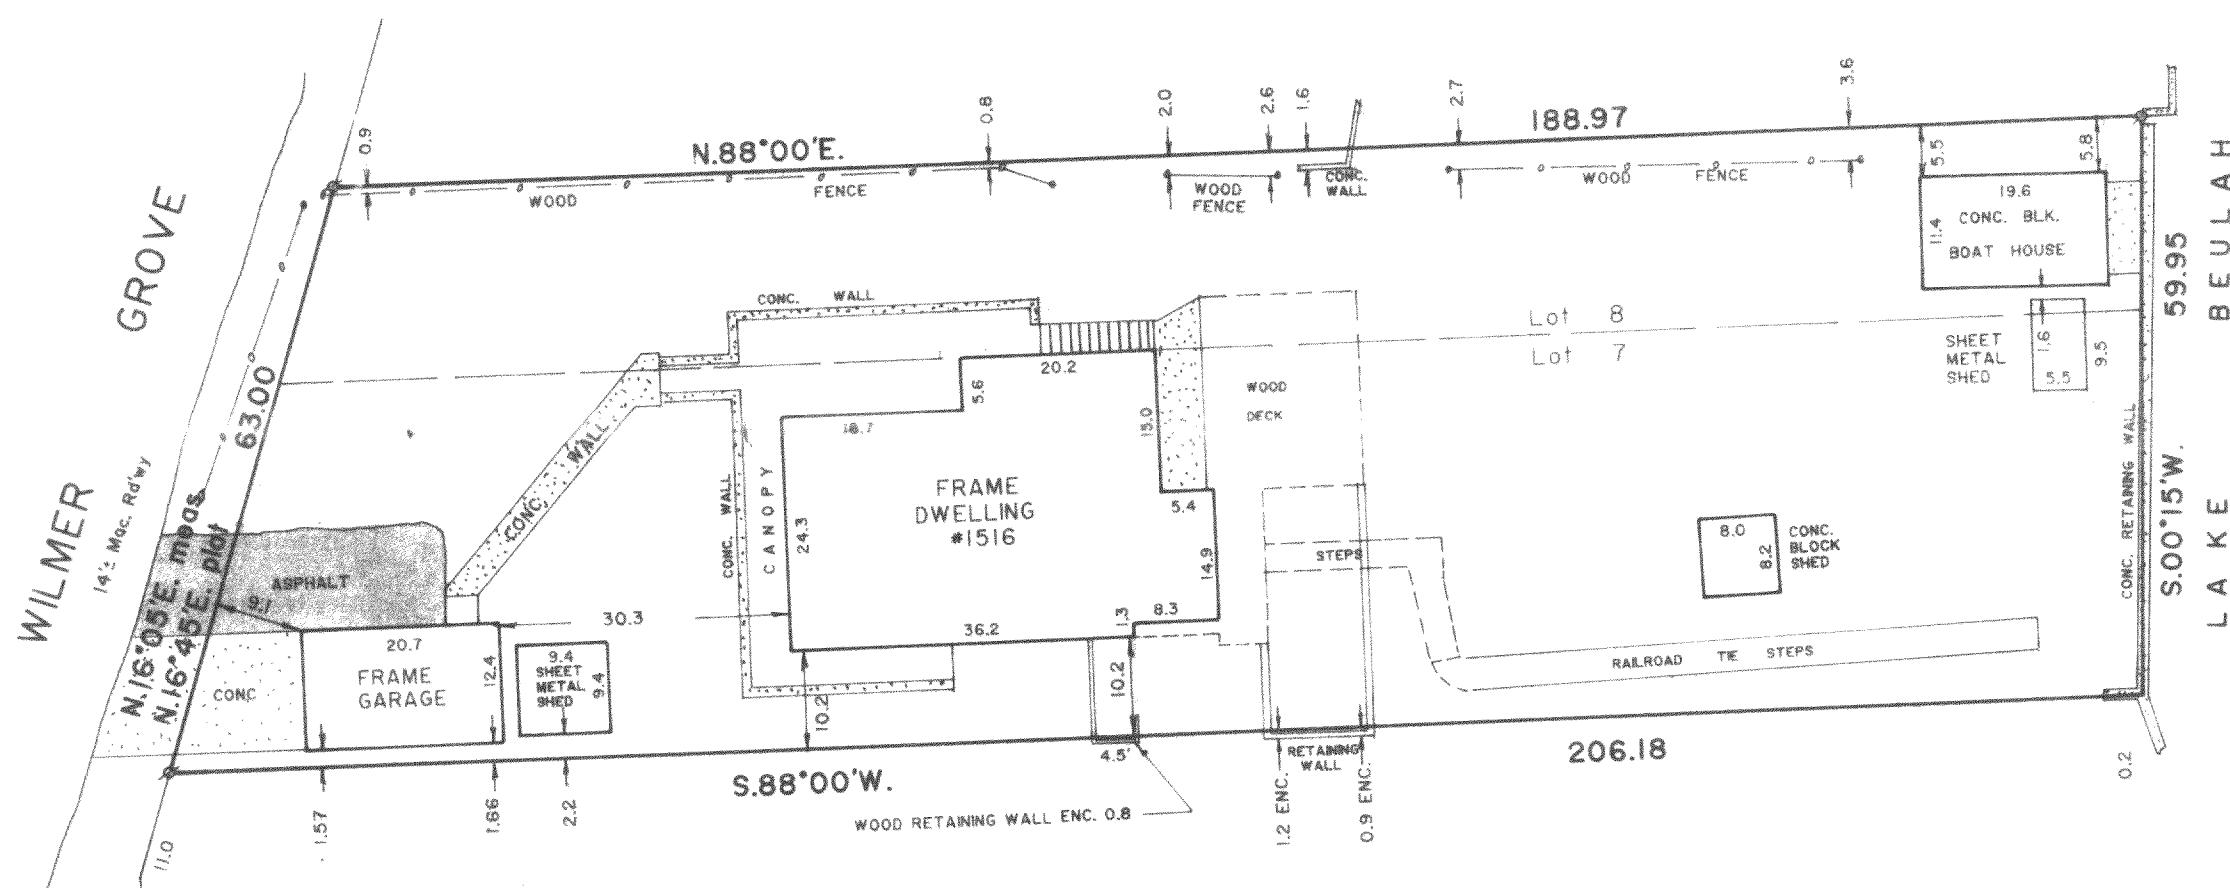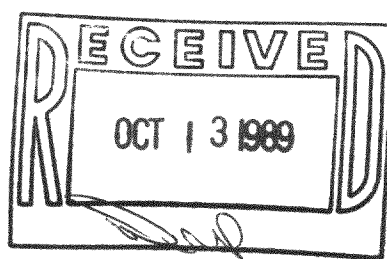

In accordance with Chapter A-E 5.01b
a signed agreement is on file waiving the
setting of monuments on the property.

- - FOUND IRON PIPE
- - SET IRON PIPE

8522 West Lisbon Avenue
Milwaukee, Wisconsin 53222

SURVEYED FOR

Margaretten & Co., Inc.
3077 North Mayfair Rd.
Milwaukee, Wisconsin 53222


LANDMARK SURVEYING CO.

I, Richard J. Lammi, surveyed the above described property, and the above map is a true representation thereof and shows the size and location of the property, its exterior boundaries, the location and dimensions of all visible structures thereon, fences, apparent easements, roadways and visible encroachments.

This survey is made for the exclusive use of the present owners of the property; also those who purchase, mortgage or guarantee the title thereto, within one year from date hereof.

REGISTERED LAND SURVEYOR NO. 5777 - STATE OF WISCONSIN

Scale 1"=20'
PHONE
461-3730

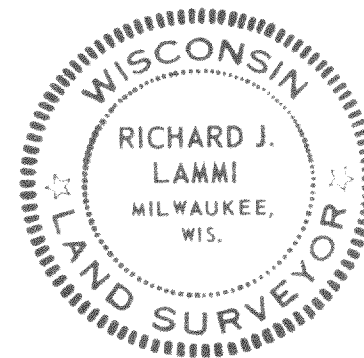

PWW-7