

White Oak Drive

N

40'

350.0'

140.00

77.9'

Lot 8

7

RESIDENCE

50.00

78.0'

140.00

Iron Pipe

320.0'

Maple Street

State of Wisconsin } ss
County of Walworth }

I, Lloyd L. Jensen, do hereby certify that I have surveyed the property described hereon according to the official records, and that the Plat hereon is a correct representation of the lot lines and principal lines of buildings thereon.


JULY 25, 1956

Lloyd L. Jensen
SURVEYOR

Miramar

Drive

PMR-89

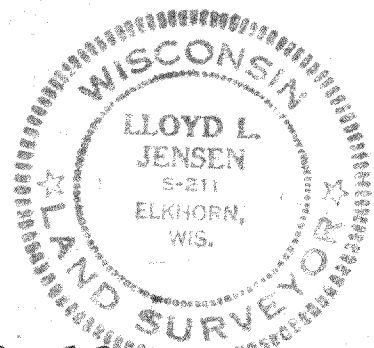

418-685

PLAT OF SURVEY OF

Lot 8 of Block 7 of Miramar
Subdivision, located in Sec. 10, T4N,
R 18E, Walworth County, Wisconsin

Lloyd L. Jensen
SURVEYOR

SCALE 1" = 20'

DATE JULY 1956