


Plat of Survey

of

THE WEST 1/2 OF LOT 2 OF THE WHITE SUBDIVISION LOCATED IN THE W 1/2 OF SECTION 17, T 4 N, R 18 E, WALWORTH COUNTY, WISCONSIN

Surveyed for: WILLIAM MCGUIRE
2848 KINGS LANE
EAST TROY, WI 53120

SW 1/4 LINE OF LOT 2 ASSIGNED THE
BEARING N 54°04' W

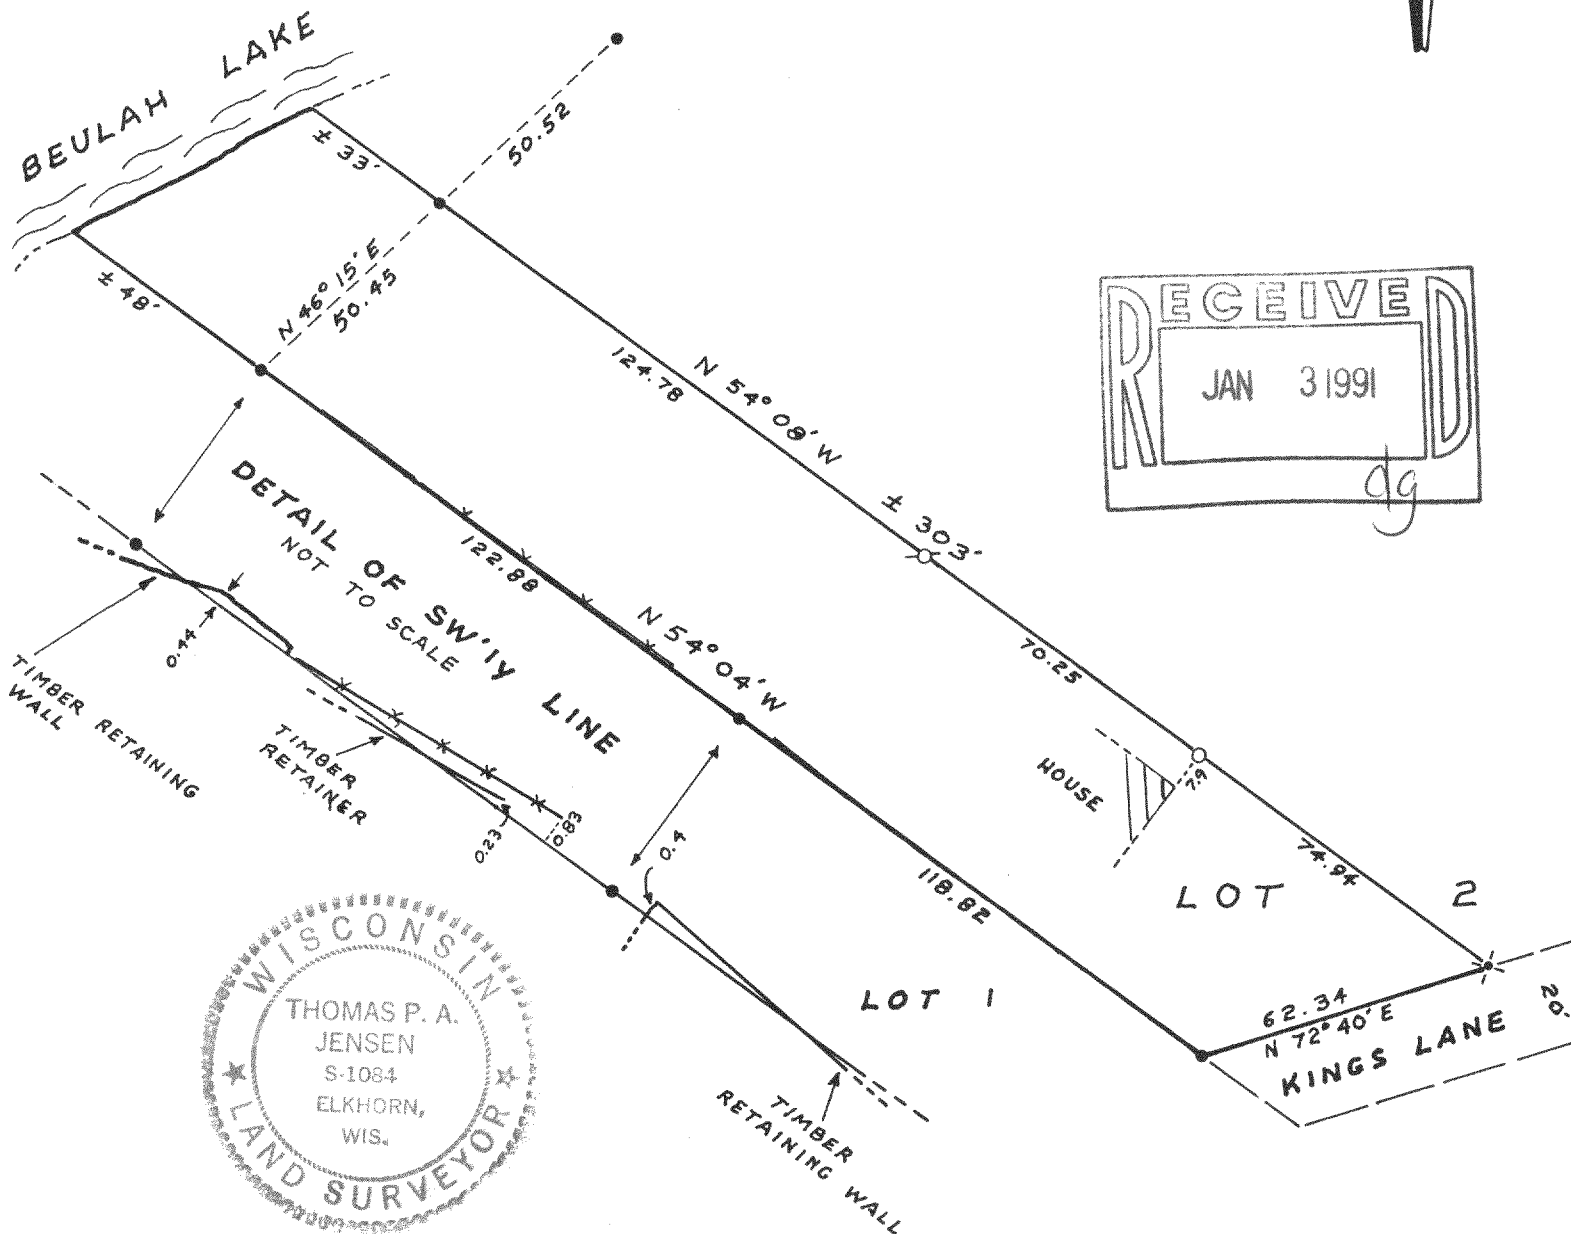

I, Thomas P. A. Jensen, Wisconsin Registered Land Surveyor, hereby certify that this survey was performed by me, or under my direction, in full compliance with the owner's/agent's instructions, and that this map is an accurate representation thereof to the best of my knowledge and belief.

Thomas P. A. Jensen
Thomas P. A. Jensen, R.L.S.-1084
JENSEN SURVEYING & MAPPING, S.C.

Copyright © 1990 by Jensen Surveying & Mapping S.C.

All rights reserved. No part of this survey plat may be reproduced or transmitted in any form by any means - graphic, electronic, or mechanical, including photocopying, tracing, or information storage and retrieval systems - without permission in writing from Thomas P.A. Jensen.

Legend

- Found iron pipe, 1' dia.
- Found iron rod, 3/4' dia.
- ⊗ Set iron pipe, 1' dia.
- ✕ Set P.K. nail
- *** Wood rail fence

Jensen Surveying & Mapping S.C.

45 South Wisconsin Street P.O. Box 322
Elkhorn, Wisconsin, 53121.
(414) 723-3434

Mapping date: APRIL 30, 1990

Revisions: _____

Sheet 1 of 1 Sheets

Job reference number:

1989.150

PWH 000013

Scale: 1" = 40'



418-723