


Rt. 3, Box 273
Elkhorn, Wisconsin 53121
Phone: (414) 723-4260 (office)
(414) 723-4813 (residence)

LEGAL DESCRIPTION

Lots 21, 22, 23, & 24 of Block 13, Miramar Subdivision,
Located in the Northeast 1/4 of Section 10, Town 4 North,
Range 18 East, Town of East Troy, County of Walworth, State
of Wisconsin.

NOTE
This survey retraces previous surveys in
this Block as listed.
Lots 1, 2, & 3 by James F. Biagi, R.L.S.#
272, Dated June 30, 1972.
Lots 5 & 6 by Lloyd L. Jensen, R.L.S.# 211,
Dated January 9, 1969.
Lots 19 & 20 by Lloyd L. Jensen, Dated
August, 1942.

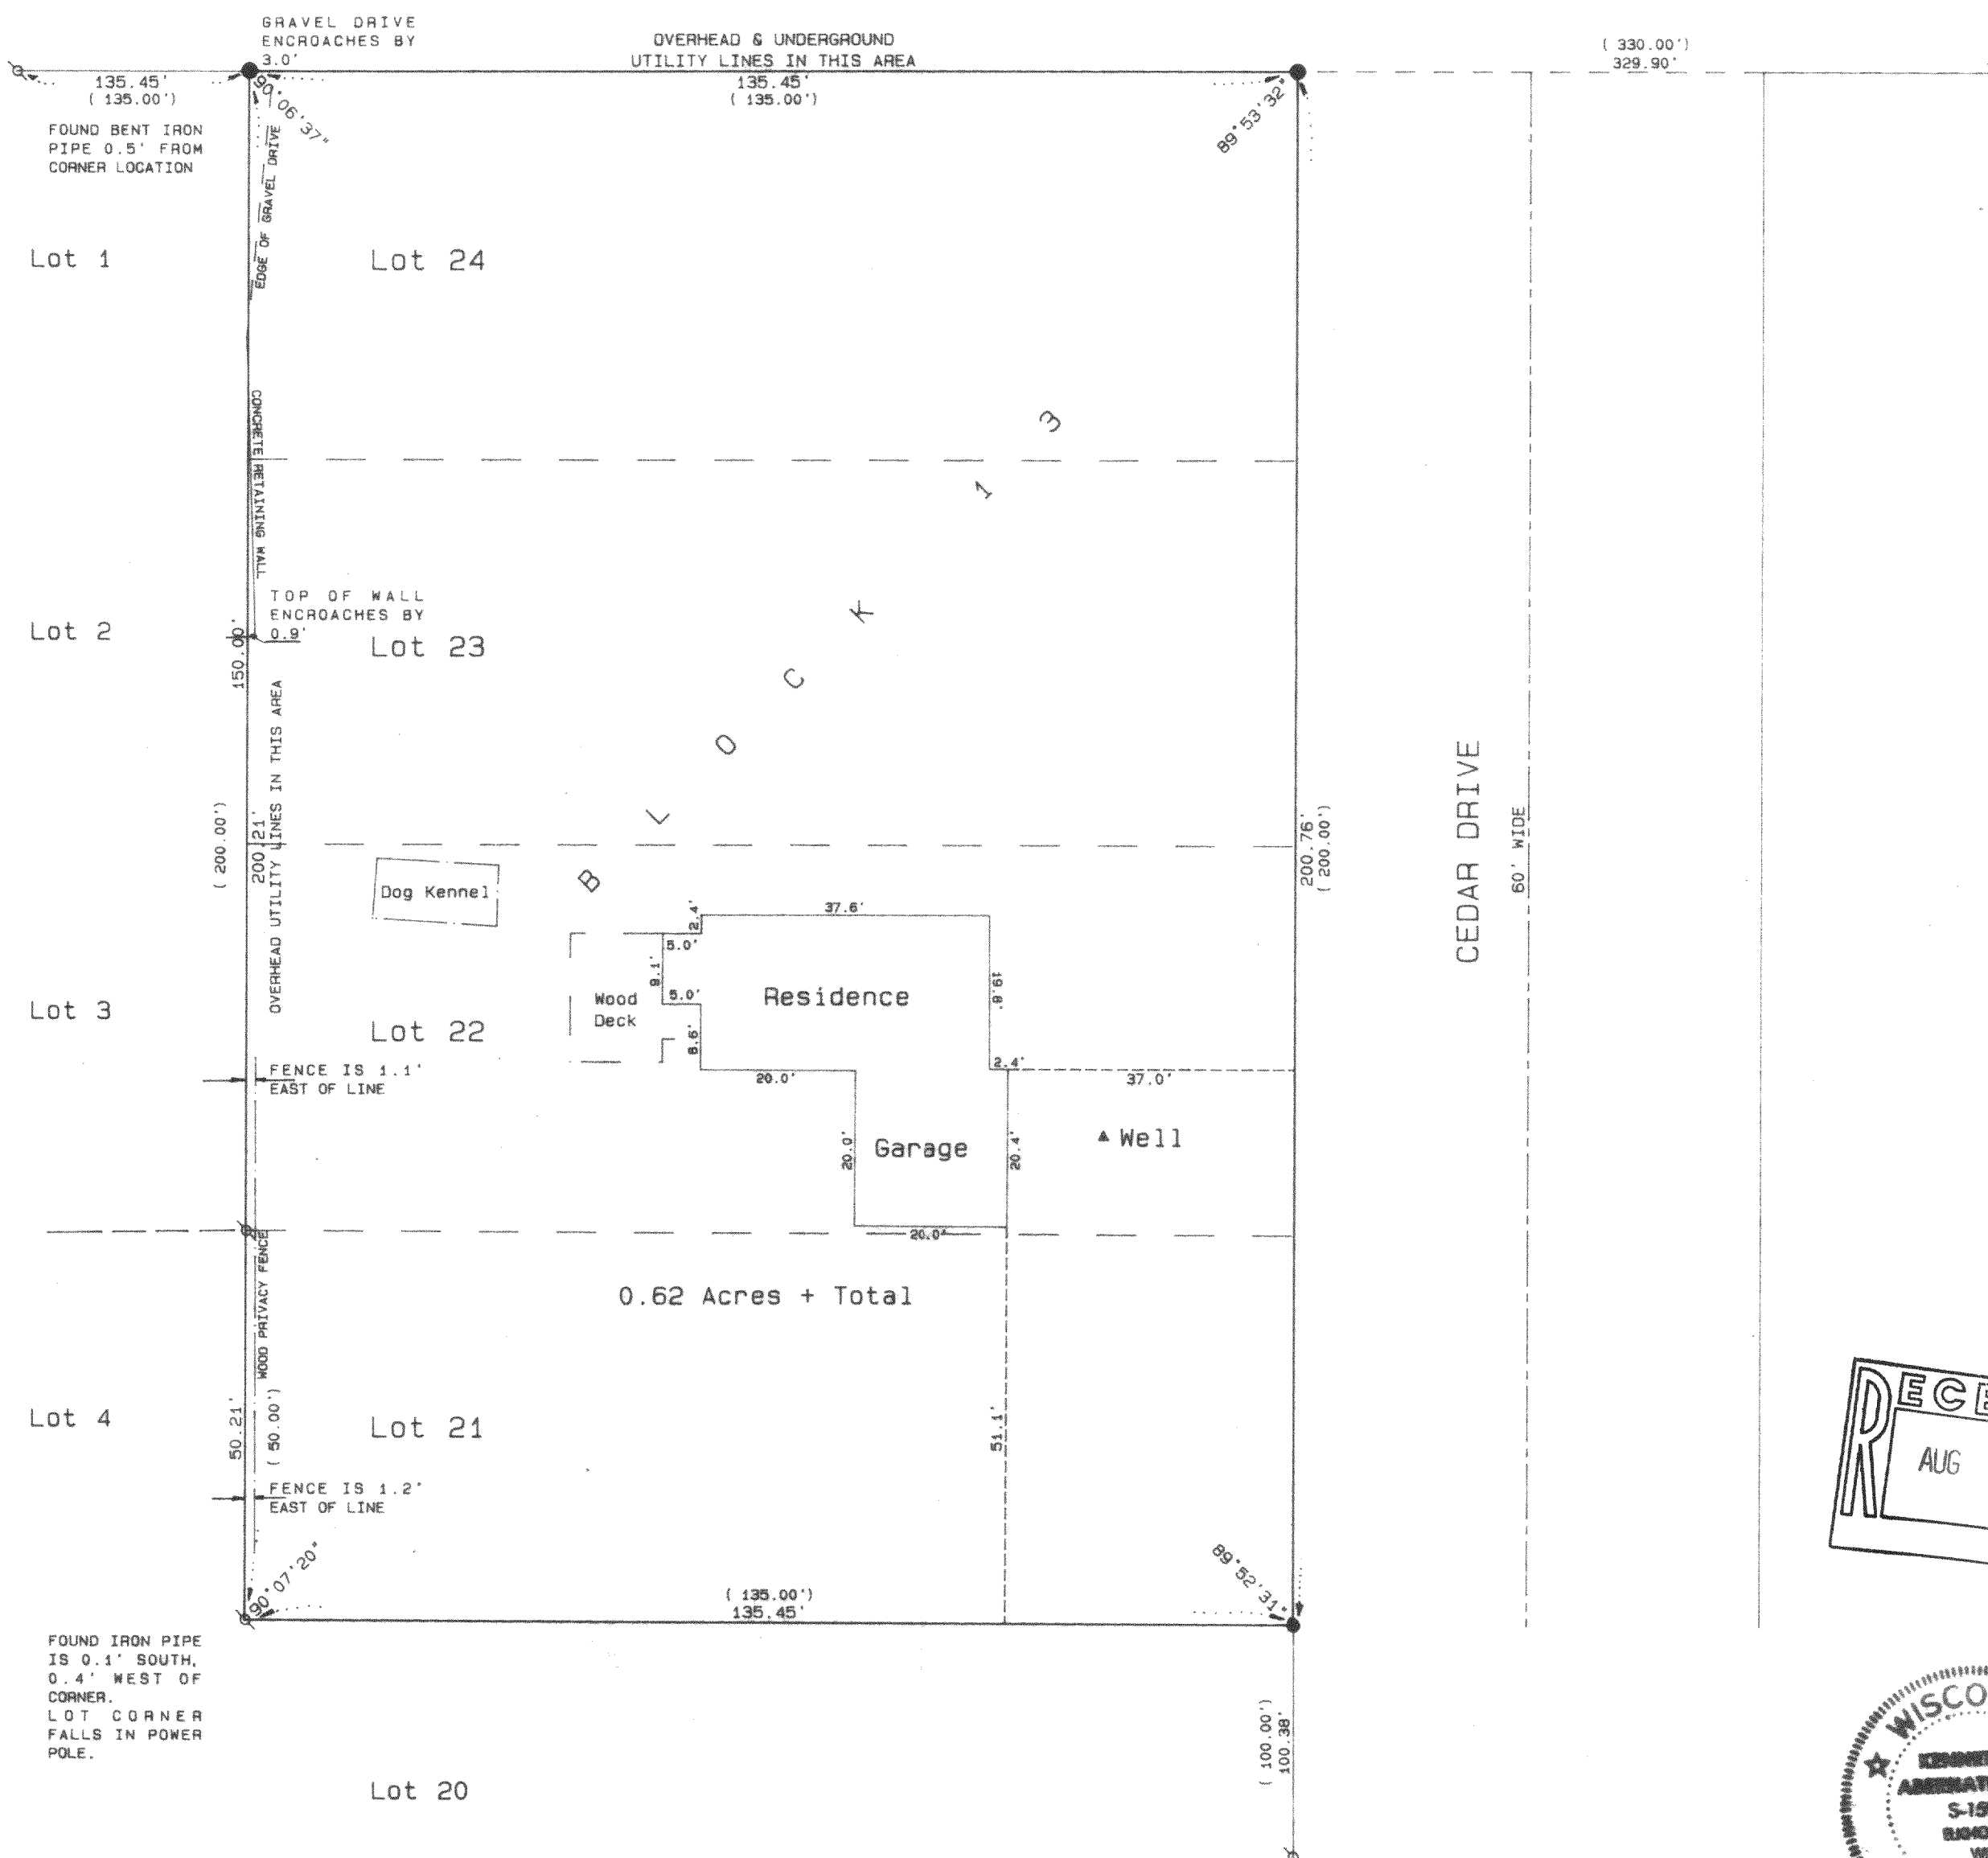

* FOUND IRON PIPE
 * FOUND IRON ROD
 * FOUND BRASS CAPPED MONUMENT
 * FOUND CONCRETE MONUMENT
 + CHISEL CUT IN CONCRETE
 ● SET IRON ROD, 24" LONG, WEIGHING
 1.5 LBS./LINEAL FT., 3/4" DIA.
 ● SET IRON PIPE, 24" LONG, WEIGHING
 1.13 LBS./LINEAL FT., 1" DIA.
 (xx) RECORDED AS DIMENSION
 —x—x— EXISTING FENCE



SCALE: 1" = 20 FEET



"I hereby certify that I have surveyed the above described property and that the above map is a true representation thereof and shows the size and location of the property, its exterior boundaries, the location of all visible structures and dimensions of all principal buildings thereon, boundary fences, apparent easements, roadways and visible encroachments, if any."

"This survey is made for the use of the present owners of the property, and also those who purchase, mortgage, or guarantee the title thereto within one year from date hereof."

Kenneth B. Abernathy, Jr.
KENNETH B. ABERNATHY, JR.
WISCONSIN REGISTERED LAND SURVEYOR,
S-1594

Date: July 17, 1991 Job No. 1991.417