
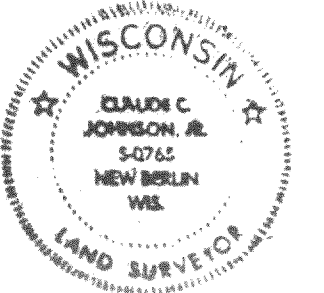
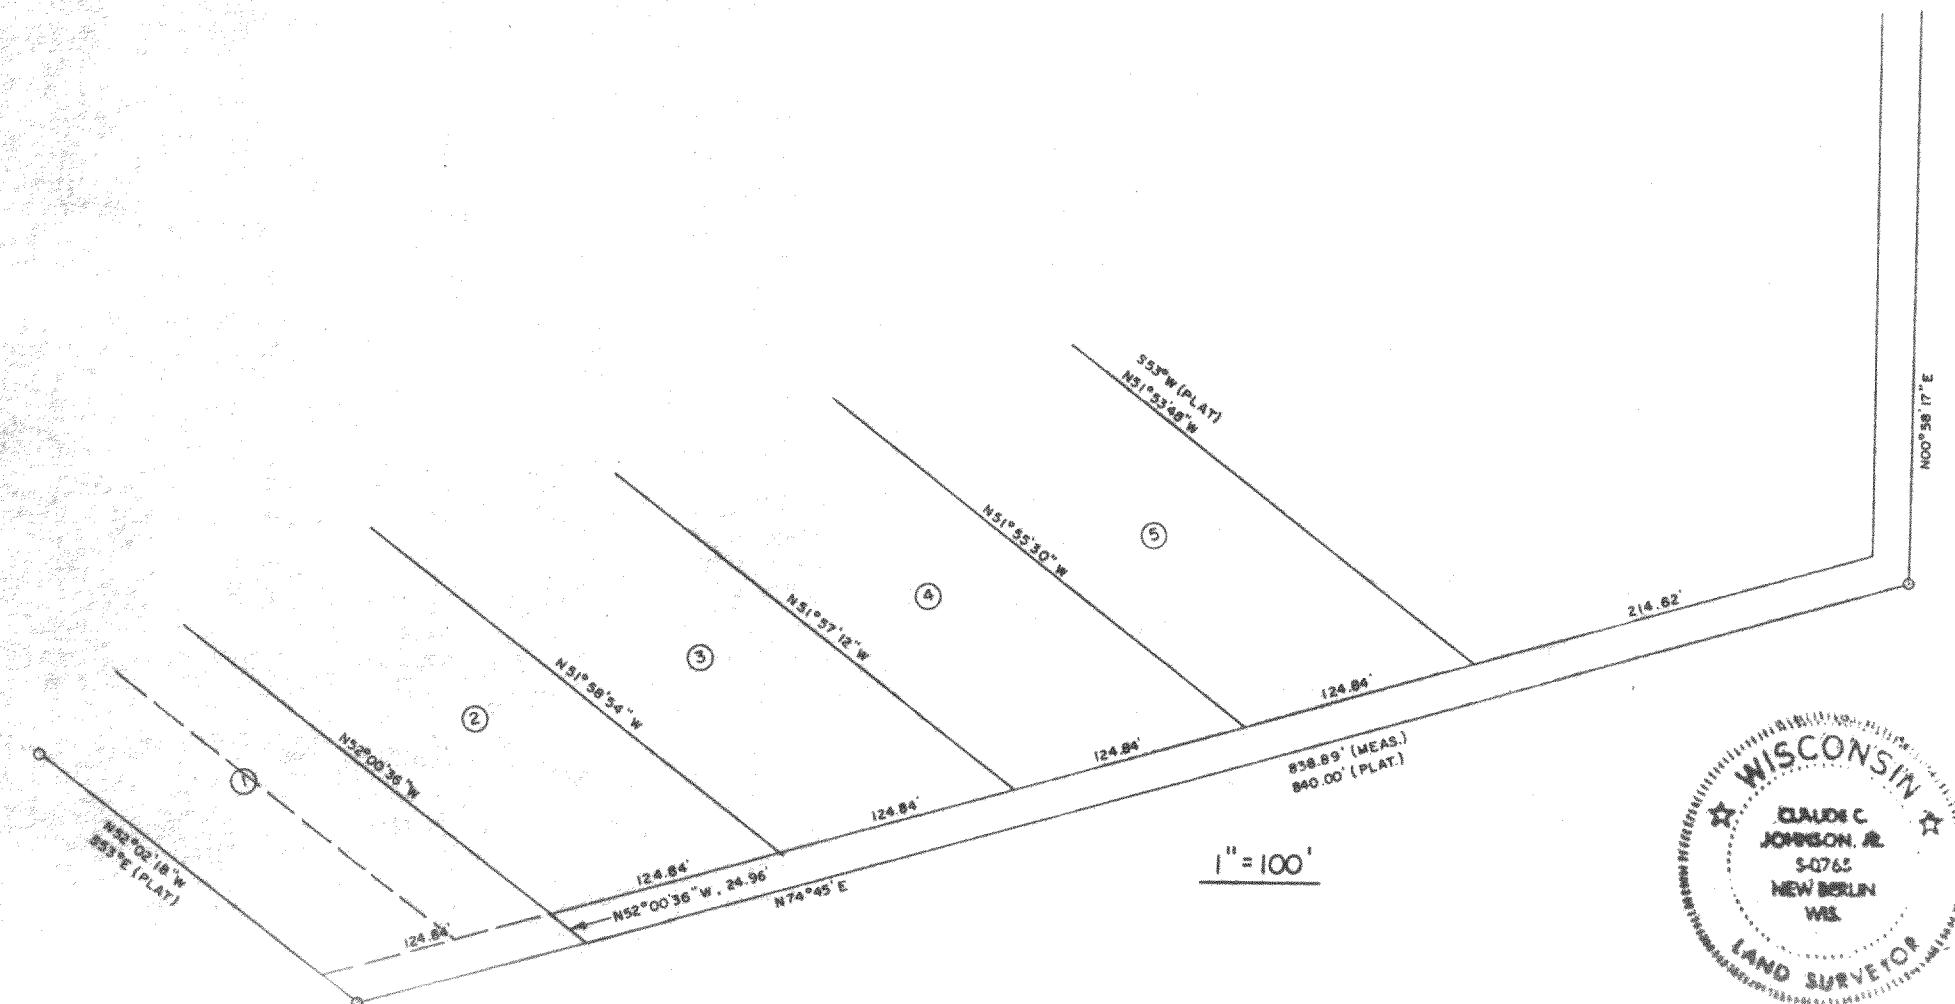


The East 42 feet of lot numbered(1) one of White Subdivision Lake Beulah, being a part of the Northwest Fractional Quarter of Section 17, in Township Four (4) North, of Range Eighteen (18) East, in the Township of East Troy, County of Walworth, State of Wisconsin.

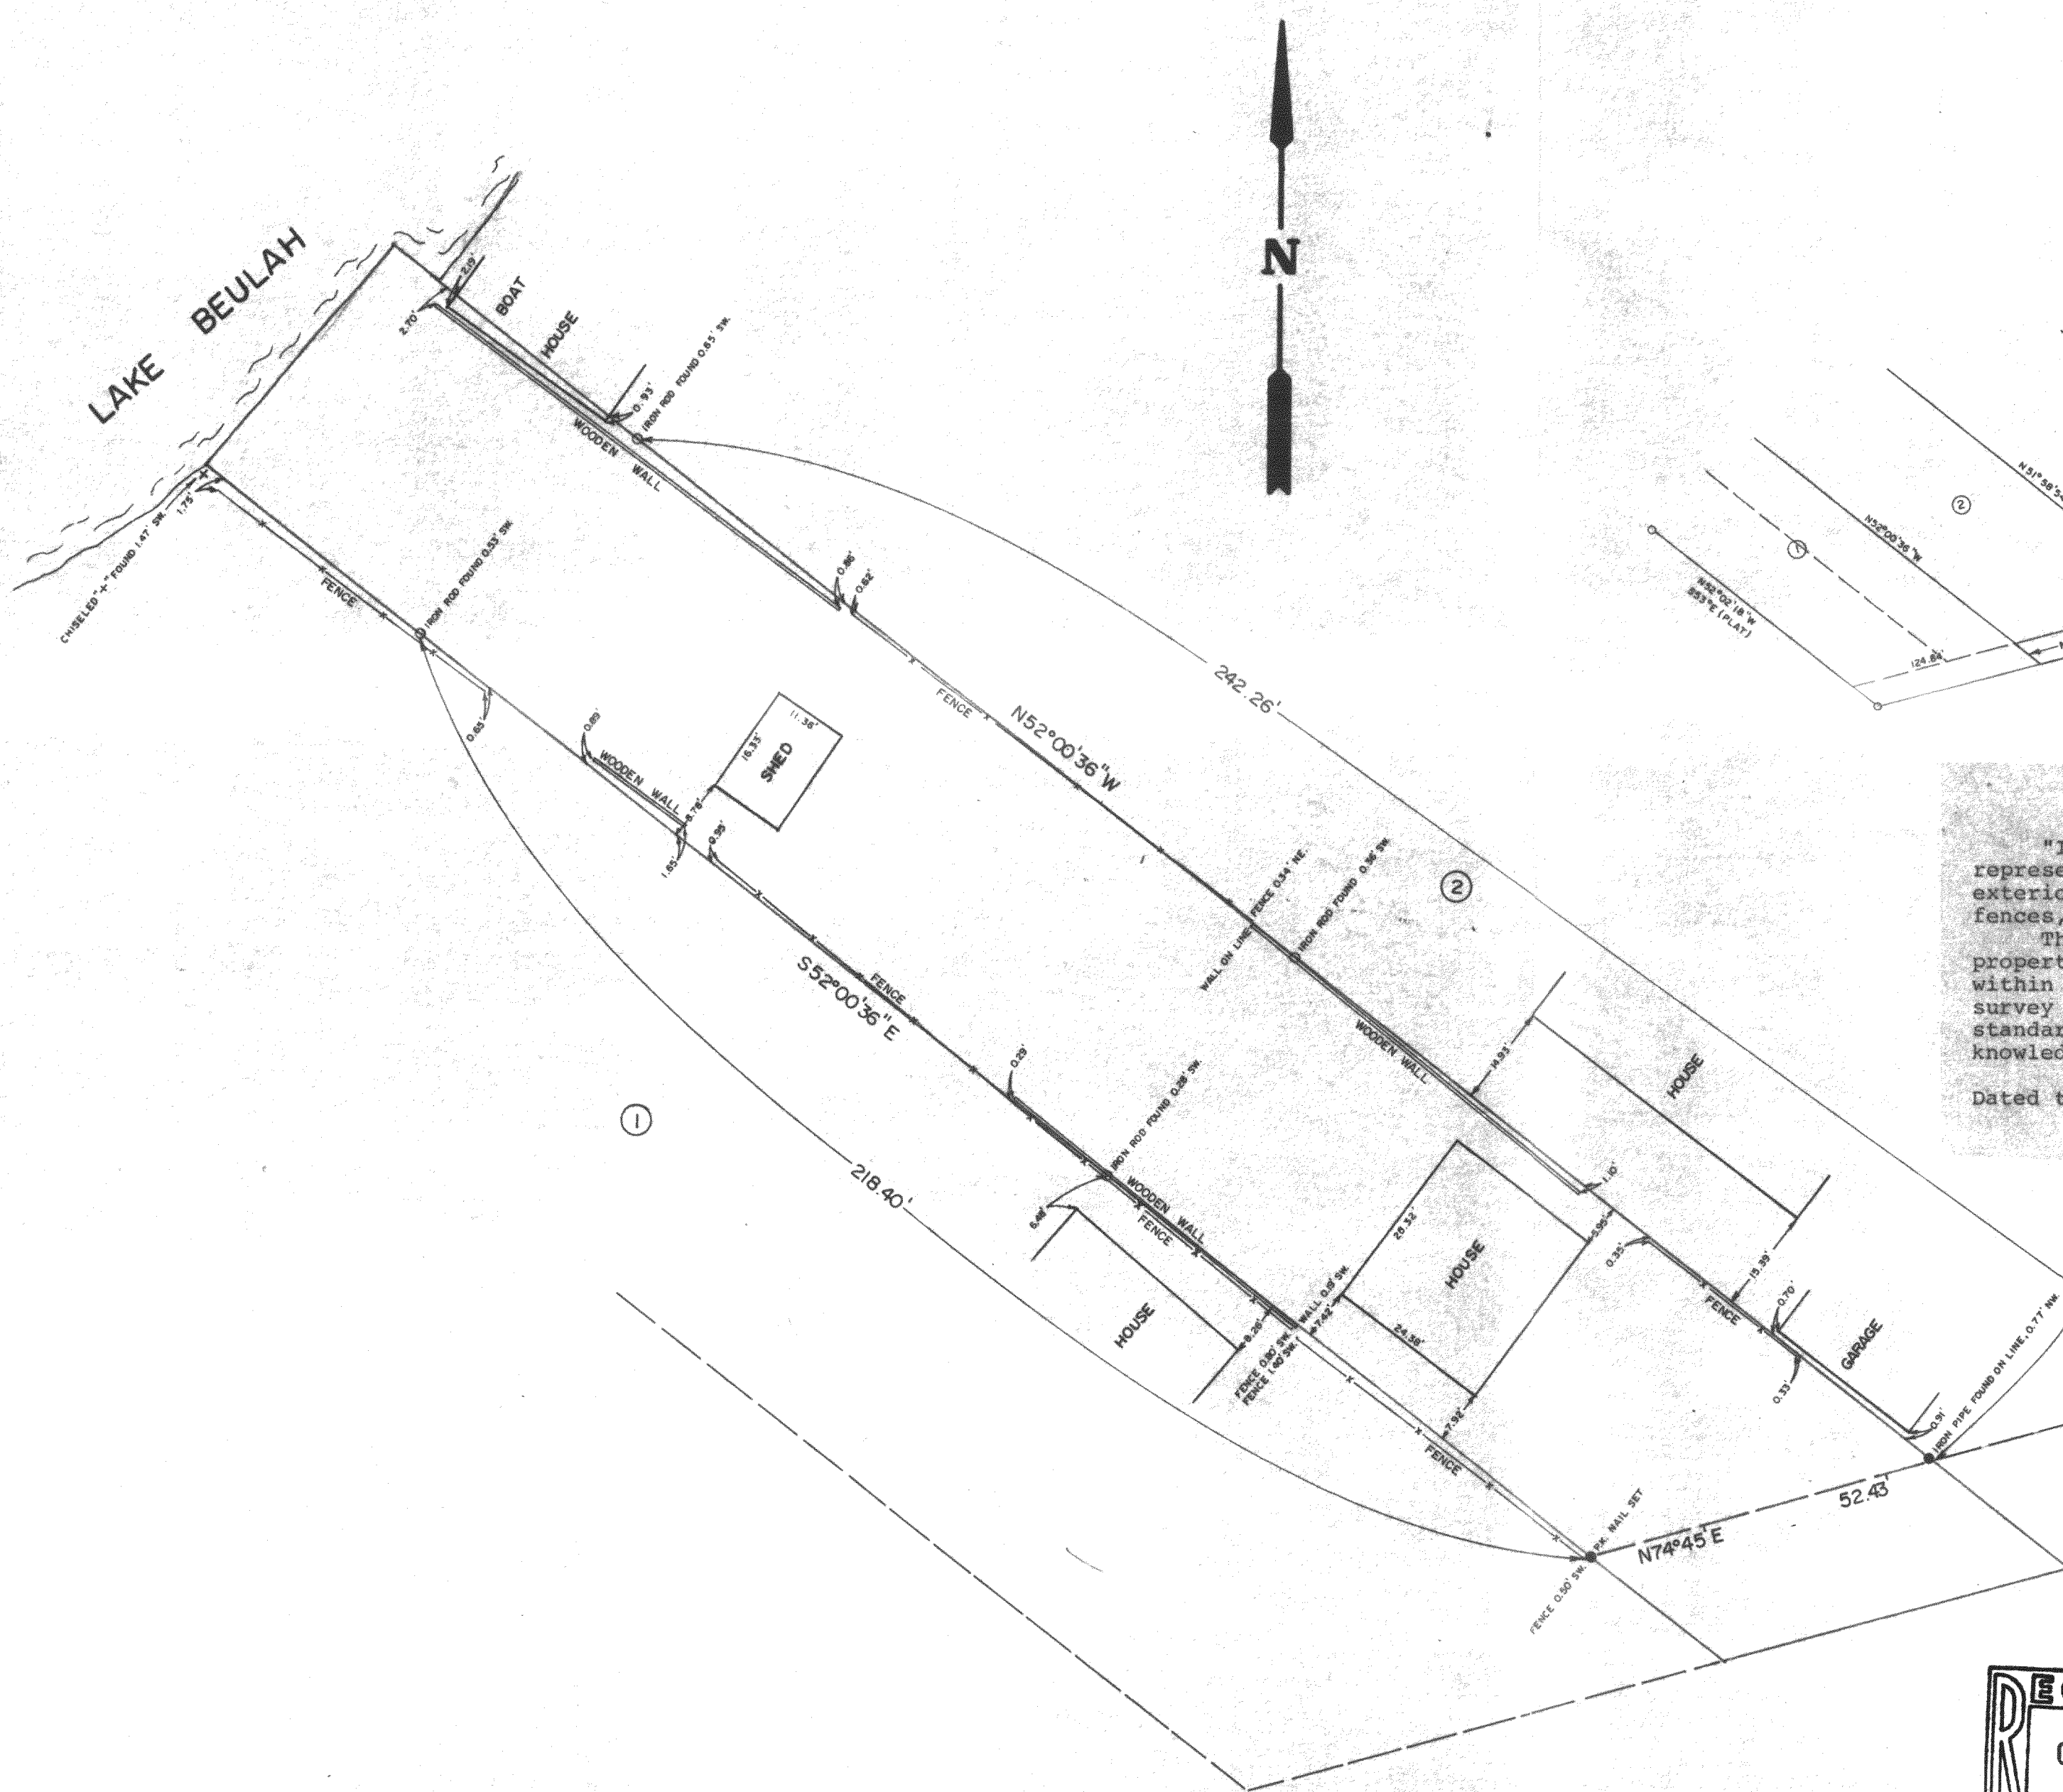

CERTIFICATION

"I have surveyed the above described property and the above map is a true representation thereof, and shows the size and location of the property, its exterior boundaries, the location and dimensions of all structures thereon, fences, apparent easements and roadways and visible encroachments, if any. This survey is made for the exclusive use of the present owners of the property, and also those who purchase, mortgage or guarantee the title thereto, within one (1) year from date hereof; and as to them I hereby certify that said survey and the above map were made in accordance with acceptable professional standards and that the information contained thereon is, to the best of my knowledge, information and belief a true and accurate representation thereof".

Dated this 9th day of October, 1990. *Claude C. Johnson*
Registered Land Surveyor

PLAT OF SURVEY			
FOR			
JERRY MCCLAIN			
PART OF SW. 1/4 OF SECTION <u>17</u> T <u>4</u> N, R <u>18</u> E,			
TOWN OF <u>EAST TROY</u> WALWORTH CO., WIS.			
SUBURBAN SURVEYS, INC.			
PLANNERS • ENGINEERS • COMPUTERS • SURVEYORS			
NEW BERLIN, WISCONSIN			
414 - 784-7971		17620 W. NATIONAL AVE.	
SCALE -	DRAFTED BY -	DATE -	PROJECT NO -
1" = 20'	TIMOTHY C. JOHNSON	SEPT. 1990	90-193

