


Plat of Survey

of

A parcel of land located in Beulah Lake Park Subdivision, which Subdivision is located in Section 4, T 4 N R 18 E of Walworth County, Wisconsin, described as follows, to-wit: Beginning at the Southeast corner of lot 4 of said Subdivision; thence South 89° 15' West along the South line of said Lot 4, 288.90 feet to the shore of Beulah Lake; thence Northeasterly along the shore 81 feet; thence South 87° 26' East 211.96 feet; thence North 0° 34' West 19.45 feet; thence North 89° 20' East 40.00 feet to the East line of Lot 3 of said Subdivision; thence South 0° 34' East along the East line of said Lots 3 and 4, 80.34 feet to the place of beginning.

Surveyed for: Mrs. Margaret Miner
803 Beulah Park Road
East Troy, WI 53120

Bearings
referenced
to previous
surveys of
record

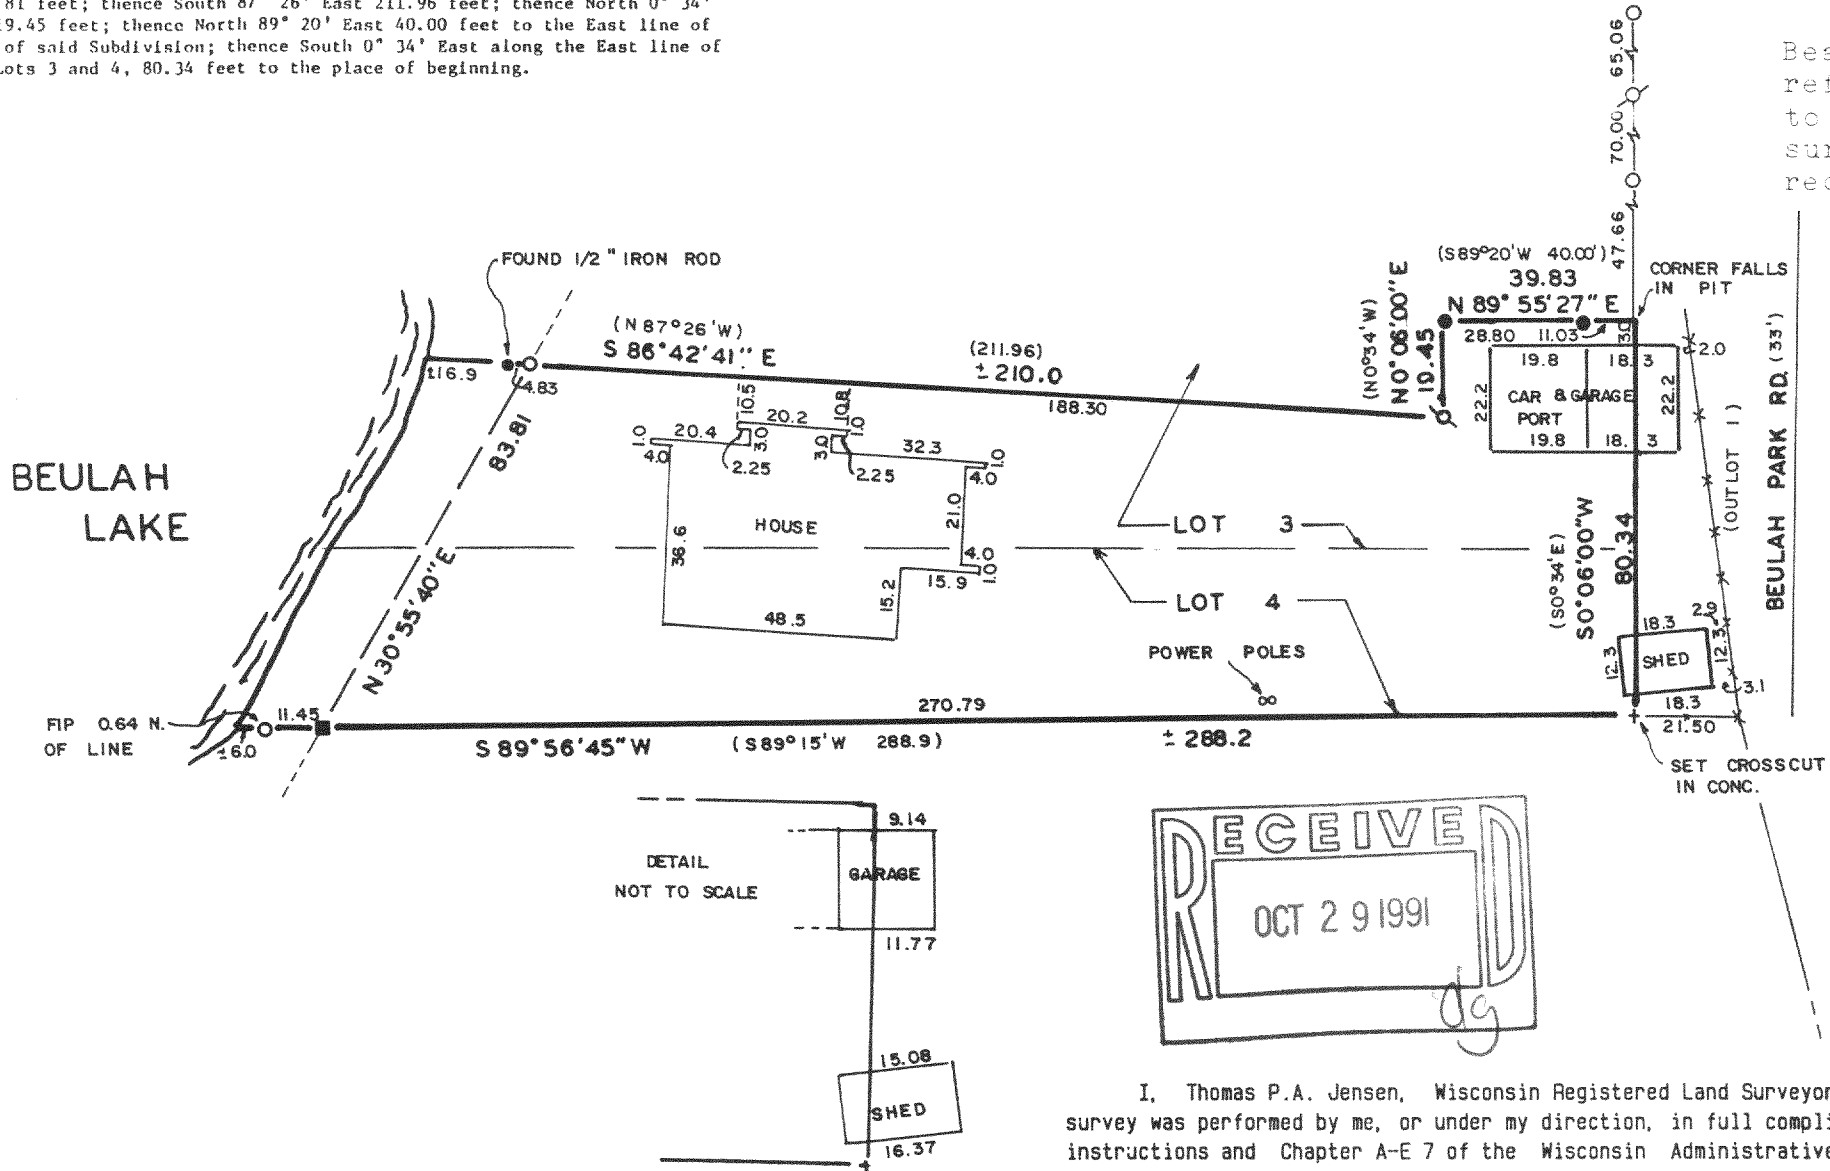

Copyright © 1991 by Jensen Surveying & Mapping S.C.

All rights reserved. No part of this survey plat may be reproduced or transmitted in any form by any means - graphic, electronic, or mechanical, including photocopying, tracing, or information storage and retrieval systems - without permission in writing from Thomas P.A. Jensen.

I, Thomas P.A. Jensen, Wisconsin Registered Land Surveyor, do hereby certify that this survey was performed by me, or under my direction, in full compliance with the owner's/agent's instructions and Chapter A-E 7 of the Wisconsin Administrative Code 'Minimum Standards For Property Surveys', and that this map is an accurate representation thereof to the best of my knowledge and belief.

Note: This survey plat is not certified unless signed and sealed in red ink.

Thomas P.A. Jensen R.L.S. 1084

Jensen Surveying & Mapping S.C.

Mapping date: 8/22/91.

45 South Wisconsin Street P.O. Box 322
Elkhorn, Wisconsin, 53121.

Revisions:

(414) 723-3434

Sheet 1 of 1 Sheets

Job reference number:

1991.138

Scale: 1" = 40'



418-779

Legend

- Found concrete monument
- Found iron pipe
- Found iron rod
- Set iron rod 3/4 dia.
- Recorded as dimension
- CYCLONE FENCE