


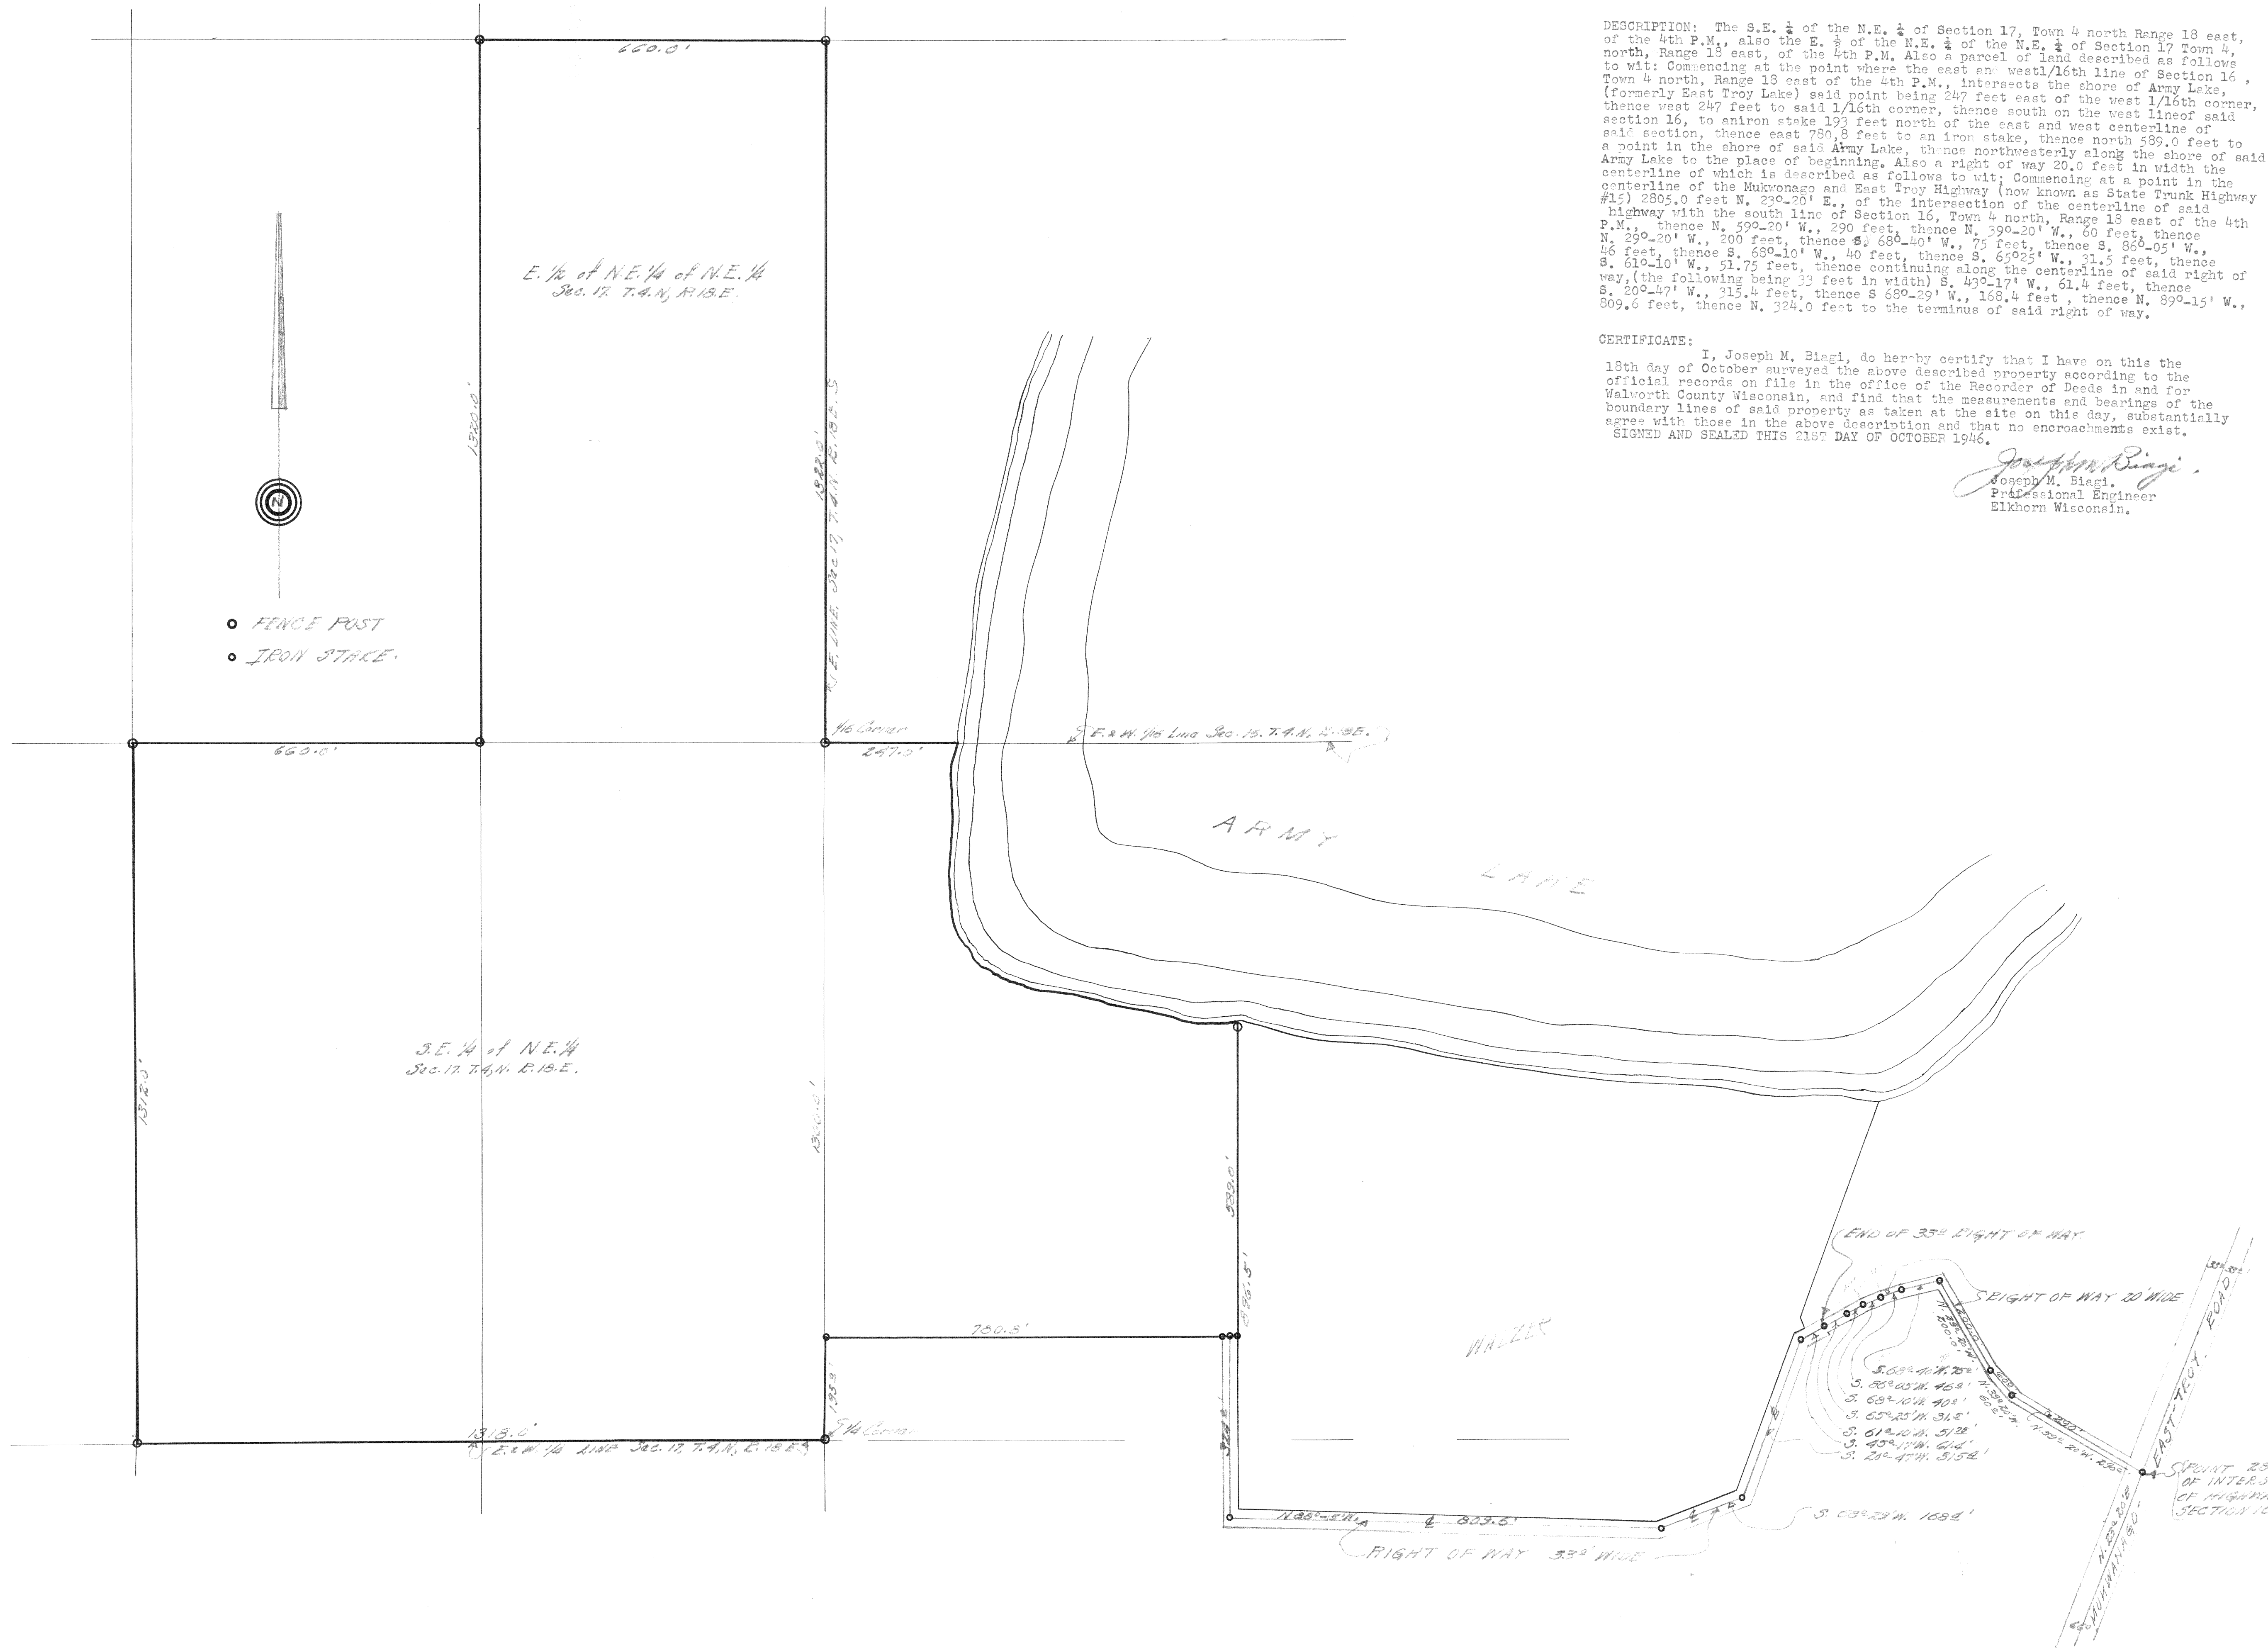

P0-12
P0-10
P0-11
ET-17-1