


N

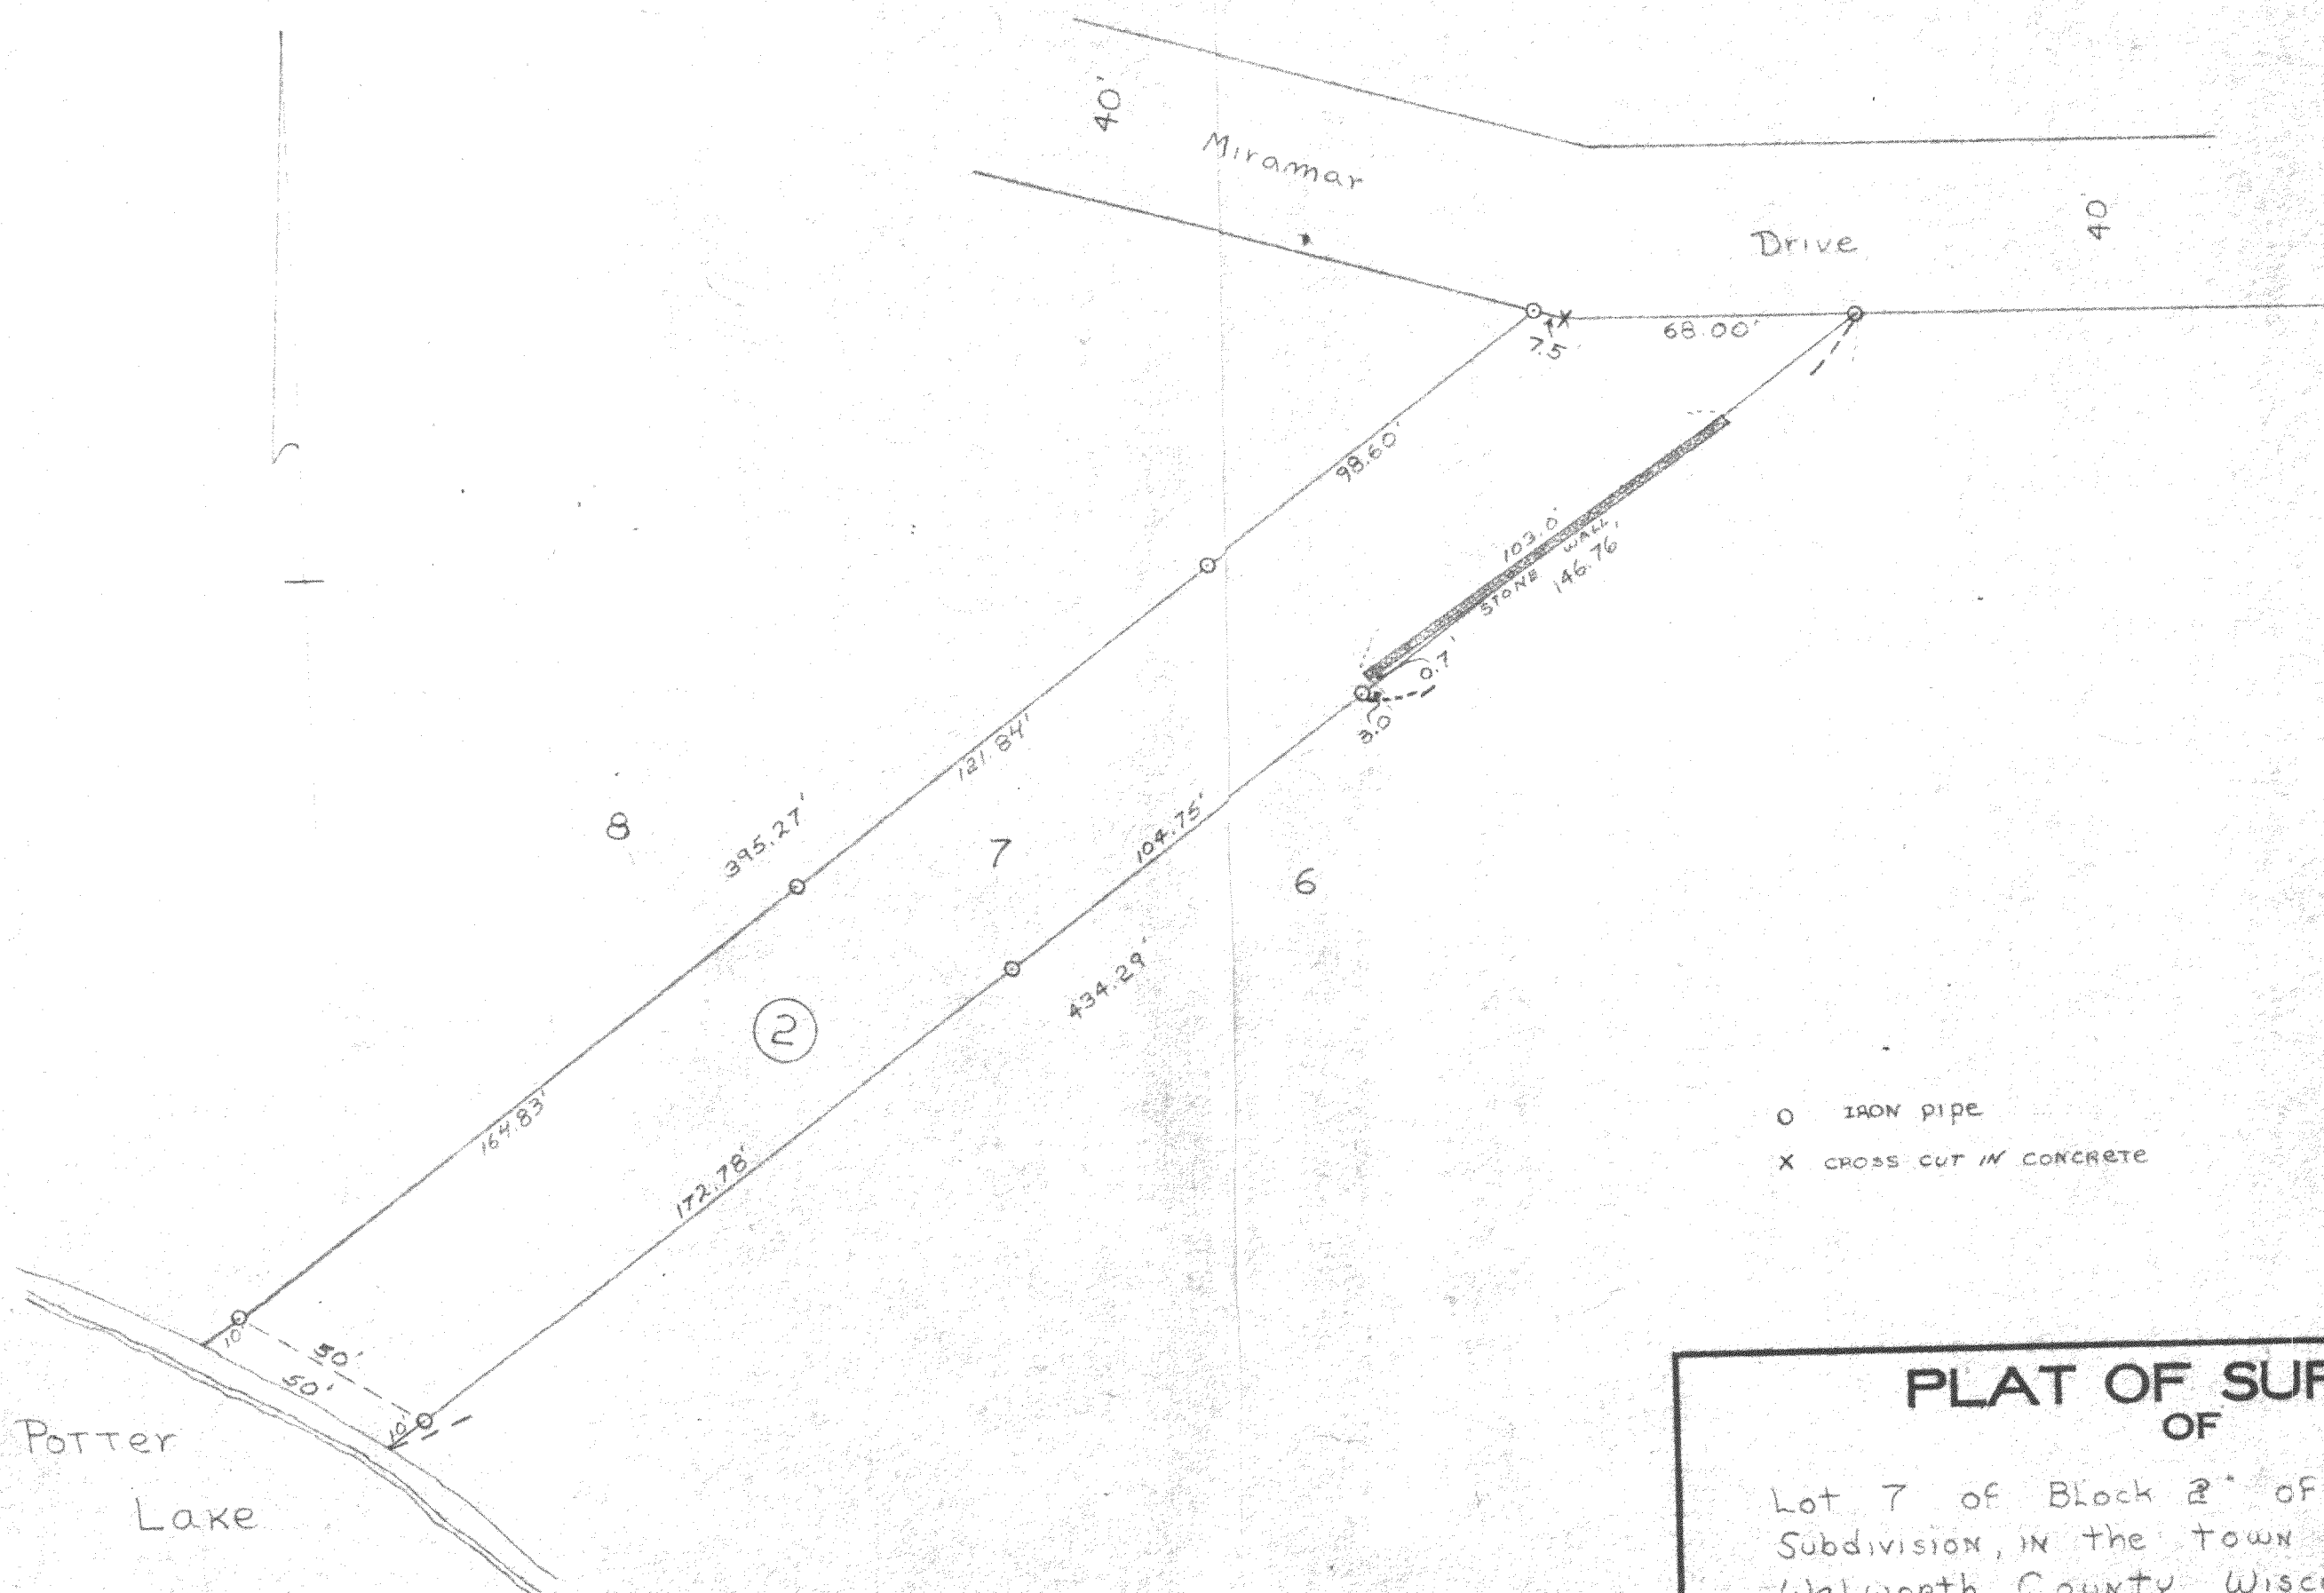

O IRON PIPE
X CROSS CUT IN CONCRETE

PLAT OF SURVEY OF

Lot 7 of Block 2 of Miramar
Subdivision, in the town of East Troy,
Wauworth County, Wisconsin

Lloyd L. Jensen
SURVEYOR

SCALE 1" = 40'

DATE Nov. 1957