

PLAT OF SURVEY

LOT 2 OF KING'S PARK SUBDIVISION,
ACCORDING TO THE OFFICIAL PLAT THEREOF AS
RECORDED IN VOL. 9 OF WALNORTH COUNTY
PLATS ON PAGE 43 AS DOCUMENT NO. 252349
LOCATED IN SECTION 17, TOWN 4 NORTH,
RANGE 18 EAST, TOWN OF EAST TROY,
WALNORTH COUNTY, WISCONSIN.



NOTE:
SUBDIVISION PLAT LOCATED IN CABINET 2 ON SLIDE 20

ORDERED BY: B.J. SULLIVAN AND ASSOCIATES
79 WEST MONROE SUITE 905
CHICAGO, IL. 60603-4907


CURRENT OWNER: EDWARD L. KALEITA
P.O. BOX 823
EAST TROY, WI. 53120

ADDRESS OF PROPERTY: 1503 KINGS PARKWAY
EAST TROY, WIS. 53120

TAX KEY NO. PKP 00001A

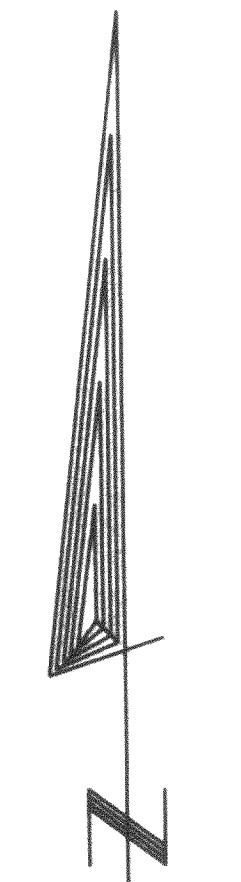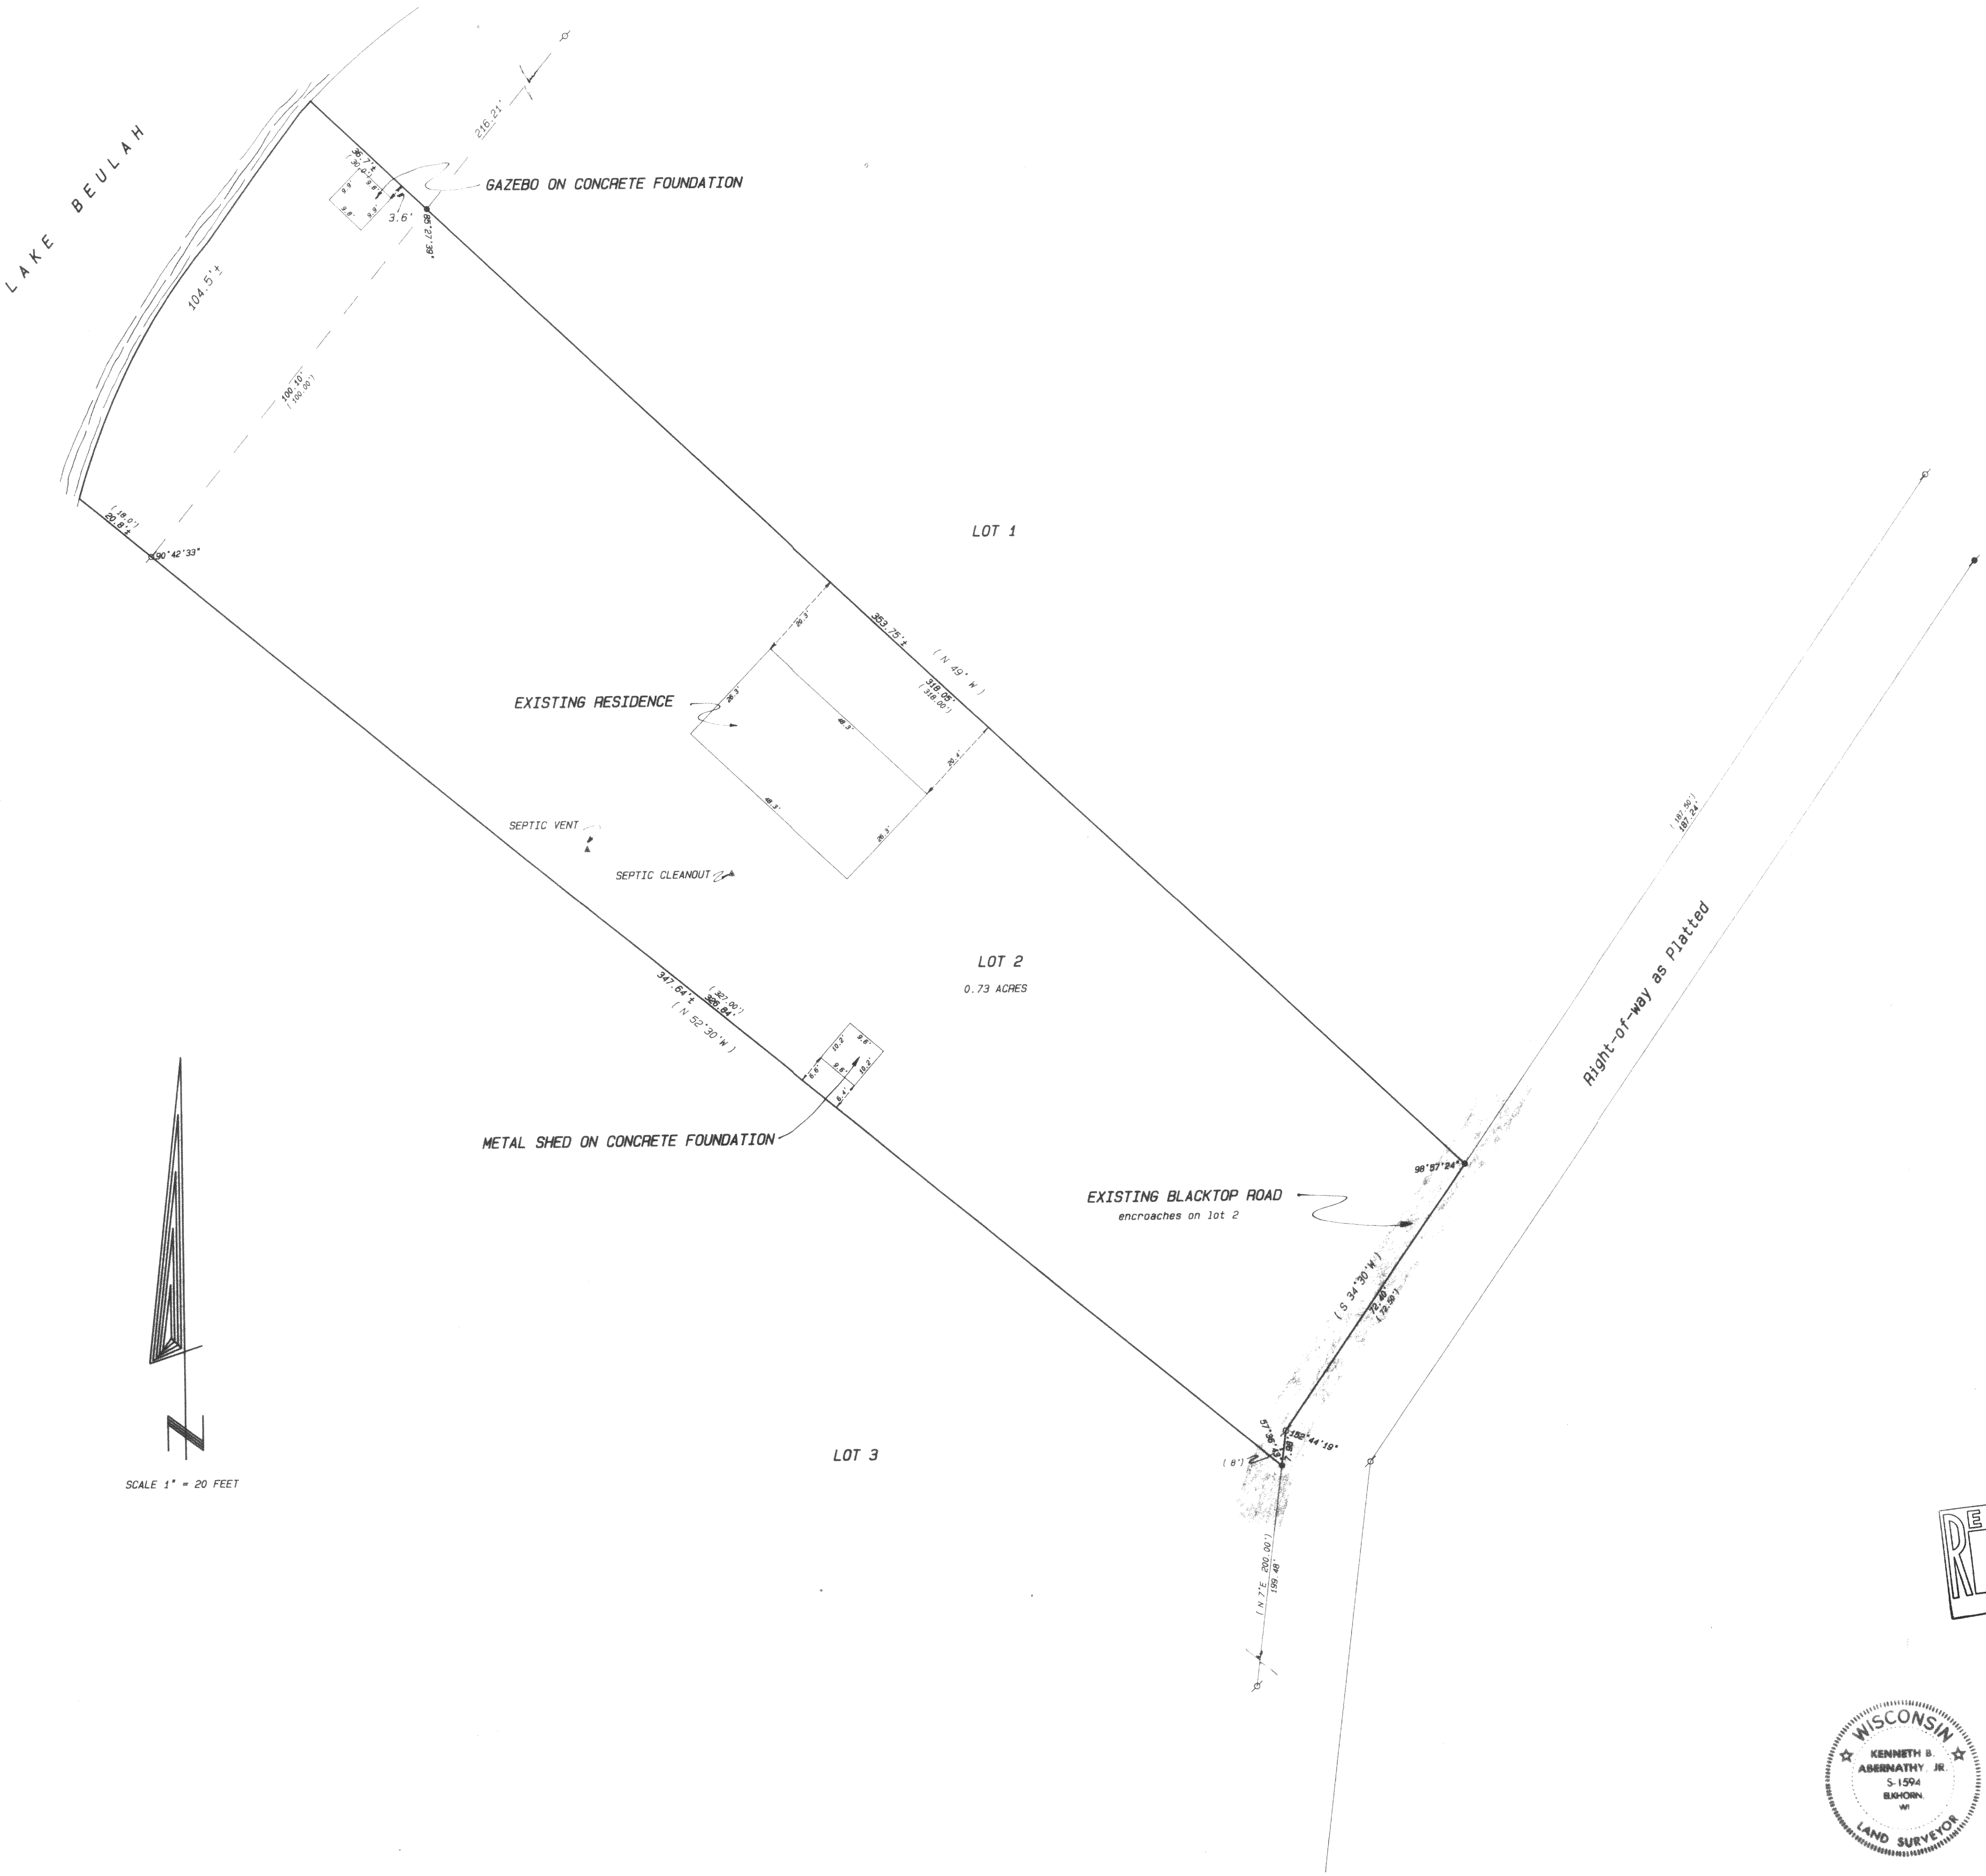

- Legend
- FOUND IRON PIPE
 - FOUND IRON ROD
 - FOUND BRASS CAPPED MONUMENT
 - FOUND CONCRETE MONUMENT
 - CHISEL CUT IN CONCRETE
 - SET IRON ROD, 24" LONG, WEIGHING 1.5 LBS./LINEAL FT., 3/8" DIA.
 - SET IRON ROD, 30" LONG, WEIGHING 4.5 LBS./LINEAL FT., 1-11/16" DIA.
 - RECORDED AS DIMENSION
 - EXISTING FENCE

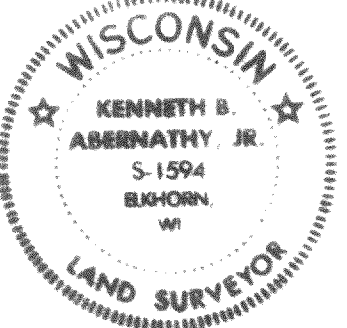

I hereby certify that I have surveyed the above described property and that the above map is a true representation thereof and shows the size and location of the property, its exterior boundaries, the location of all visible structures and dimensions of all principal buildings thereon, boundary fences, apparent easements, roadways and visible encroachments, if any.

"This survey is made for the use of the present owners of the property, and also those who purchase, mortgage, or guarantee the title thereto within one year from date thereof."

Kenneth B. Abernathy Jr.
KENNETH B. ABERNATHY, JR.
WISCONSIN REGISTERED LAND SURVEYOR,
S-1594

Date: DECEMBER 6, 1991 Job No. 91-1113